

FOR REFERENCE ONLY

CARDUCCI & ASSOCIATES, INC.
 LANDSCAPE ARCHITECTURE PLANNING
 IRRIGATION DESIGN URBAN DESIGN
 555 BEACH STREET, 4TH FLOOR
 SAN FRANCISCO, CALIFORNIA 94133
 PHONE (415) 674-0990 FAX (415) 674-0999
 © 2015 CARDUCCI & ASSOCIATES, INC.



seal

consultant

CITY OF SAUSALITO

owner

ROBIN SWEENEY PARK

APN 064-165-012

420 LITHO STREET
SAUSALITO, CA, 94965

project

- 1. PLANNING SUBMITTAL 02.01.2013
- 2. PLANNING SUBMITTAL 10.15.2013
- 3. PLANNING SUBMITTAL 07.29.2015
- 4. PERMIT SUBMITTAL 10.02.2015

no. description

key map

date 10.02.2015

scale AS SHOWN


project no. COS10-01

**GRADING AND
 DRAINAGE
 RECORD DRAWING**
 sheet title

L0.06

sheet no.

Only the original, signed hard copy of this drawing constitutes Carducci & Associates professional work product. Carducci & Associates will not be responsible for any modifications made to this drawing electronic or otherwise that is not signed by Carducci & Associates. If the contractor encounters errors or discrepancies on the drawings or site conditions which prevent or delay the completion of work as indicated, the contractor shall notify the owner and landscape architect by the time of bid of all such errors, discrepancies and omissions. The contractor shall indemnify and hold the landscape architect and the owner harmless if either contracting for the work he has monetary damage because of site conditions, errors, discrepancies or omissions at the time of bid.

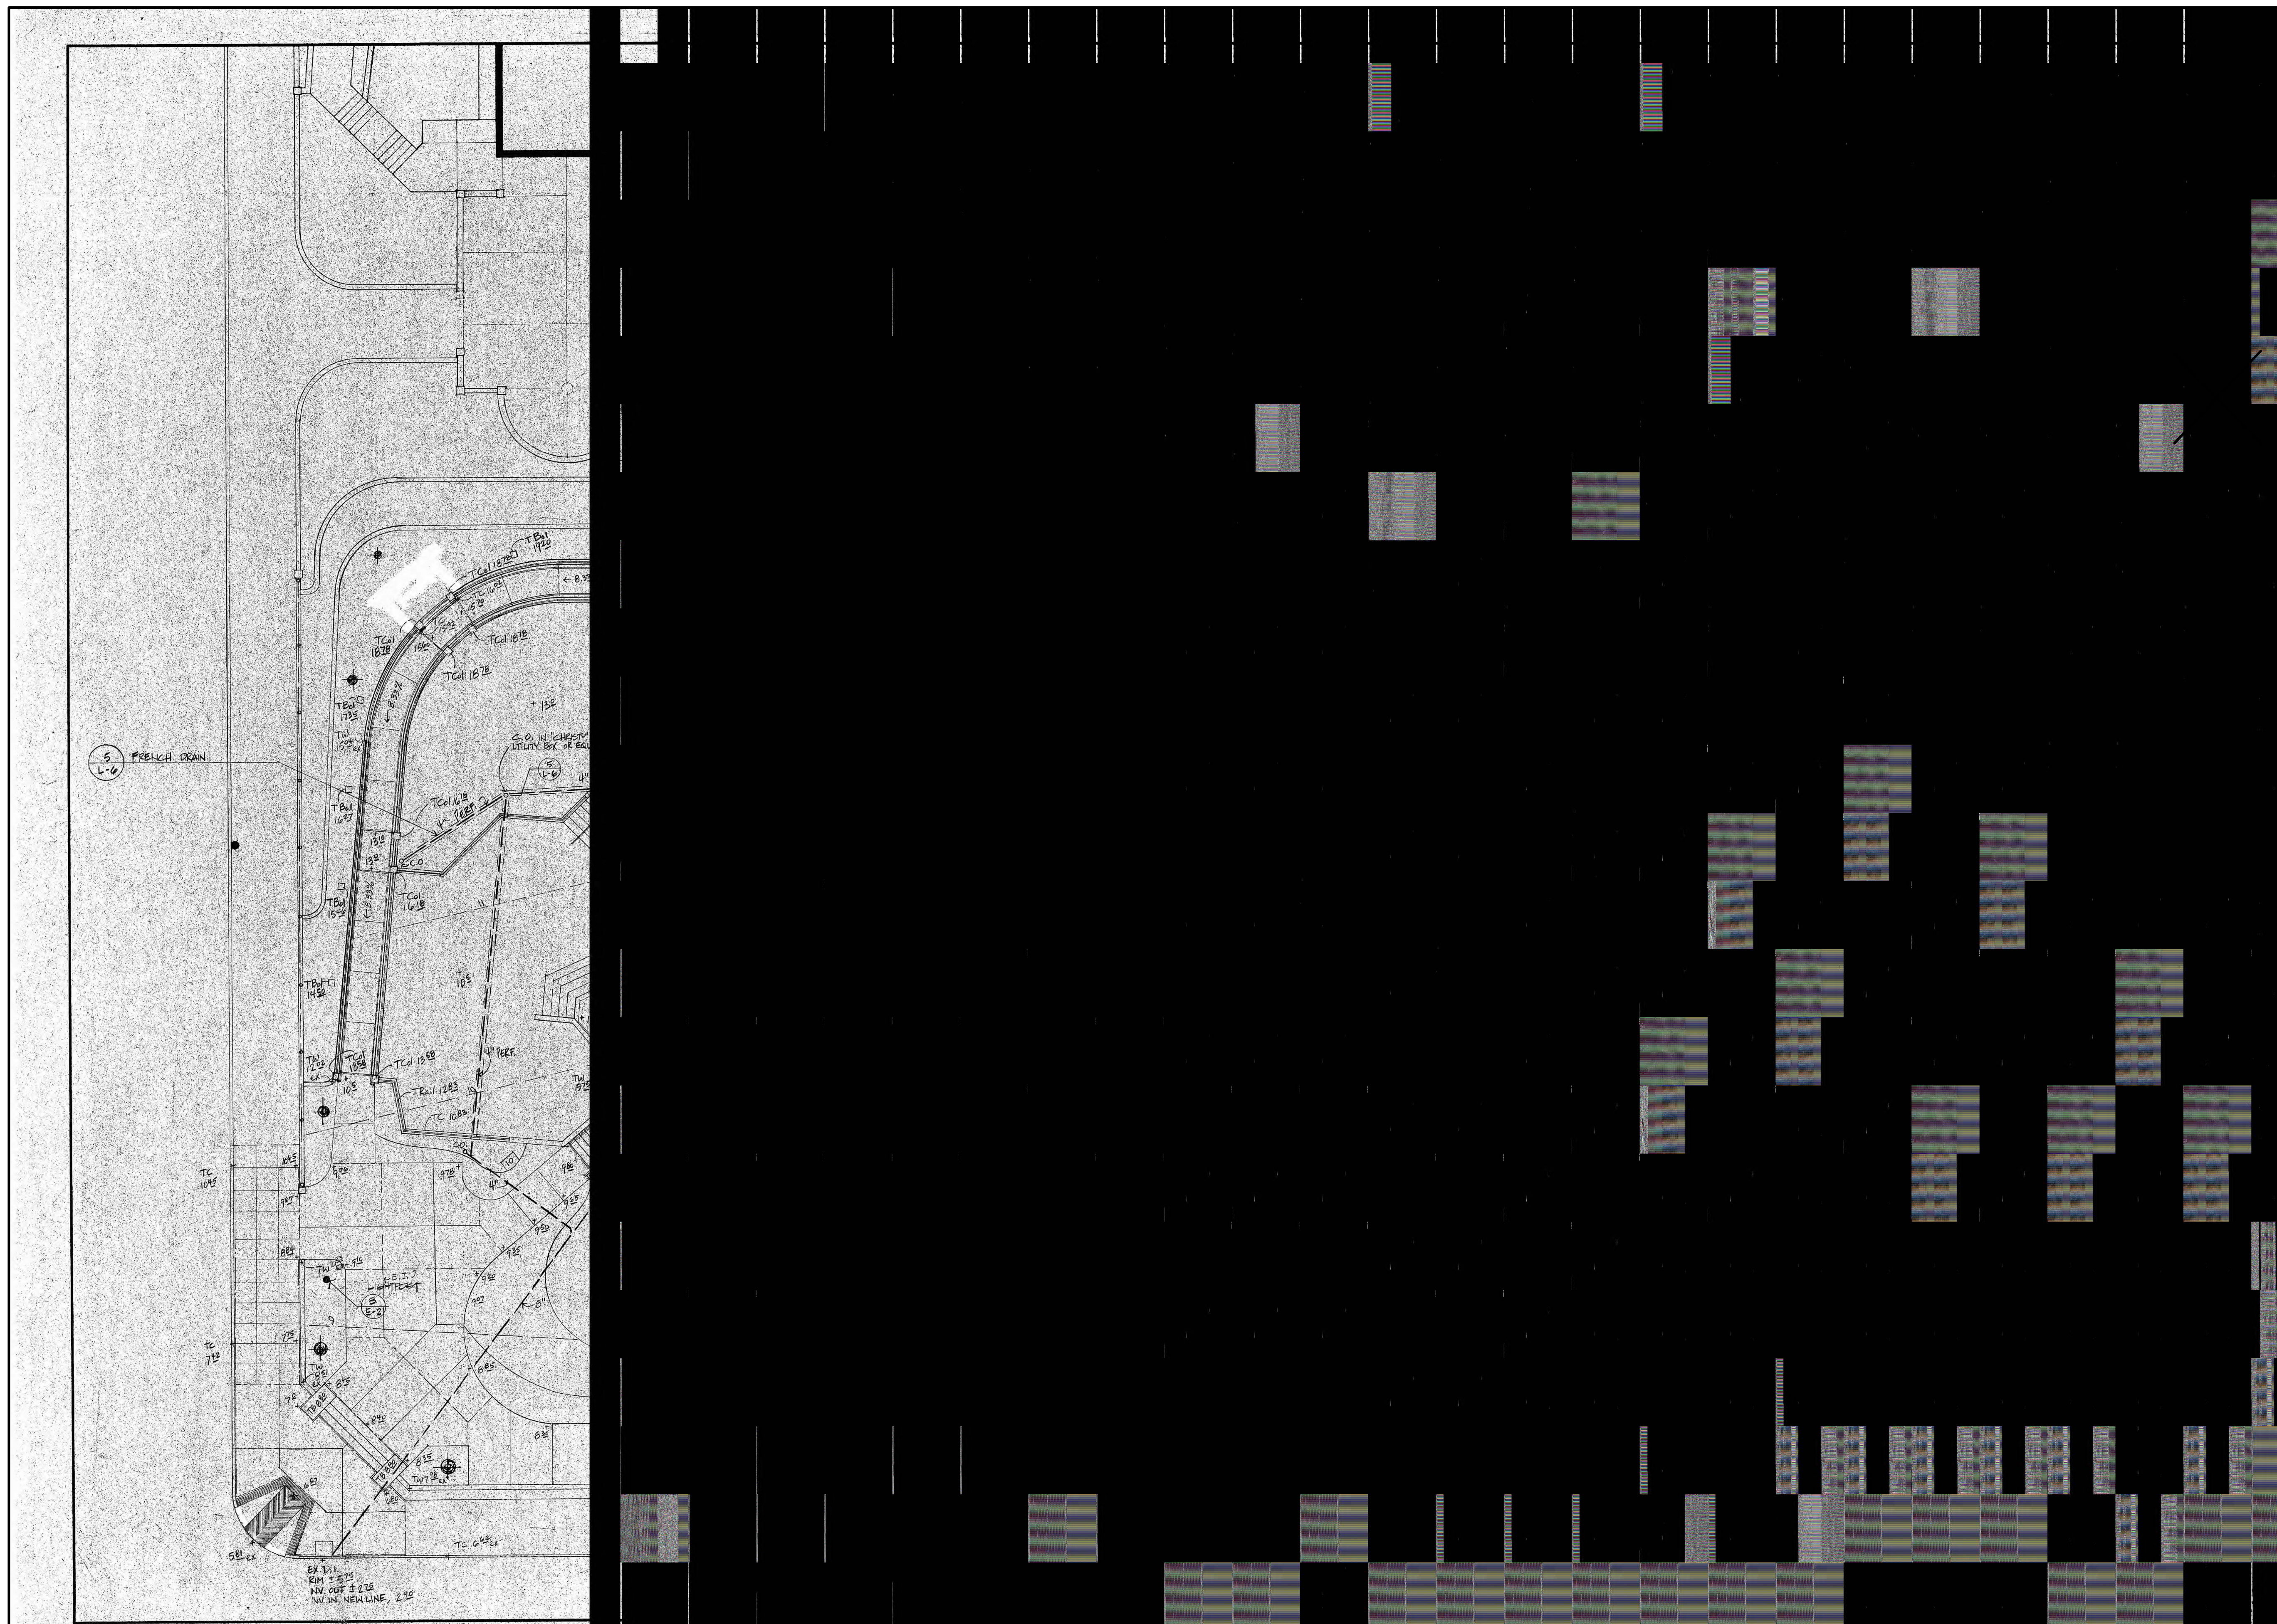

10/7/2015 12:04 PM