

PROJECT/CLIENT NAME

Dunphy Park  
Improvement Project

200 Napa Street  
Sausalito, CA 94965

Owner:  
City of Sausalito  
420 Litho St.  
Sausalito, CA 94965

RHAA PROJECT NUMBER

16042A

CONSULTANT

SUBMITTAL

Permit Submittal


DATE

21 August 2017

REVISIONS

No.	Date	Description
1	9-18-2017	Permit Plan Check Response

REGISTRATION AND SIGNATURE

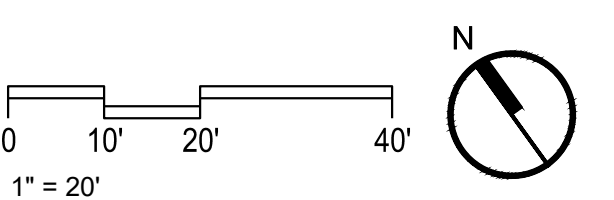

SHEET TITLE  
GRADING PLAN

DRAWN BY: JG CHECKED BY: MW

# C2.0

LEGEND

GRADE BREAK	
MINOR CONTOUR	
MAJOR CONTOUR	
LIMITS OF WORK	
SAWCUT	
SLOPE	
FINISH FLOOR ELEVATION	
FLOW DIRECTION	
CURB OPENING PER 1/C4.1	
FLUSH CURB PER 1/C4.0	

GENERAL NOTES

- FOR GRADING ALONG PATHWAYS, BOCCO COURTS, AND VOLLEYBALL COURT, SLP.
- FOR GRADING AND IMPROVEMENTS ALONG SHORELINE, SLP.
- FINISHED GRADE IN PARKING ISLANDS SHALL BE MINIMUM 3 INCHES BELOW ADJACENT TOP OF CURB ELEVATION AND SLOPED TO DRAIN TOWARDS AREA DRAINS. COORDINATE GRADING IN LANDSCAPED AREAS WITH LANDSCAPE ARCHITECT.


EARTHWORK ANALYSIS

	CUT ANALYSIS (CUBIC YARDS)	FILL ANALYSIS (CUBIC YARDS)
PROJECT TOTALS	3,993	3,634
PROJECT NET	360 ± CU YDS (EXPORT)*	

\*SITE GRADING TO BE ADJUSTED ON-SITE SO THAT NO IMPORT OR EXPORT IS REQUIRED

NOTE

SHERWOOD DESIGN ENGINEERS IS NOT AN ENGINEERING CONTRACTOR, NOR SHOULD OUR RENDERING OF CUT AND FILL EARTHWORK VOLUMES BE CONSIDERED EQUIVALENT TO THE NATURE AND EXTENT OF SERVICE AN ENGINEERING CONTRACTOR WOULD PROVIDE. THIS ESTIMATE IS BASED SOLELY ON OUR OWN ANALYSIS, WHICH IS AS ACCURATE AS THE INFORMATION PROVIDED TO US IN REGARDS TO EXISTING TOPOGRAPHY AND CONCEPTUAL GRADING. THIS ANALYSIS WILL NOT REFLECT THE LOCALIZED SITE CONDITIONS NOT REPRESENTED ON THE TOPOGRAPHIC SURVEY, NOR DOES IT TAKE INTO EFFECT FACTORS SUCH AS SHRINKAGE, SWELL, LOSS DURING TRANSPORT AND SUBSISTENCE, UNLESS OTHERWISE STATED ON QUANTITIES TABLE ABOVE. THIS EARTHWORK VOLUME ANALYSIS SHOULD NOT BE USED FOR BID PURPOSES. DUE TO THESE FACTORS, SHERWOOD DESIGN ENGINEERS CANNOT GUARANTEE THE ACCURACY OF OUR EARTHWORK VOLUME ESTIMATE BEYOND USE AS A PLANNING TOOL.

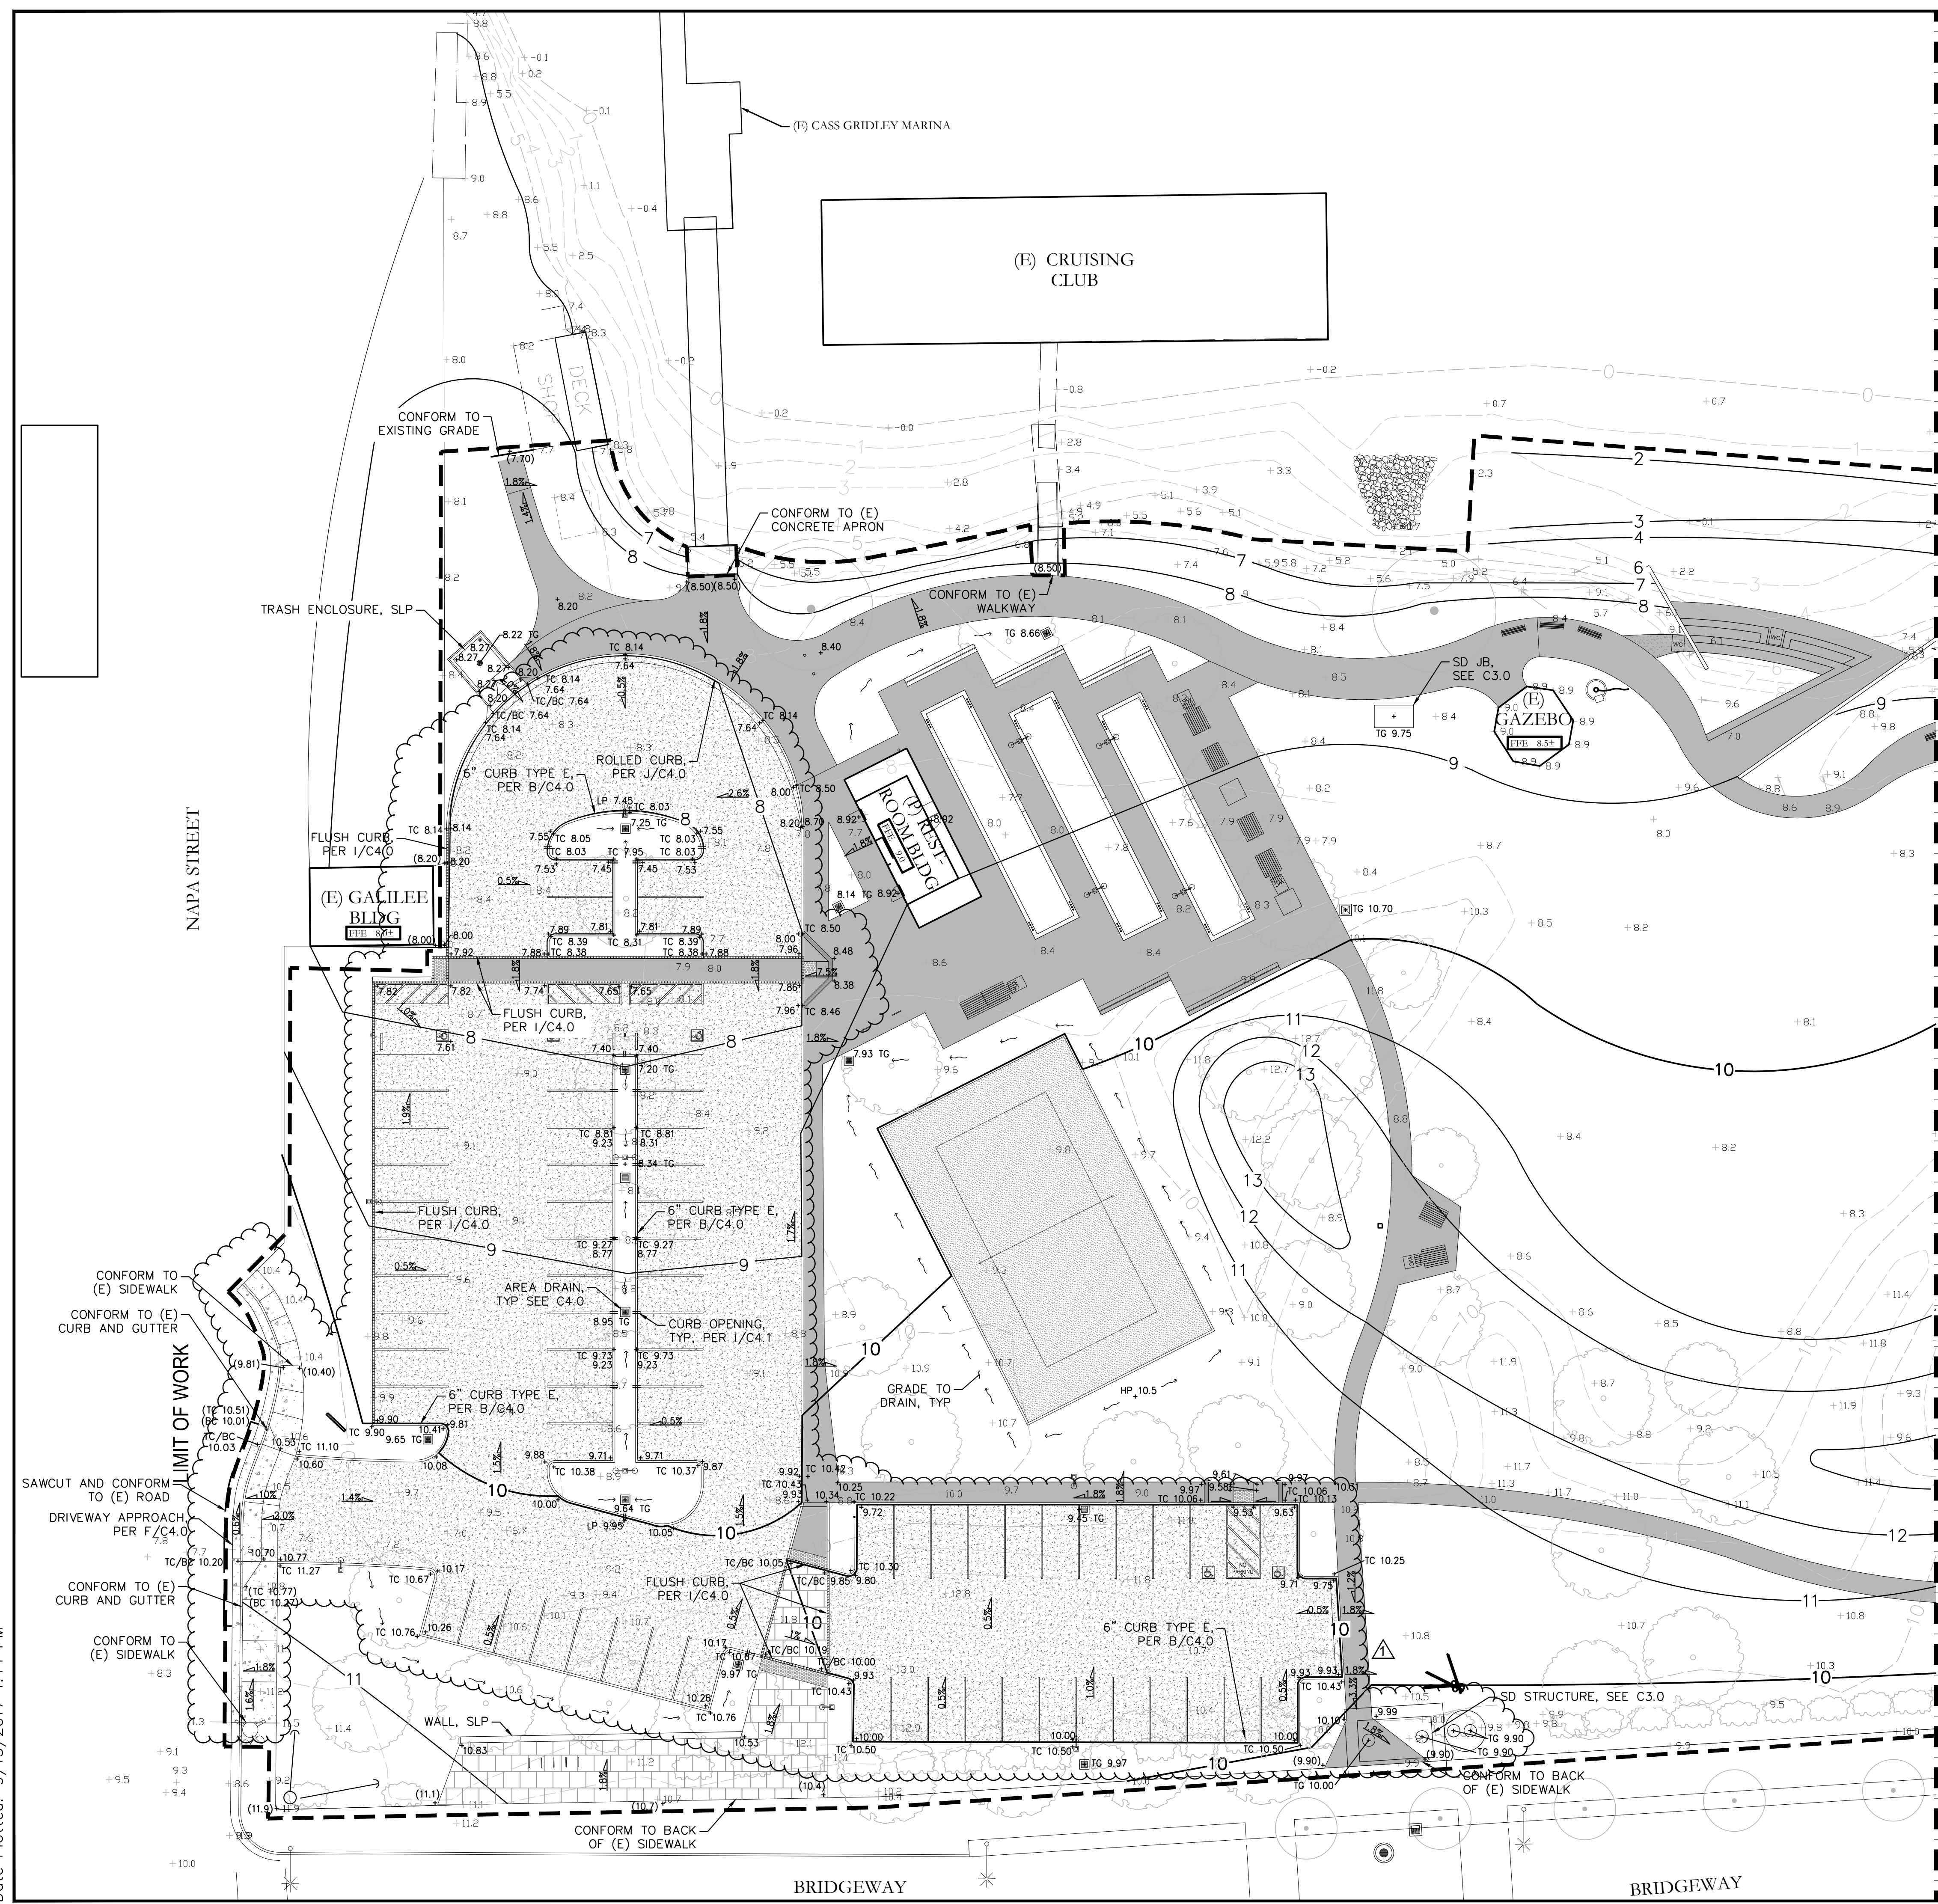

MATCHLINE - SEE C2.1

P:\2017\17-02\_Dunphy\04\_Design\04\_CD\C2.0 - GRADING PLAN.dwg (2/1/17 11:40 AM) (User: jstump) 9/15/2017 1:14 PM  
Date Plotted: 9/15/2017 1:14 PM

PROJECT/CLIENT NAME

## Dunphy Park Improvement Project

200 Napa Street  
Sausalito, CA 94965

Owner:  
City of Sausalito  
420 Litho St.  
Sausalito, CA 94965

RHAA PROJECT NUMBER

16042A

CONSULTANT

SUBMITTAL

### Permit Submittal


DATE

21 August 2017

REVISIONS

No.	Date	Description
1	9-18-2017	Permit Plan Check Response

REGISTRATION AND SIGNATURE

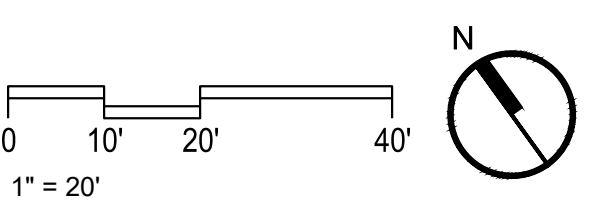

### SHEET TITLE DRAINAGE PLAN

DRAWN BY: JG CHECKED BY: MW

# C2.1

### LEGEND

GRADE BREAK	
MINOR CONTOUR	
MAJOR CONTOUR	
LIMITS OF WORK	
SAWCUT	
SLOPE	
FINISH FLOOR ELEVATION	
FLOW DIRECTION	
CURB OPENING PER 1/C4.1	
FLUSH CURB PER 1/C4.0	

### GENERAL NOTES

- FOR GRADING ALONG PATHWAYS, BOCCO COURTS, AND VOLLEYBALL COURT, SLP.
- FOR GRADING AND IMPROVEMENTS ALONG SHORELINE, SLP.


### EARTHWORK ANALYSIS

	CUT ANALYSIS (CUBIC YARDS)	FILL ANALYSIS (CUBIC YARDS)
PROJECT TOTALS	3,993	3,634

PROJECT NET 360 ± CU YDS (EXPORT)\*

\*SITE GRADING TO BE ADJUSTED ON-SITE SO THAT NO IMPORT OR EXPORT IS REQUIRED

**NOTE**  
SHERWOOD DESIGN ENGINEERS IS NOT AN ENGINEERING CONTRACTOR, NOR SHOULD OUR RENDERING OF CUT AND FILL EARTHWORK VOLUMES BE CONSIDERED EQUIVALENT TO THE NATURE AND EXTENT OF SERVICE AN ENGINEERING CONTRACTOR WOULD PROVIDE. THIS ESTIMATE IS BASED SOLELY ON OUR OWN ANALYSIS, WHICH IS AS ACCURATE AS THE INFORMATION PROVIDED TO US IN REGARDS TO EXISTING TOPOGRAPHY AND CONCEPTUAL GRADING. THIS ANALYSIS WILL NOT REFLECT THE LOCALIZED SITE CONDITIONS NOT REPRESENTED ON THE TOPOGRAPHIC SURVEY, NOR DOES IT TAKE INTO EFFECT FACTORS SUCH AS SHRINKAGE, SWELL, LOSS DURING TRANSPORT AND SUBSIDENCE, UNLESS OTHERWISE STATED ON QUANTITIES TABLE ABOVE. THIS EARTHWORK VOLUME ANALYSIS SHOULD NOT BE USED FOR BID PURPOSES. DUE TO THESE FACTORS, SHERWOOD DESIGN ENGINEERS CANNOT GUARANTEE THE ACCURACY OF OUR EARTHWORK VOLUME ESTIMATE BEYOND USE AS A PLANNING TOOL.

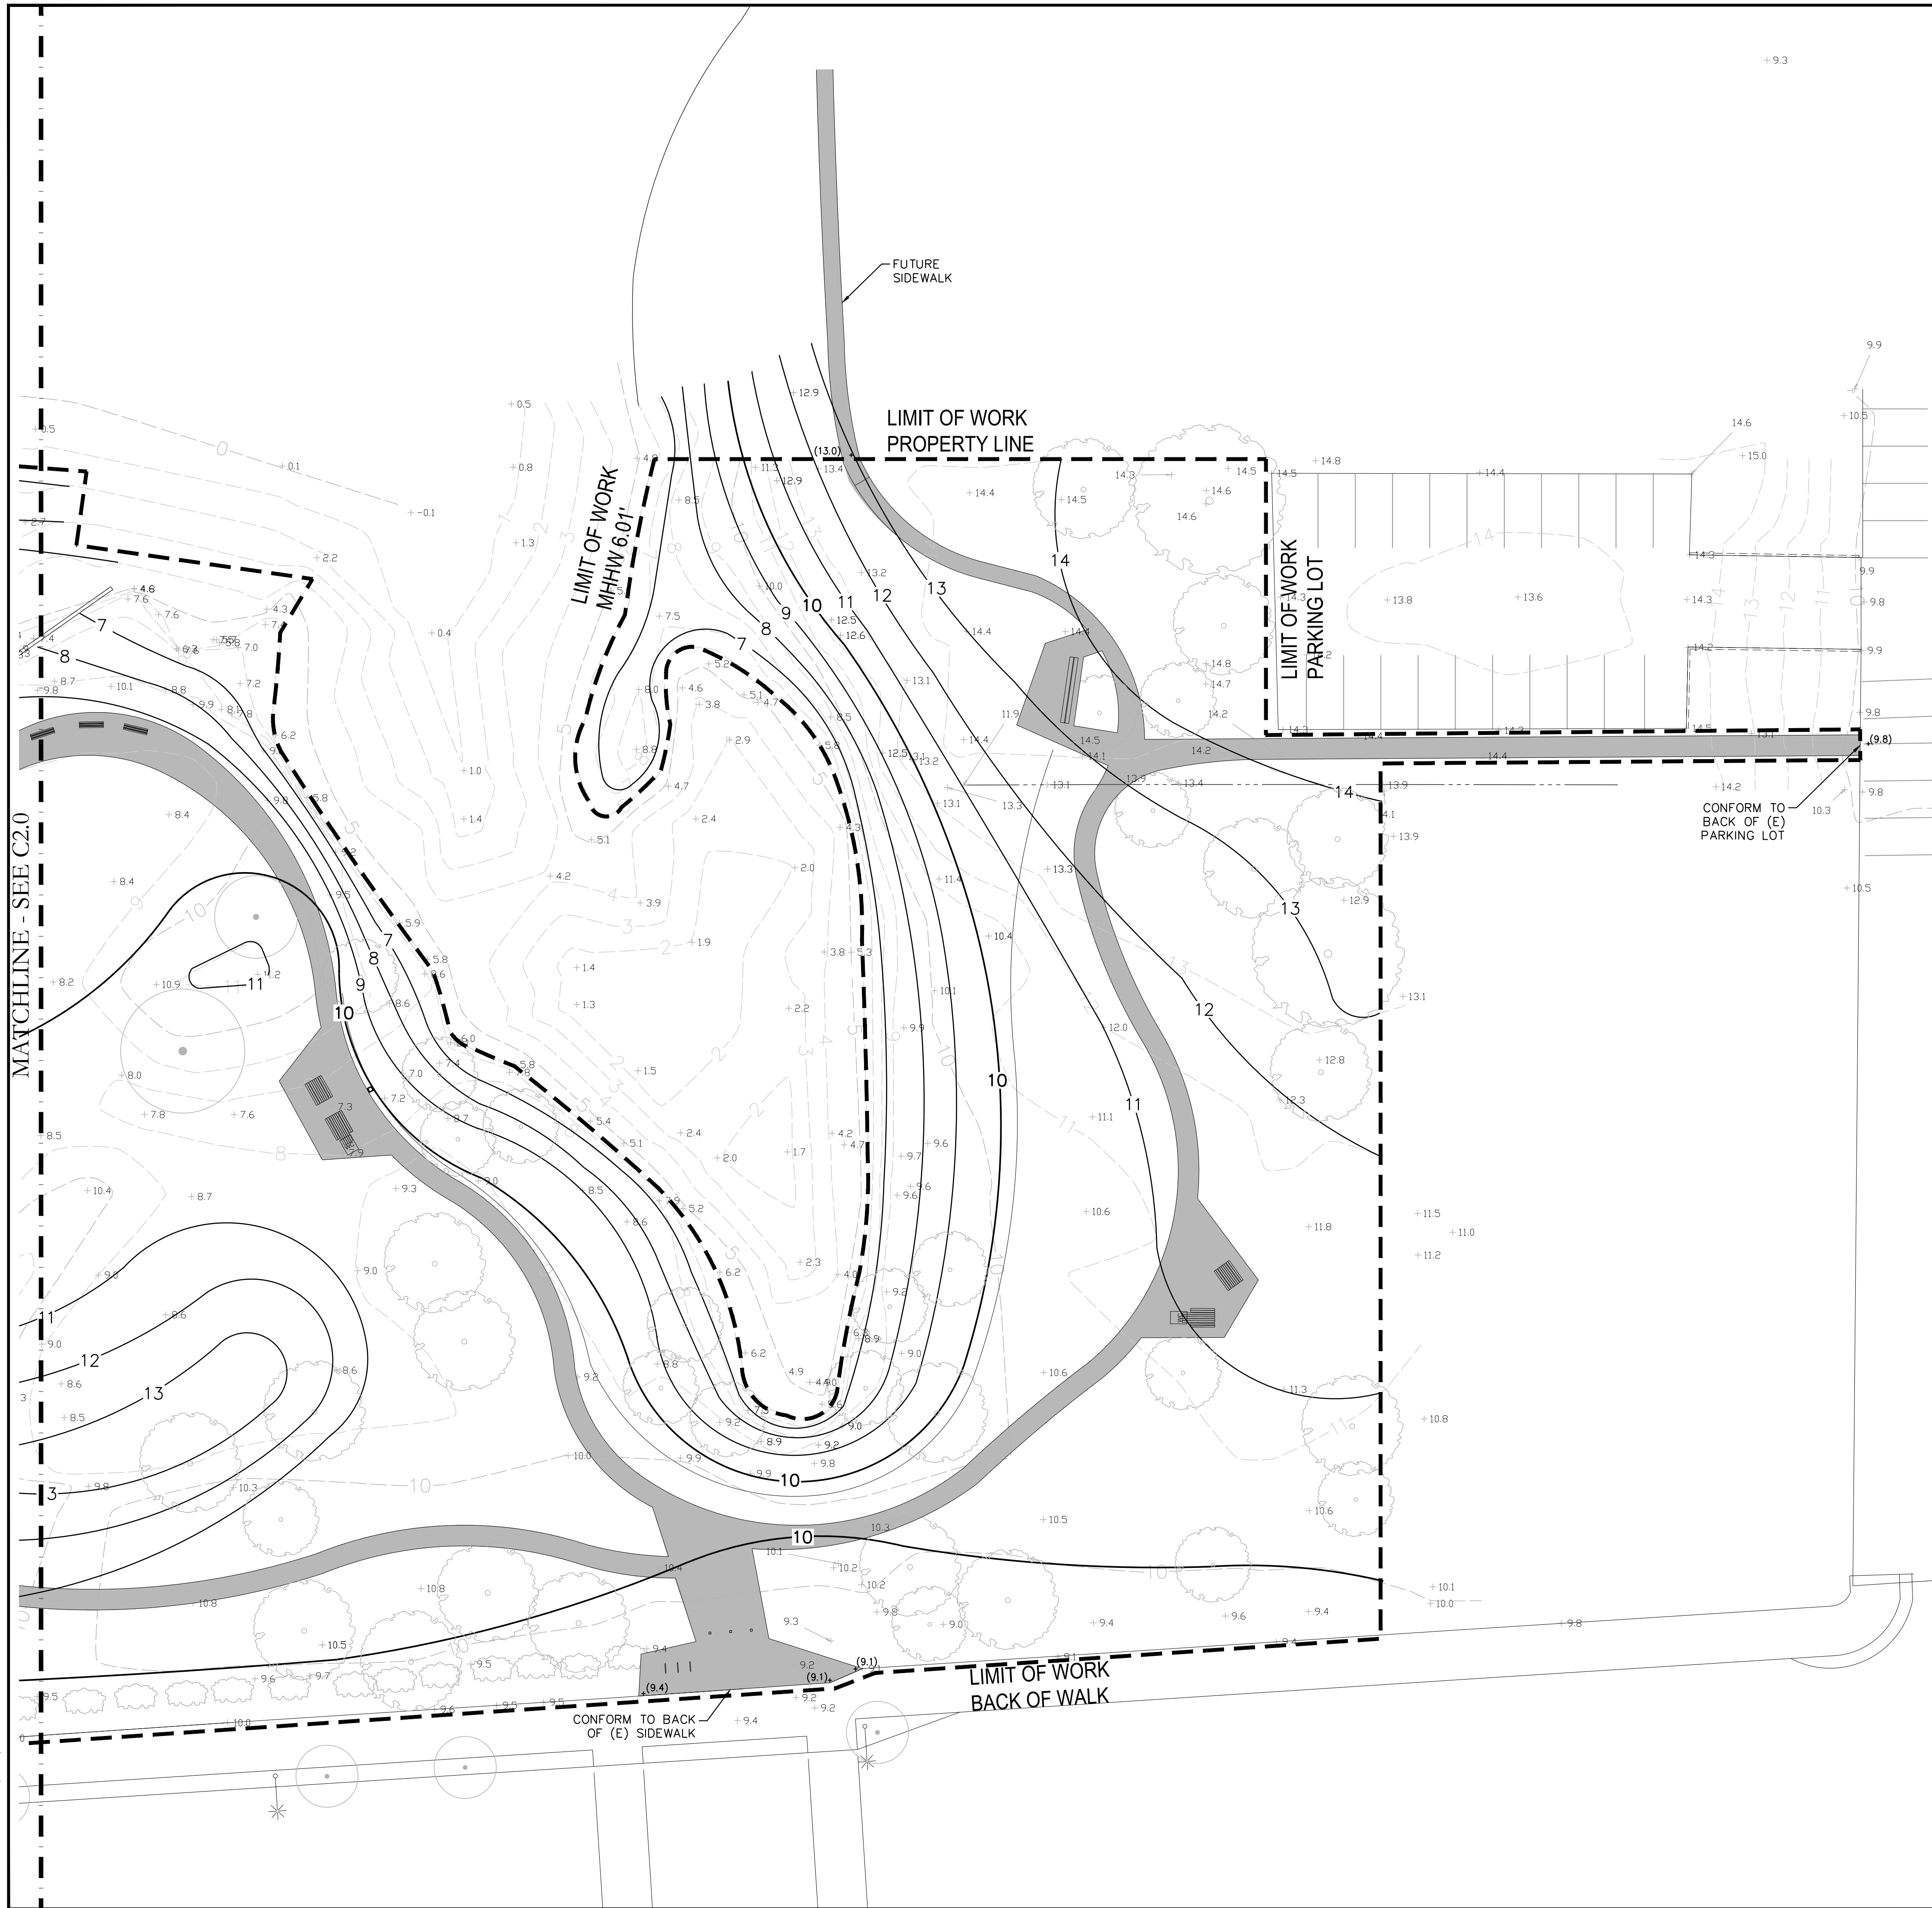

PROJECT/CLIENT NAME

## Dunphy Park Improvement Project

200 Napa Street  
Sausalito, CA 94965

Owner:  
City of Sausalito  
420 Litho St.  
Sausalito, CA 94965

RHAA PROJECT NUMBER

16042A

CONSULTANT

SUBMITTAL

### Permit Submittal


DATE

21 August 2017

REVISIONS

No.	Date	Description
1	9-18-2017	Permit Plan Check Response

REGISTRATION AND SIGNATURE

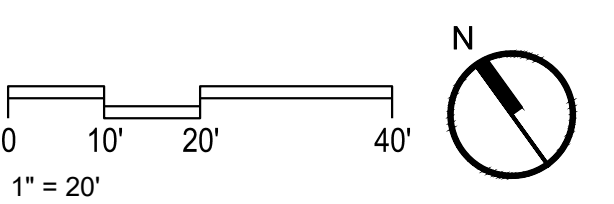

### SHEET TITLE SUBGRADE PLAN

DRAWN BY: JG CHECKED BY: MW


# C2.2

### LEGEND

GRADE BREAK	
MINOR CONTOUR	
MAJOR CONTOUR	
LIMITS OF WORK	
SAWCUT	
SLOPE	
FINISH FLOOR ELEVATION	
FLOW DIRECTION	
CURB OPENING PER 1/C4.1	
FLUSH CURB PER 1/C4.0	

### GENERAL NOTES

1. SUBGRADE ELEVATIONS SHOWN FOR POROUS ASPHALT SECTION ONLY, SLP FOR SUBGRADE UNDER OTHER SURFACES.
2. SUBGRADE COMPACTION PER SOILS REPORT.
3. ALL SUBGRADE PADS TO BE FLAT.
4. SUBGRADE PADS SHALL STEP UP OR DOWN IN ELEVATION WITH A SEPARATION OF A BERM (1 FT TOP WIDTH, 4 IN. HEIGHT, WITH 4:1 SIDE SLOPES ON BOTH SIDES).

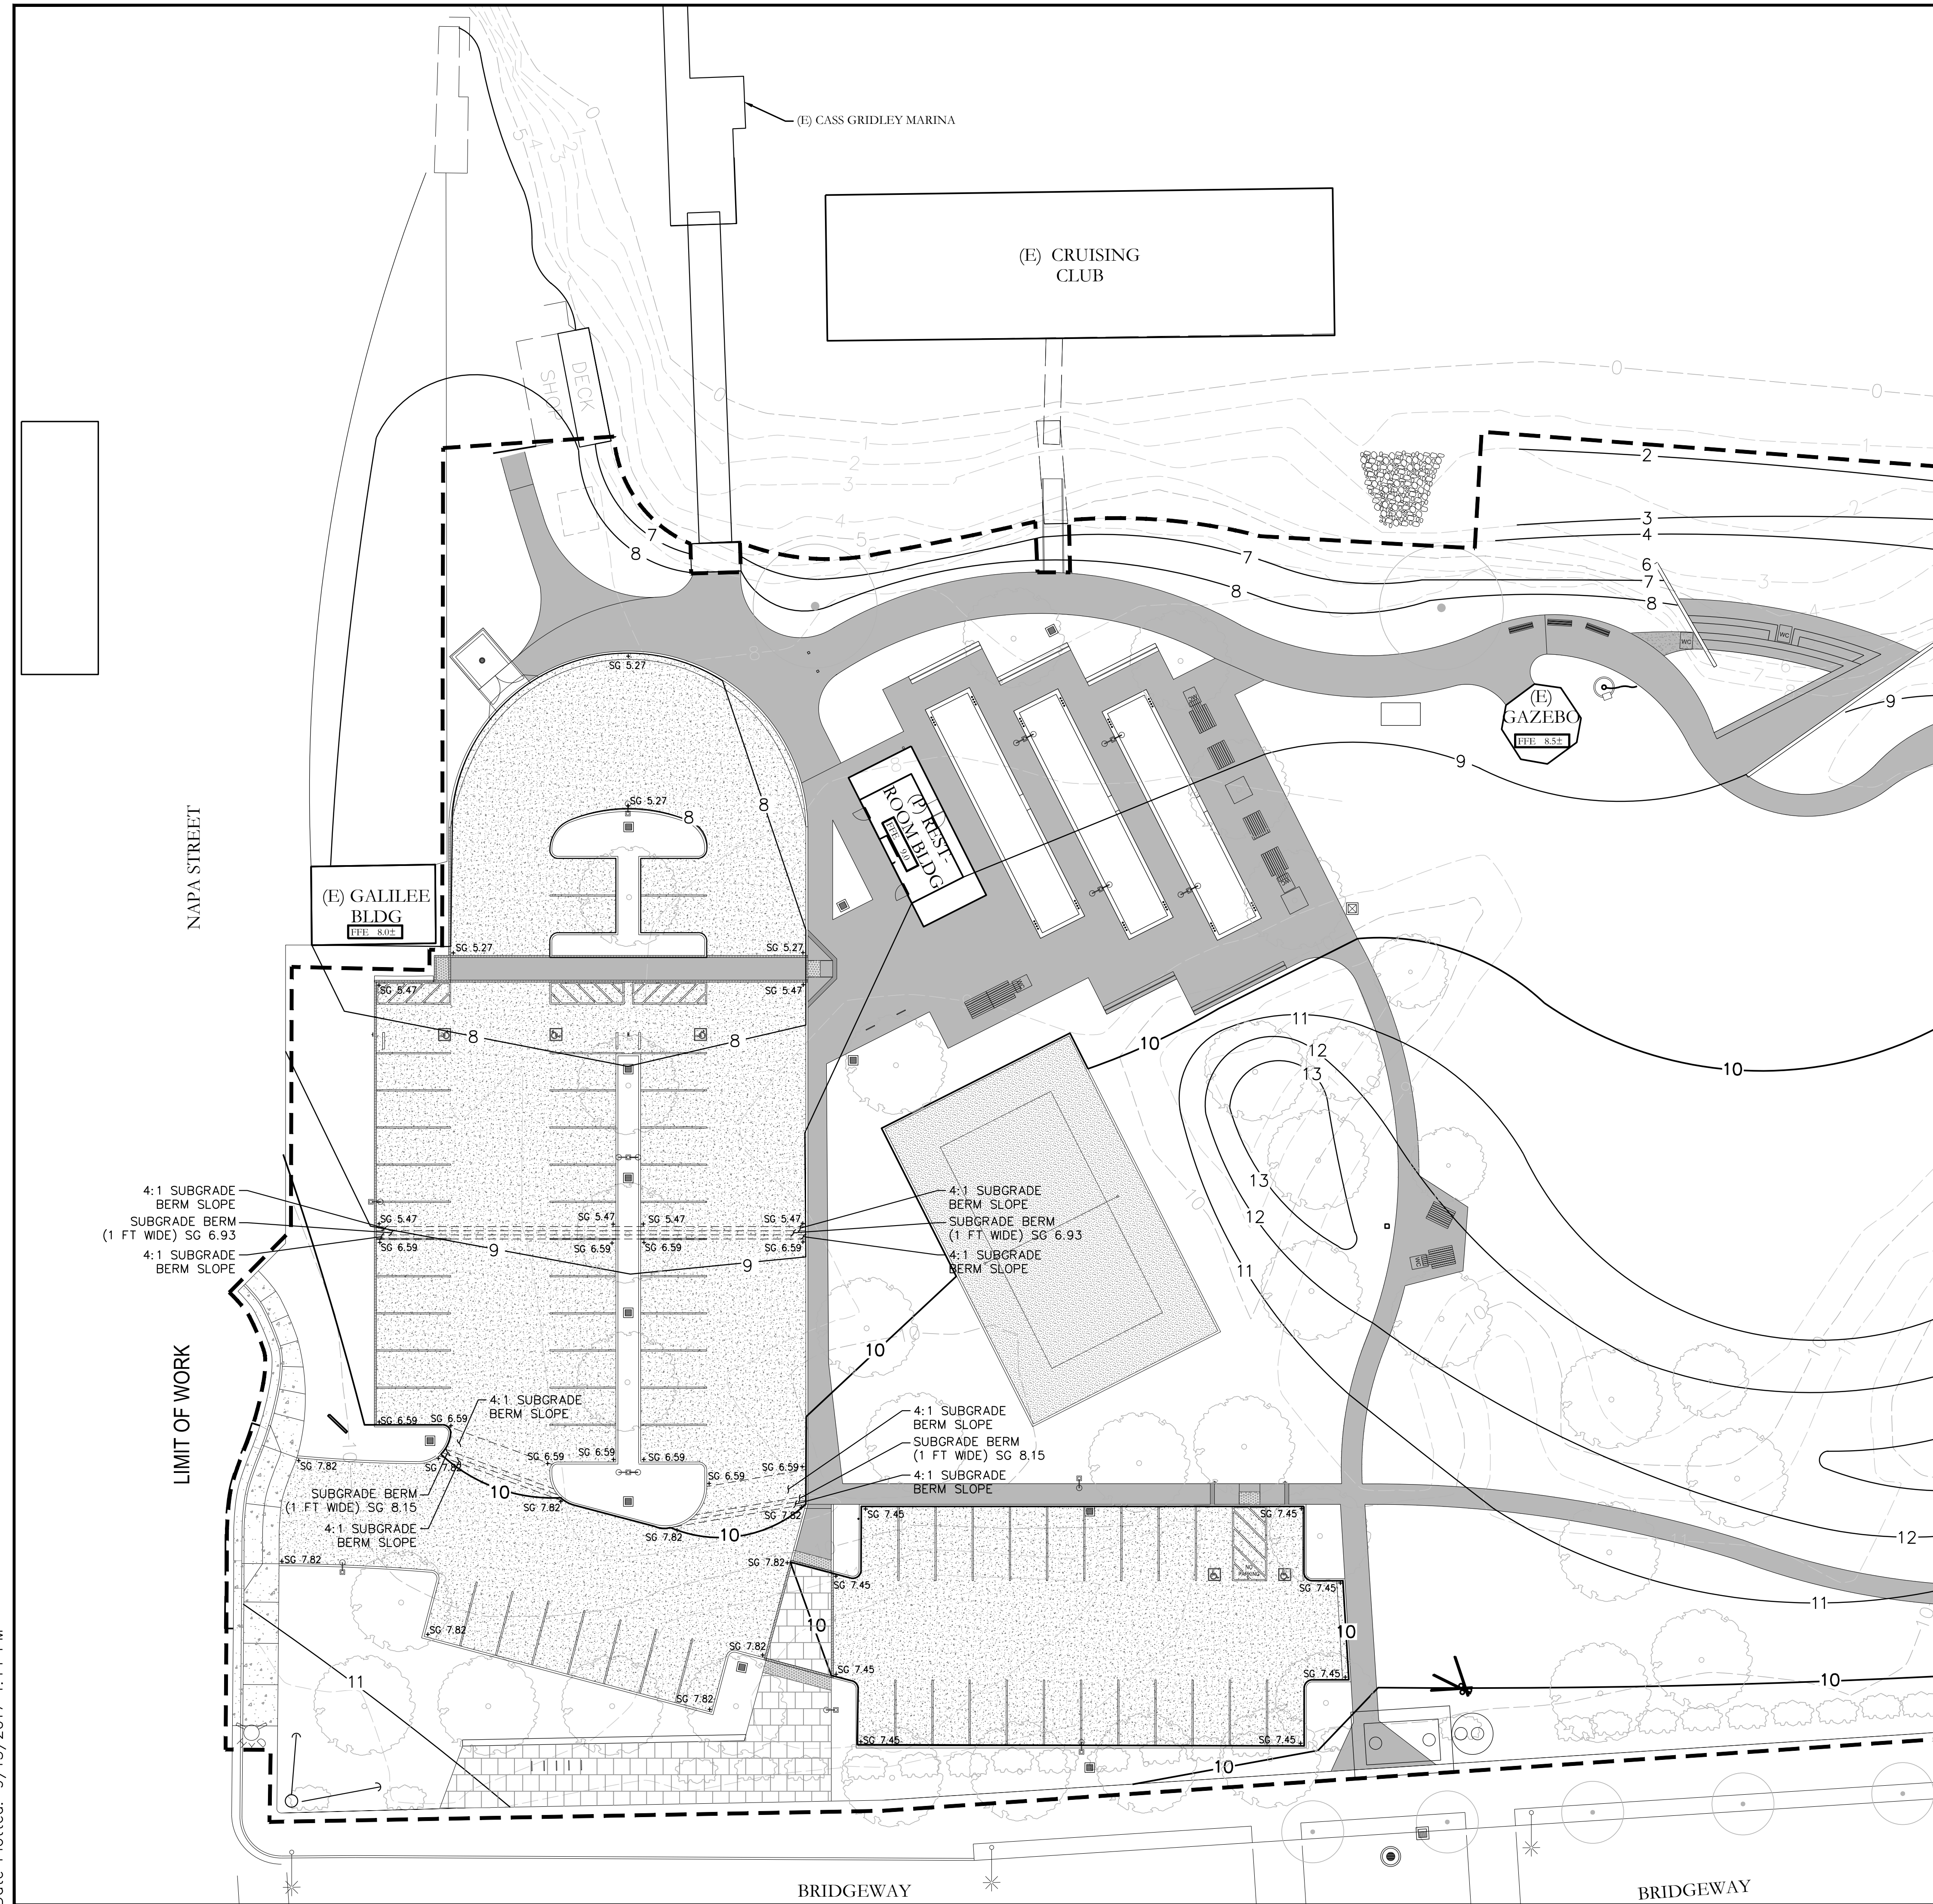

PROJECT/CLIENT NAME

## Dunphy Park Improvement Project

200 Napa Street  
Sausalito, CA 94965

Owner:  
City of Sausalito  
420 Litho St.  
Sausalito, CA 94965

RHAA PROJECT NUMBER

16042A

CONSULTANT

SUBMITTAL

### Permit Submittal


DATE

21 August 2017

REVISIONS

No.	Date	Description
1	9-18-2017	Permit Plan Check Response

REGISTRATION AND SIGNATURE

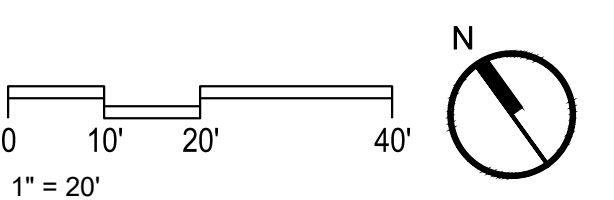

### SHEET TITLE DRAINAGE AND UTILITY PLAN

DRAWN BY: JG CHECKED BY: MW


# C3.0

### LEGEND

DOMESTIC WATER LINE	DW	DW
GAS LINE	GAS	GAS
STORM DRAIN LINE	SD	SD
IRRIGATION	IRR	IRR
STORM DRAIN LINE	FW	FW
DOWNSPOUT, SEE BLDG PLANS	-DS	
CLEANOUT, PER A/C4.1 OR F/C4.1	CO	
AREA DRAIN PER B/C4.1		
CATCH BASIN PER C/C4.1		
STORM DRAIN MANHOLE		
JUNCTION BOX PER A/C4.2		
FIRE HYDRANT PER D/C4.0		
SS MANHOLE PER B/C4.2		
FLUSH CURB PER I/C4.0		

### GENERAL NOTES

- CONTRACTOR SHALL BE RESPONSIBLE FOR ALL FINAL CONNECTIONS BETWEEN RESTROOM BUILDING AND SITE UTILITIES.
- LOCATION AT (E) WATER, GAS, AND SEWER LINES IN NAPA STREET AND BRIDGEWAY AND IN THE PROJECT LIMITS ARE APPROXIMATE. CONTRACTOR TO VERIFY LOCATION IN THE FIELD PRIOR TO CONSTRUCTION WITHIN PROJECT LIMITS.
- FOR UNDERDRAIN DETAIL AT BOCCO COURTS AND SURROUNDING AREAS, SLP.
- UNLABELED STORM DRAIN LINES SERVING UNDER DRAINS OR A SINGLE AREA DRAIN SHALL BE 4" DIAMETER, INSTALLED AT MINIMUM 2% SLOPE, UNLESS OTHERWISE NOTED.
- FOR (E) UTILITY DEMOLITION, SEE DEMOLITION PLAN ON LANDSCAPE PLANS.
- INSTALL CDF AROUND UTILITIES WHERE COVER IS LESS THAN 18". CDF SLURRY TO MEASURE 18" WIDE WITH MIN. 6" ABOVE AND BELOW PIPE.
- CONTRACTOR TO VERIFY ALL EXISTING UTILITY INVERTS AND TIE-IN LOCATIONS IN THE FIELD PRIOR TO CONSTRUCTION. IF ELEVATIONS DIFFER THAN THOSE SHOWN ON THE PLAN, CONTACT THE ENGINEER.
- AFTER UTILITY LOCATION AND ELEVATIONS HAVE BEEN CONFIRMED, CONTRACTOR TO PREPARE SKETCH OF INTERCEPT VAULT AND SEDIMENT COLLECTOR AND SUBMIT TO ENGINEER FOR REVIEW.
- THRUST BLOCKS SHALL BE PLACED AT ALL PRESSURE PIPE BENDS, JUNCTIONS, VALVES, AND FITTINGS PER DETAIL G/C4.0.

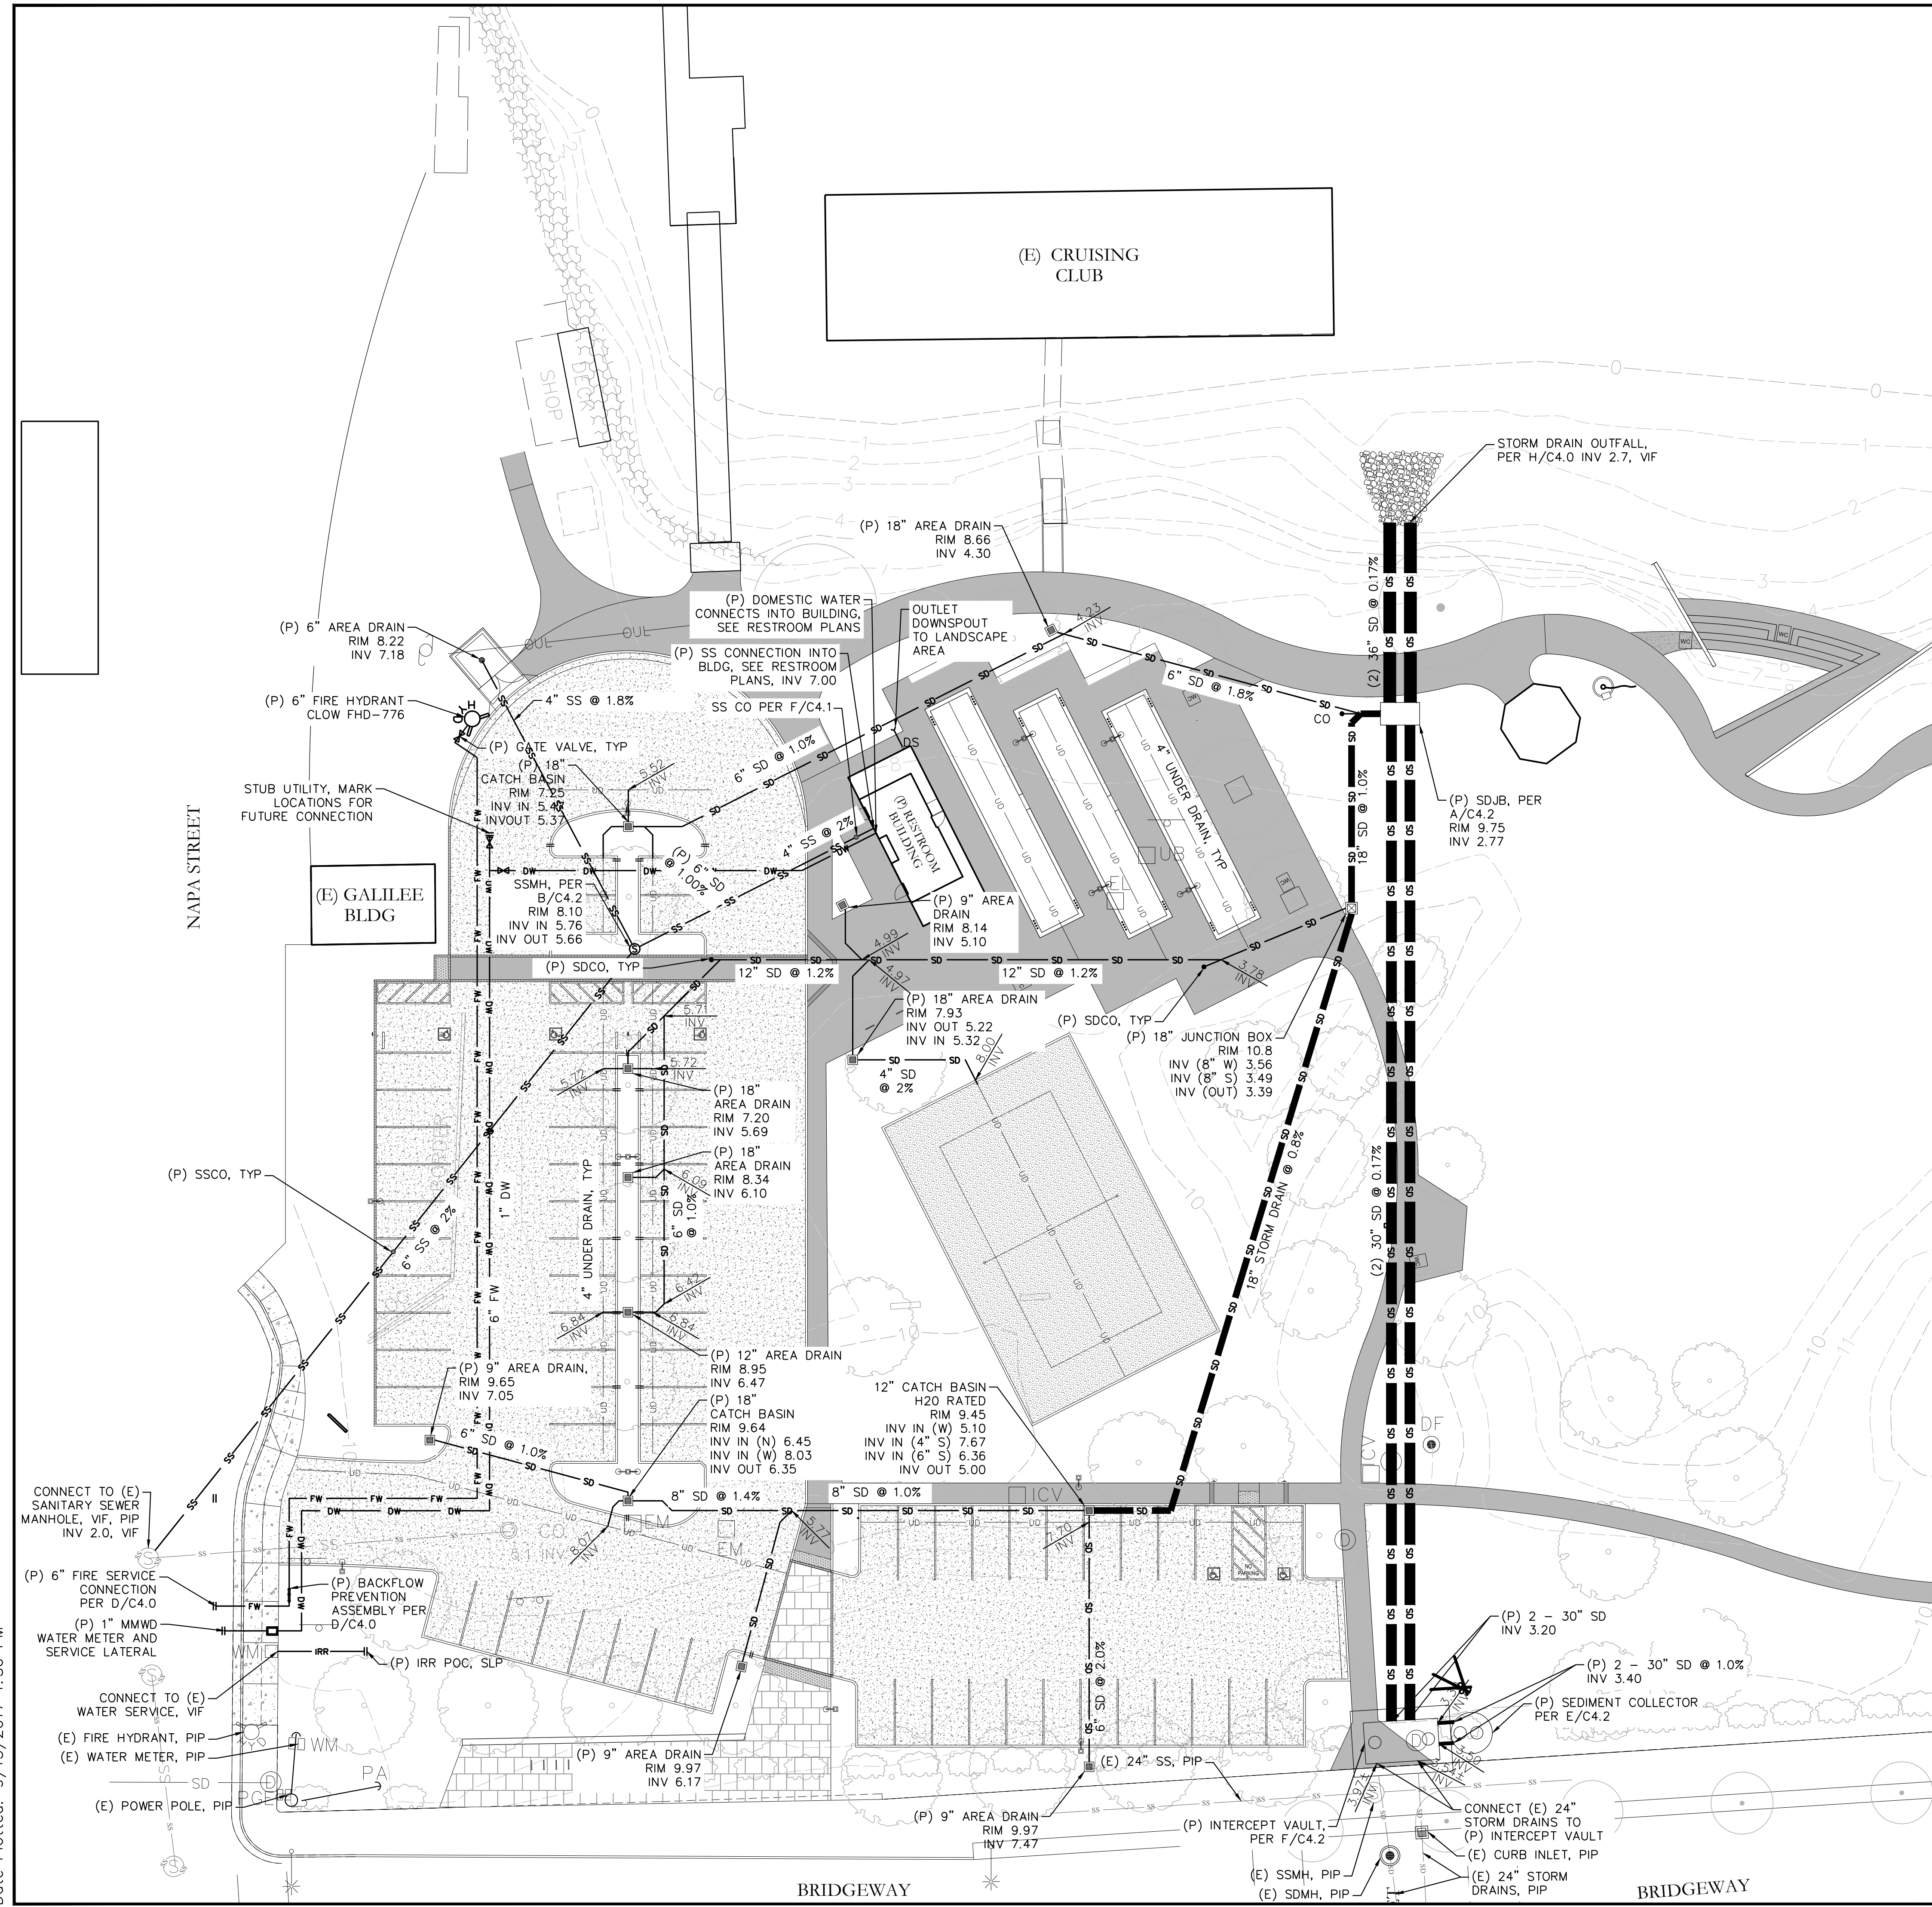

MATCHLINE - SEE C3.1

**Underground Service Alert**

Call: TOLL FREE  
1-800-227-2600

TWO WORKING DAYS BEFORE YOU DIG

P:\2017\17-02\_Dunphy\17-02\_C3.0 - DRAINAGE PLAN.dwg C:\Users\jg\OneDrive\Documents\17-02\_Dunphy\17-02\_C3.0 - DRAINAGE PLAN.dwg 9/15/2017 1:56:51 PM AKR11 (expanded) D: 06/06/17 1:56 PM Date Plotted: 9/15/2017 1:56 PM

PROJECT/CLIENT NAME

## Dunphy Park Improvement Project

200 Napa Street  
Sausalito, CA 94965

Owner:  
City of Sausalito  
420 Litho St.  
Sausalito, CA 94965

RHAA PROJECT NUMBER

16042A

CONSULTANT

SUBMITTAL

### Permit Submittal


DATE

21 August 2017

REVISIONS

No.	Date	Description
1	9-18-2017	Permit Plan Check Response

REGISTRATION AND SIGNATURE

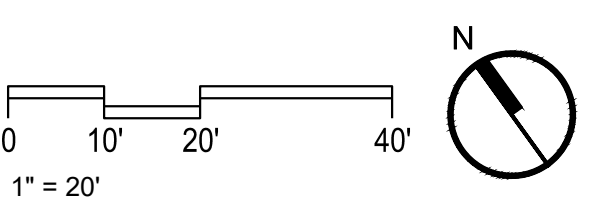

SHEET TITLE  
**DRAINAGE AND UTILITY PLAN**

DRAWN BY: JG CHECKED BY: MW


# C3.1

### LEGEND

DOMESTIC WATER LINE	— DW — DW —
GAS LINE	— GAS — GAS —
STORM DRAIN LINE	— SD — SD —
IRRIGATION	— IRR — IRR —
STORM DRAIN LINE	— FW — FW —
DOWNSPOUT, SEE BLDG PLANS	• DS
CLEANOUT, PER A/C4.1 OR F/C4.1	● CO
AREA DRAIN PER B/C4.1	■
CATCH BASIN PER C/C4.1	□
STORM DRAIN MANHOLE	⊙
JUNCTION BOX PER A/C4.2	⊕
FIRE HYDRANT PER D/C4.0	⊗
SS MANHOLE PER B/C4.2	⊙
FLUSH CURB PER I/C4.0	▬

### GENERAL NOTES

- CONTRACTOR SHALL BE RESPONSIBLE FOR ALL FINAL CONNECTIONS BETWEEN RESTROOM BUILDING AND SITE UTILITIES.
- LOCATION AT (E) WATER, GAS, AND SEWER LINES IN NAPA STREET AND BRIDGEWAY AND IN THE PROJECT LIMITS ARE APPROXIMATE. CONTRACTOR TO VERIFY LOCATION IN THE FIELD PRIOR TO CONSTRUCTION WITHIN.
- FOR UNDERDRAIN DETAIL AT BOCCO COURTS AND SURROUNDING AREAS, SLP.
- UNLABELED STORM DRAIN LINES SERVING UNDER DRAINS OR A SINGLE AREA DRAIN SHALL BE 4" DIAMETER, INSTALLED AT MINIMUM 2% SLOPE, UNLESS OTHERWISE NOTED.
- FOR (E) UTILITY DEMOLITION, SEE DEMOLITION PLAN ON LANDSCAPE PLANS.
- INSTALL CDF AROUND UTILITIES WHERE COVER IS LESS THAN 18". CDF SLURRY TO MEASURE 18" WIDE WITH MIN. 6" ABOVE AND BELOW PIPE.

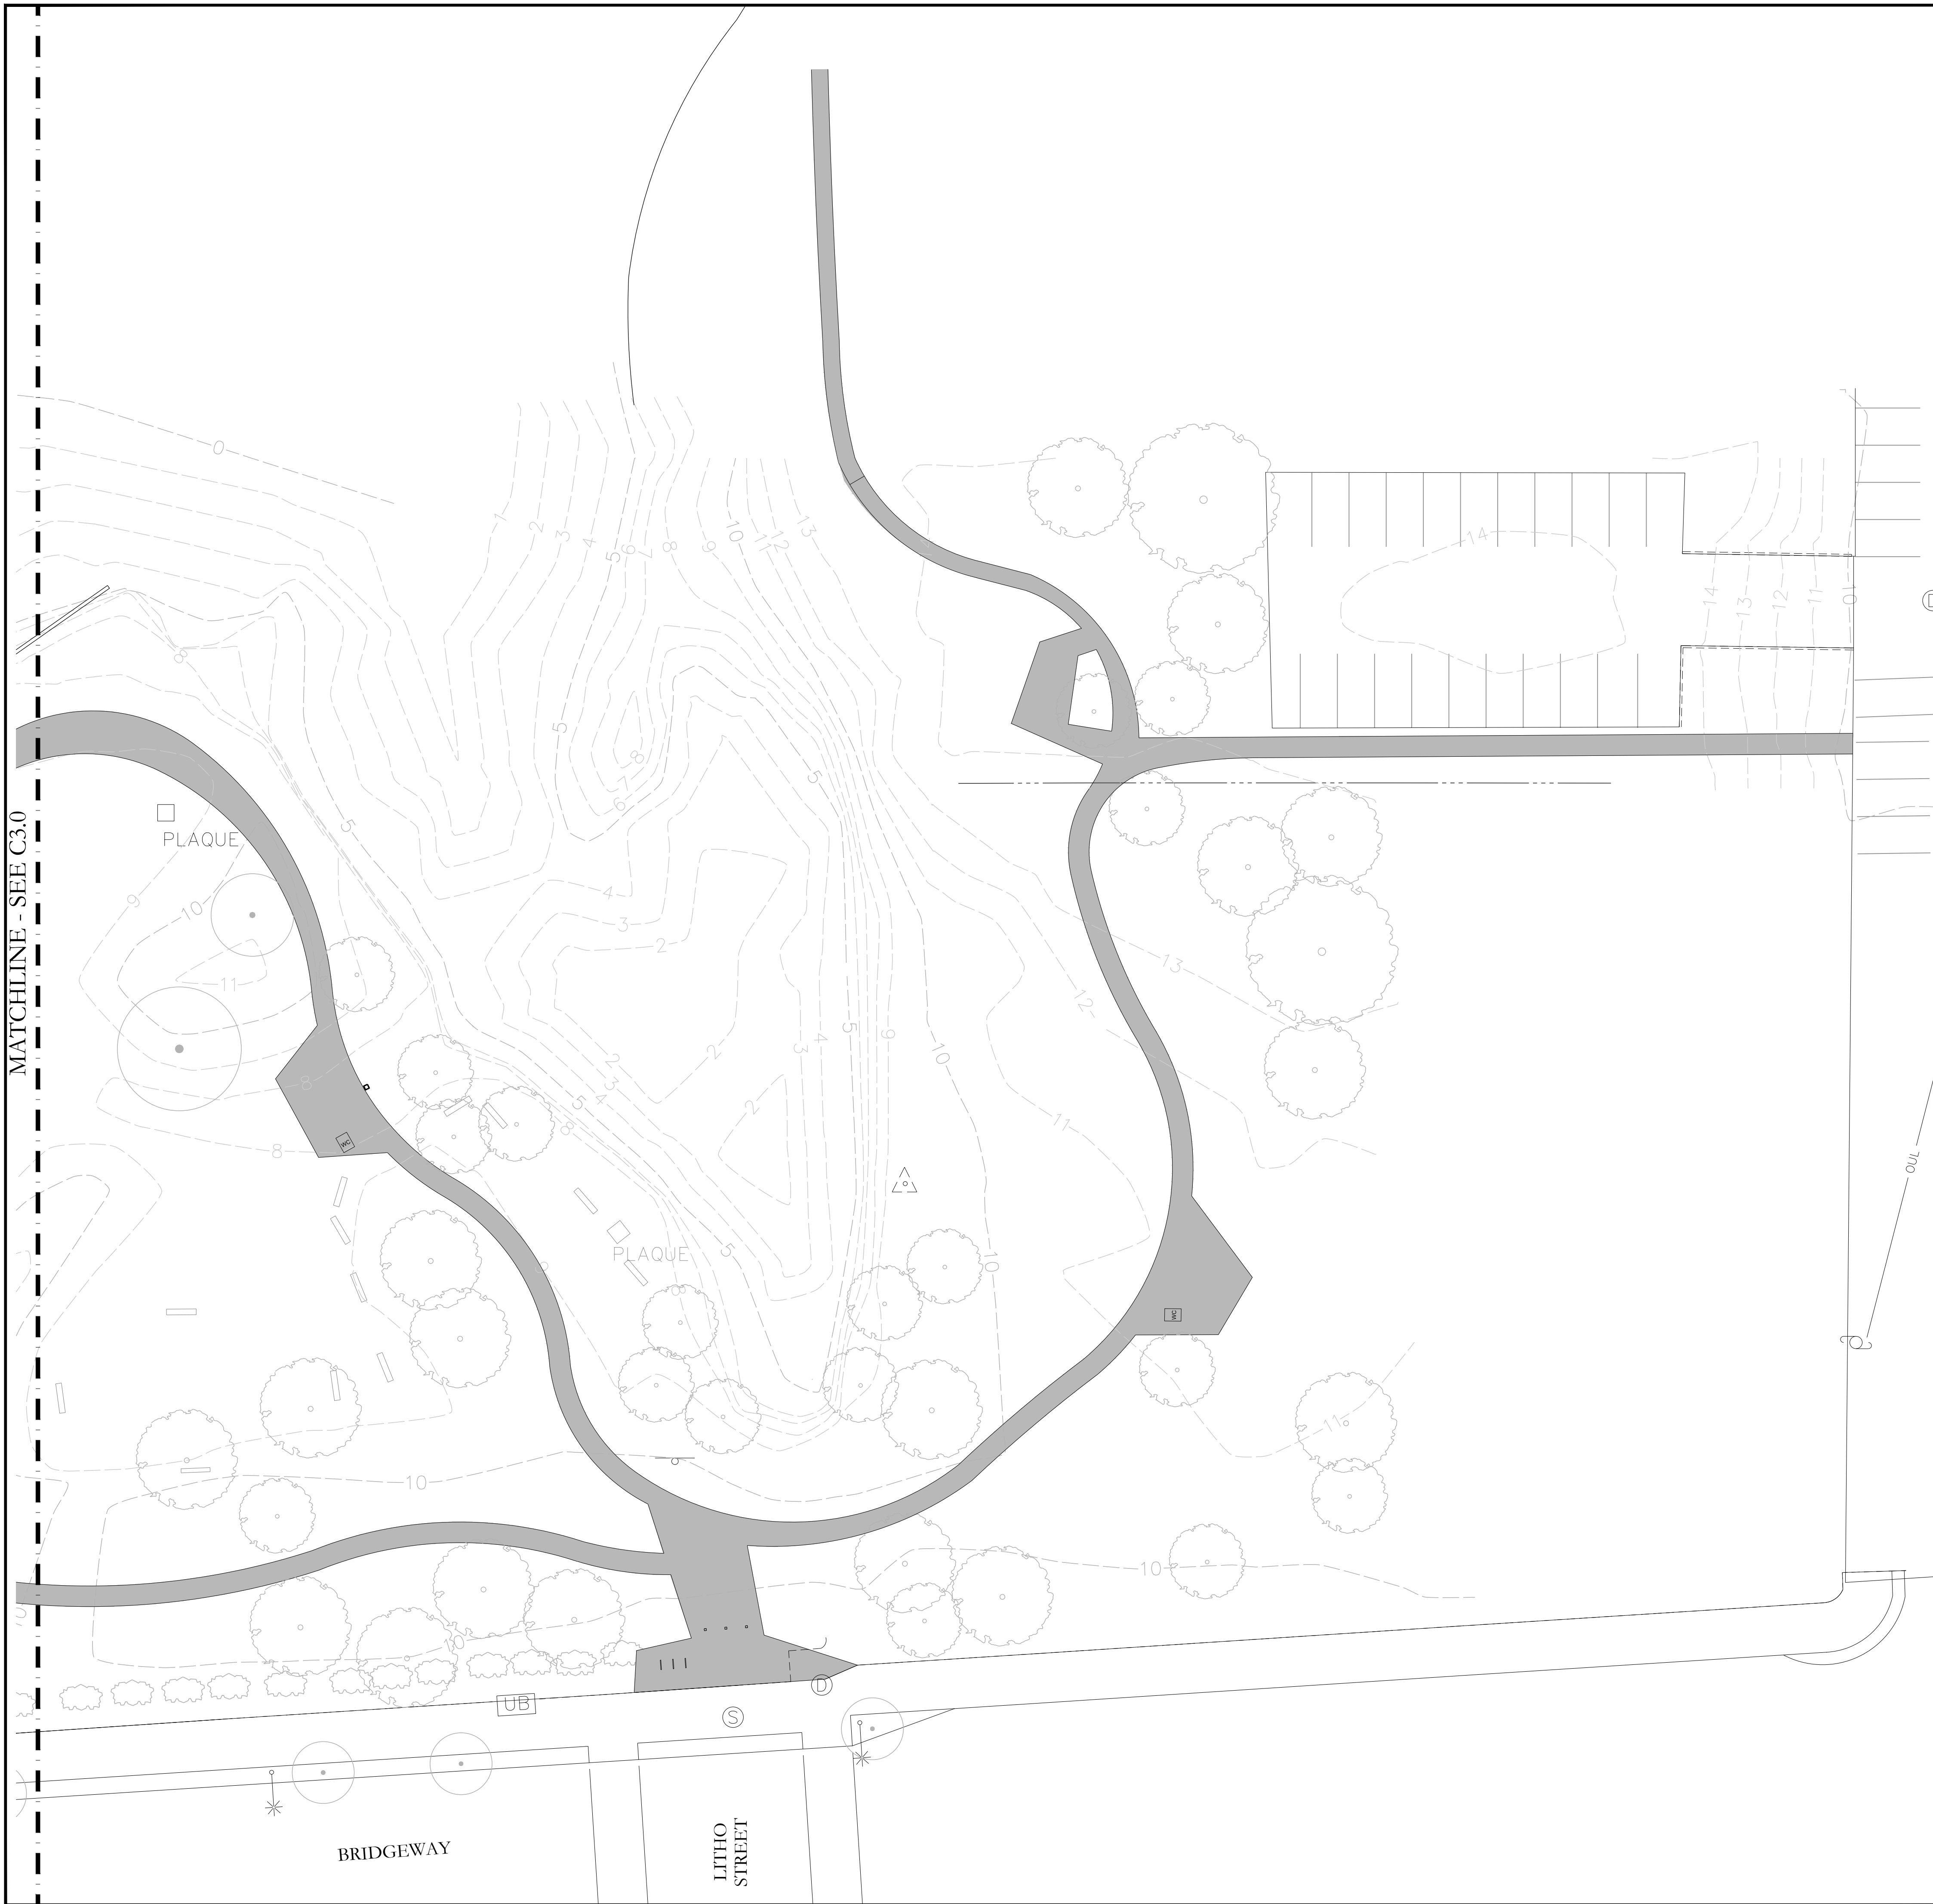

**Underground Service Alert**

Call: TOLL FREE  
1-800-227-2600

TWO WORKING DAYS BEFORE YOU DIG

PROJECT/CLIENT NAME

Dunphy Park  
Improvement Project


200 Napa Street  
Sausalito, CA 94965

Owner:  
City of Sausalito  
420 Litho St.  
Sausalito, CA 94965


RHAA PROJECT NUMBER

16042A


CONSULTANT

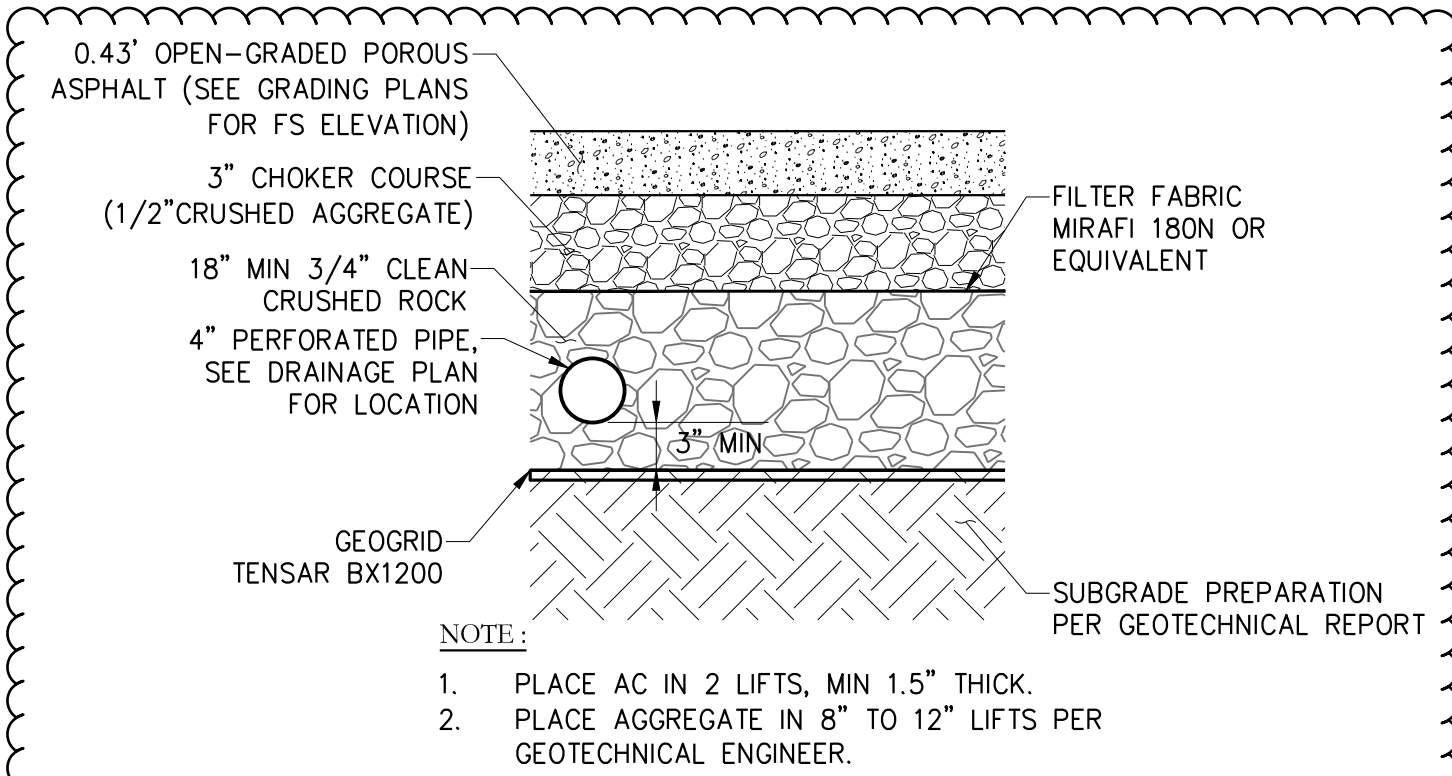


A POROUS ASPHALT PAVEMENT

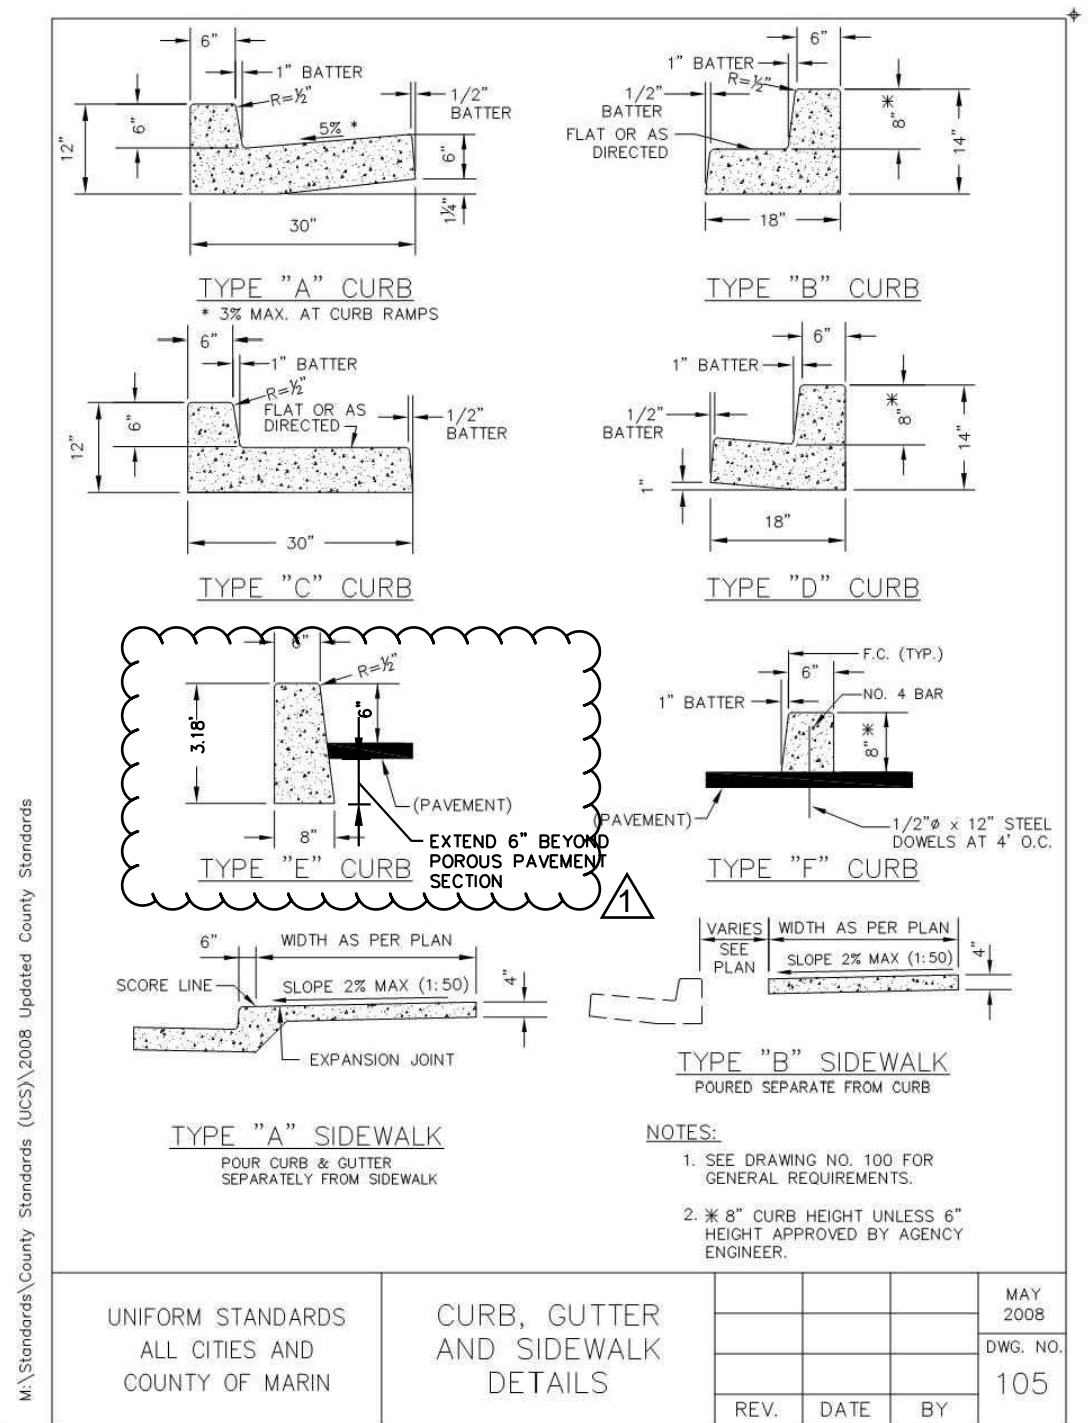


B CURB & GUTTER

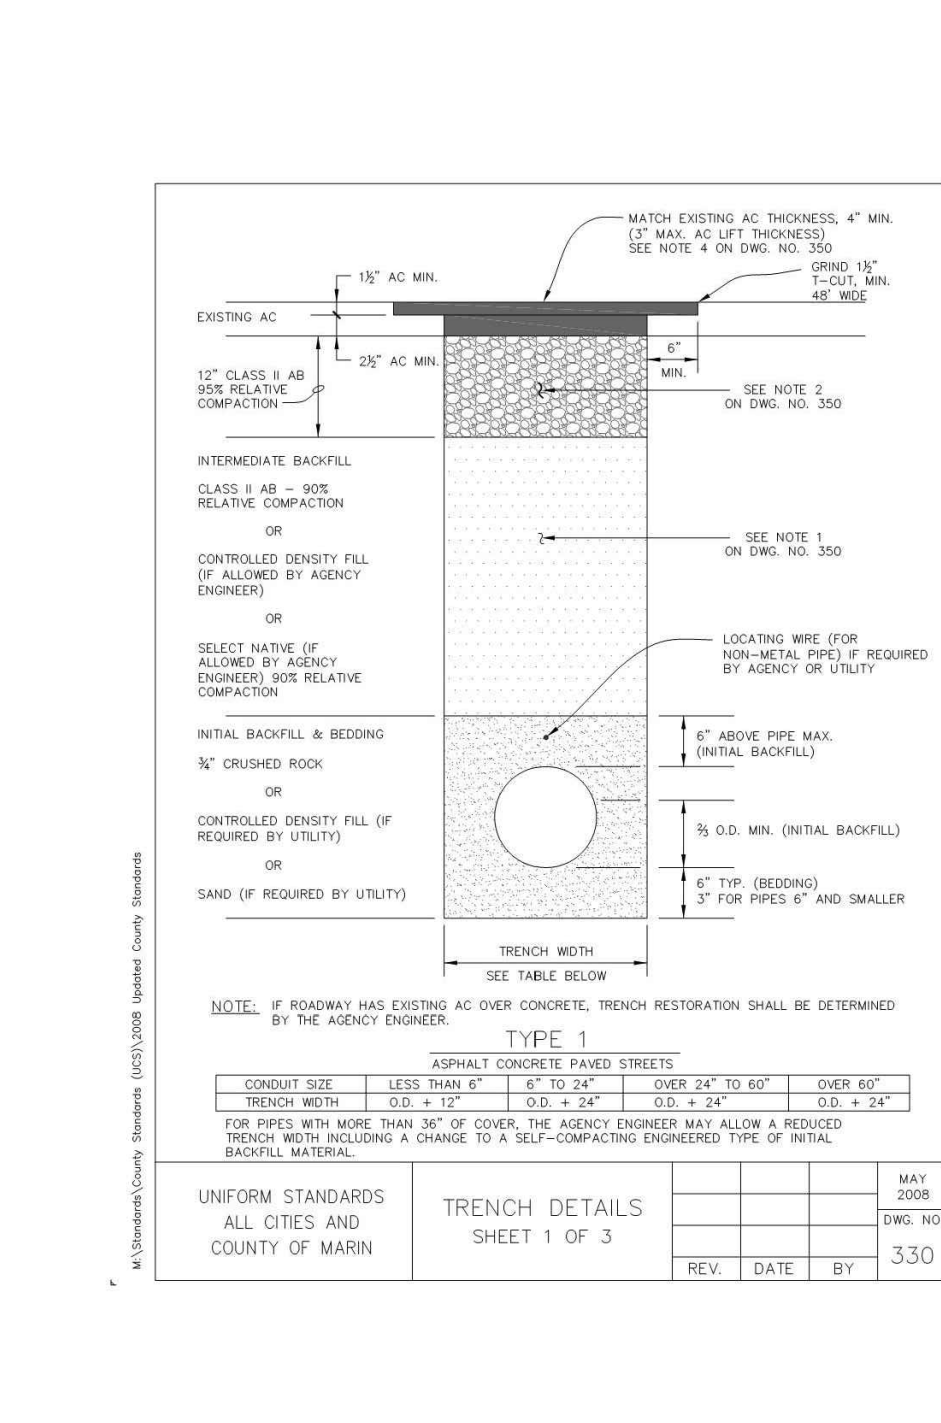


C TRENCH DETAILS

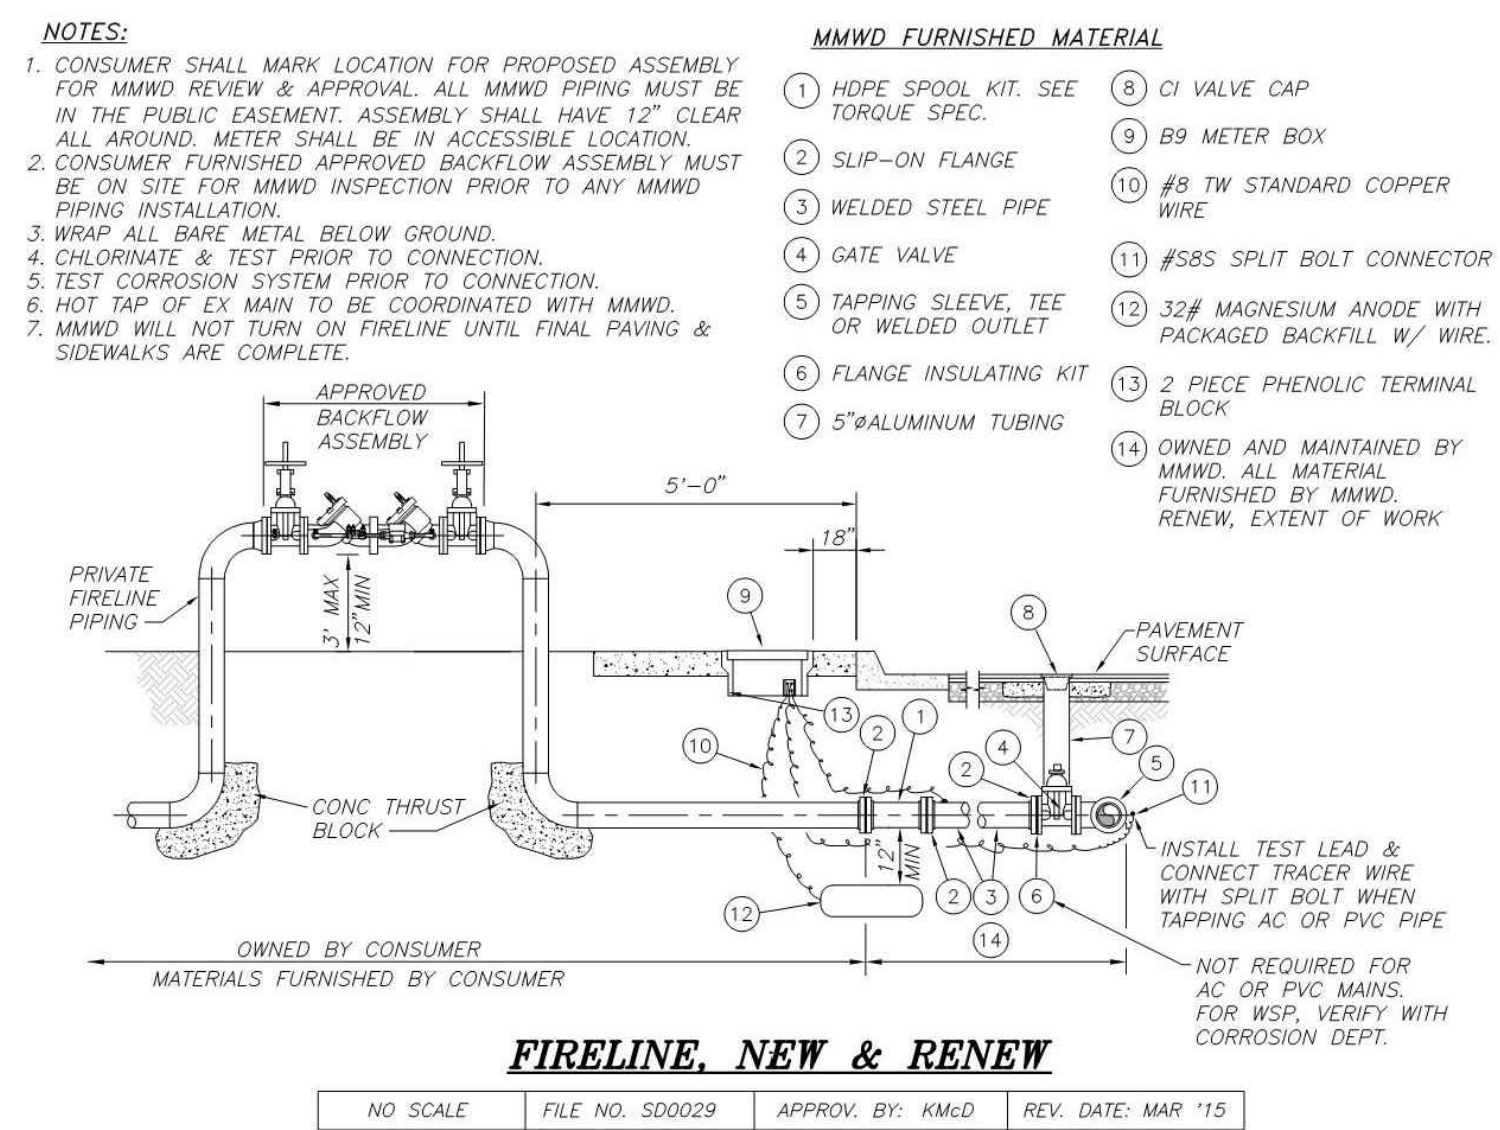


D FIRE SERVICE CONNECTION

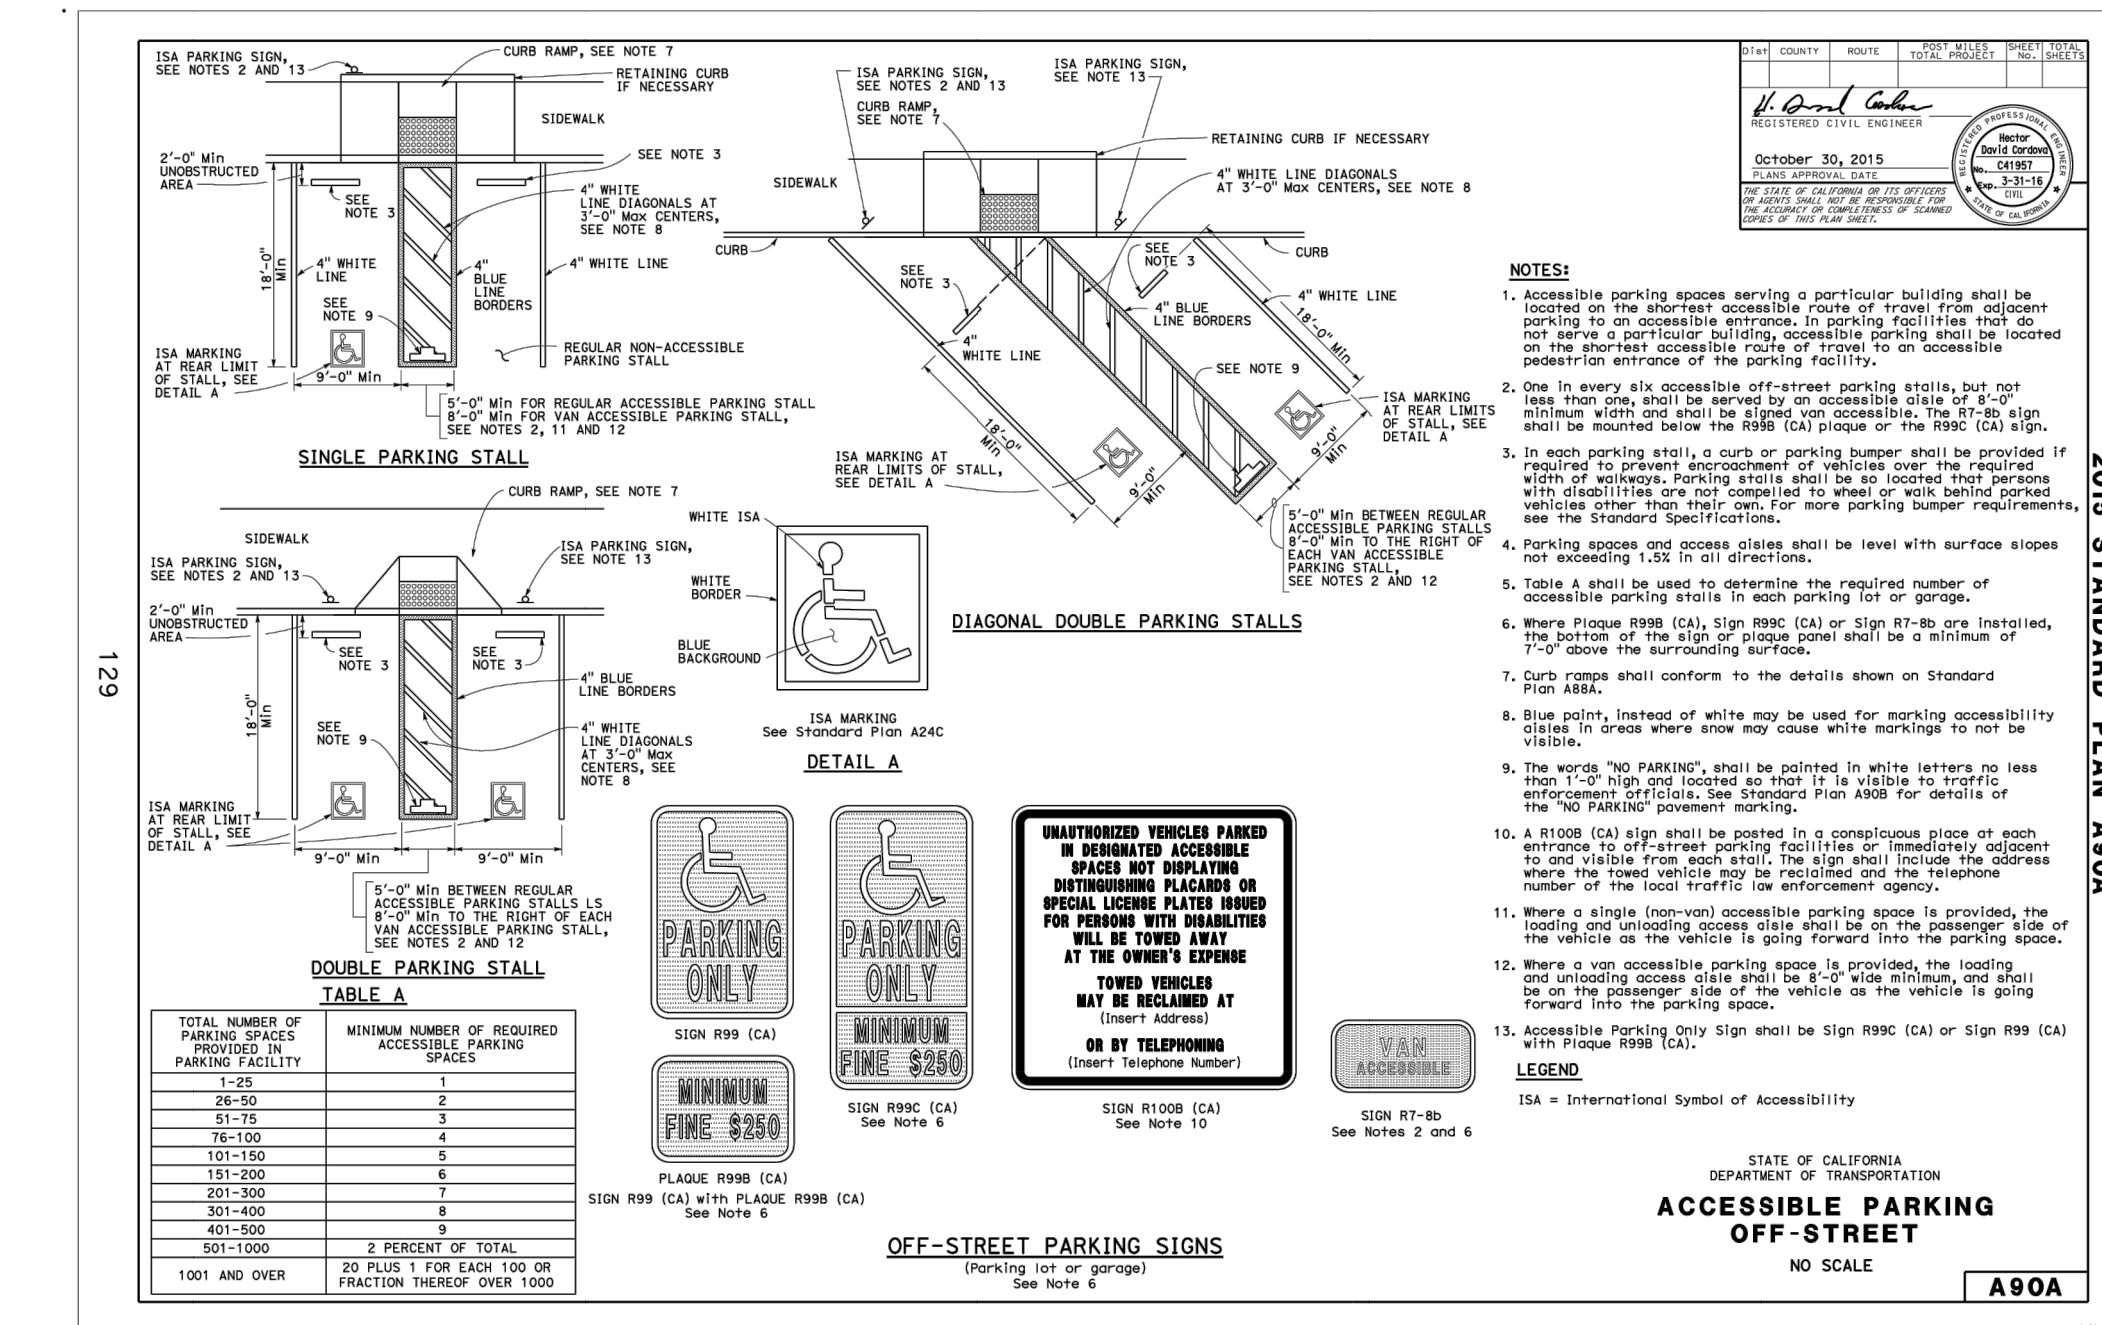


E ADA DETAILS

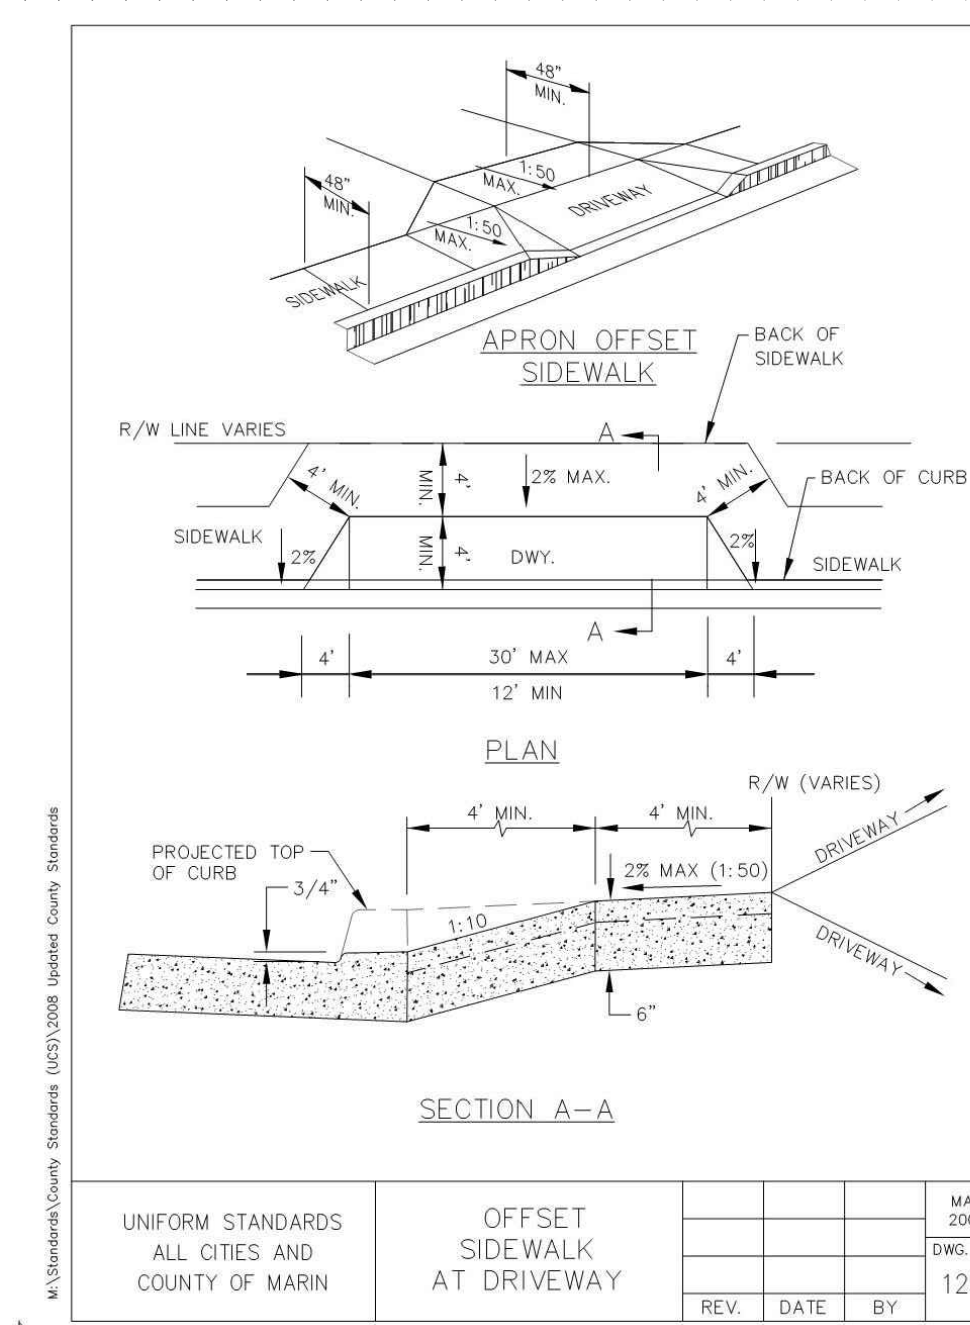


F DRIVEWAY APPROACH

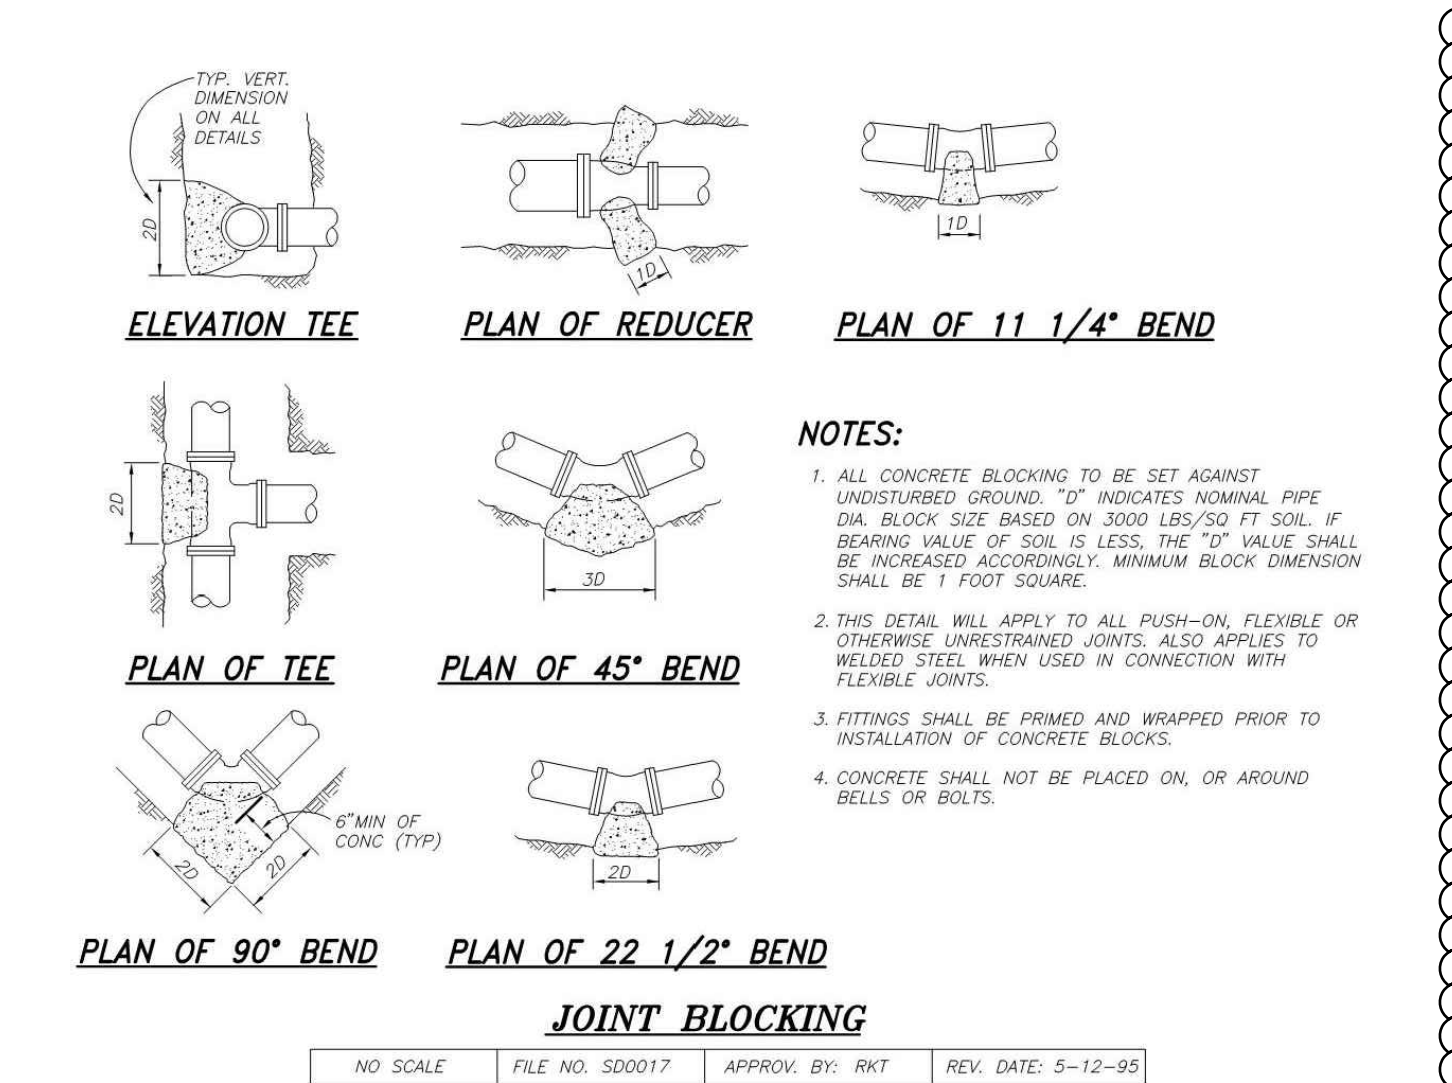


G THRUST BLOCK

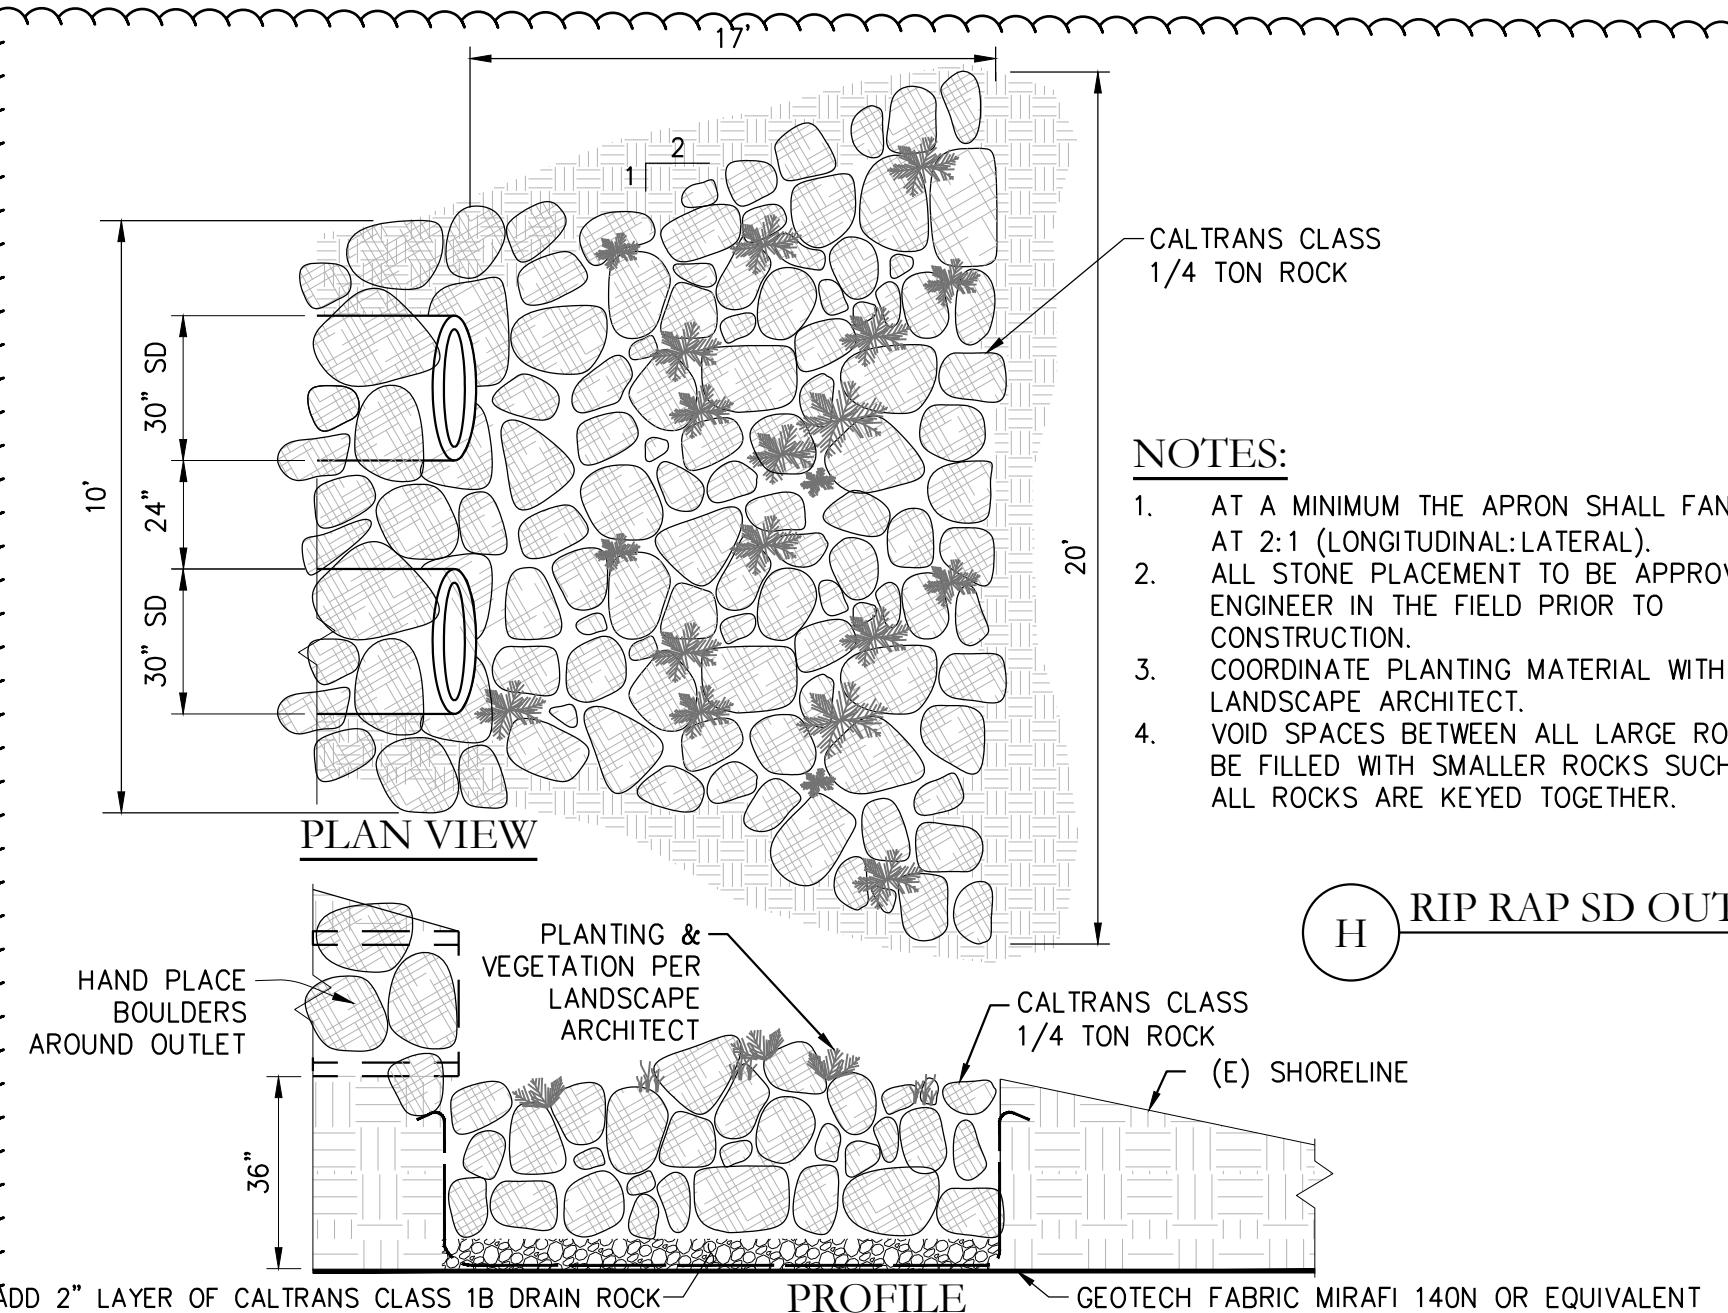

H RIP RAP SD OUTFALL

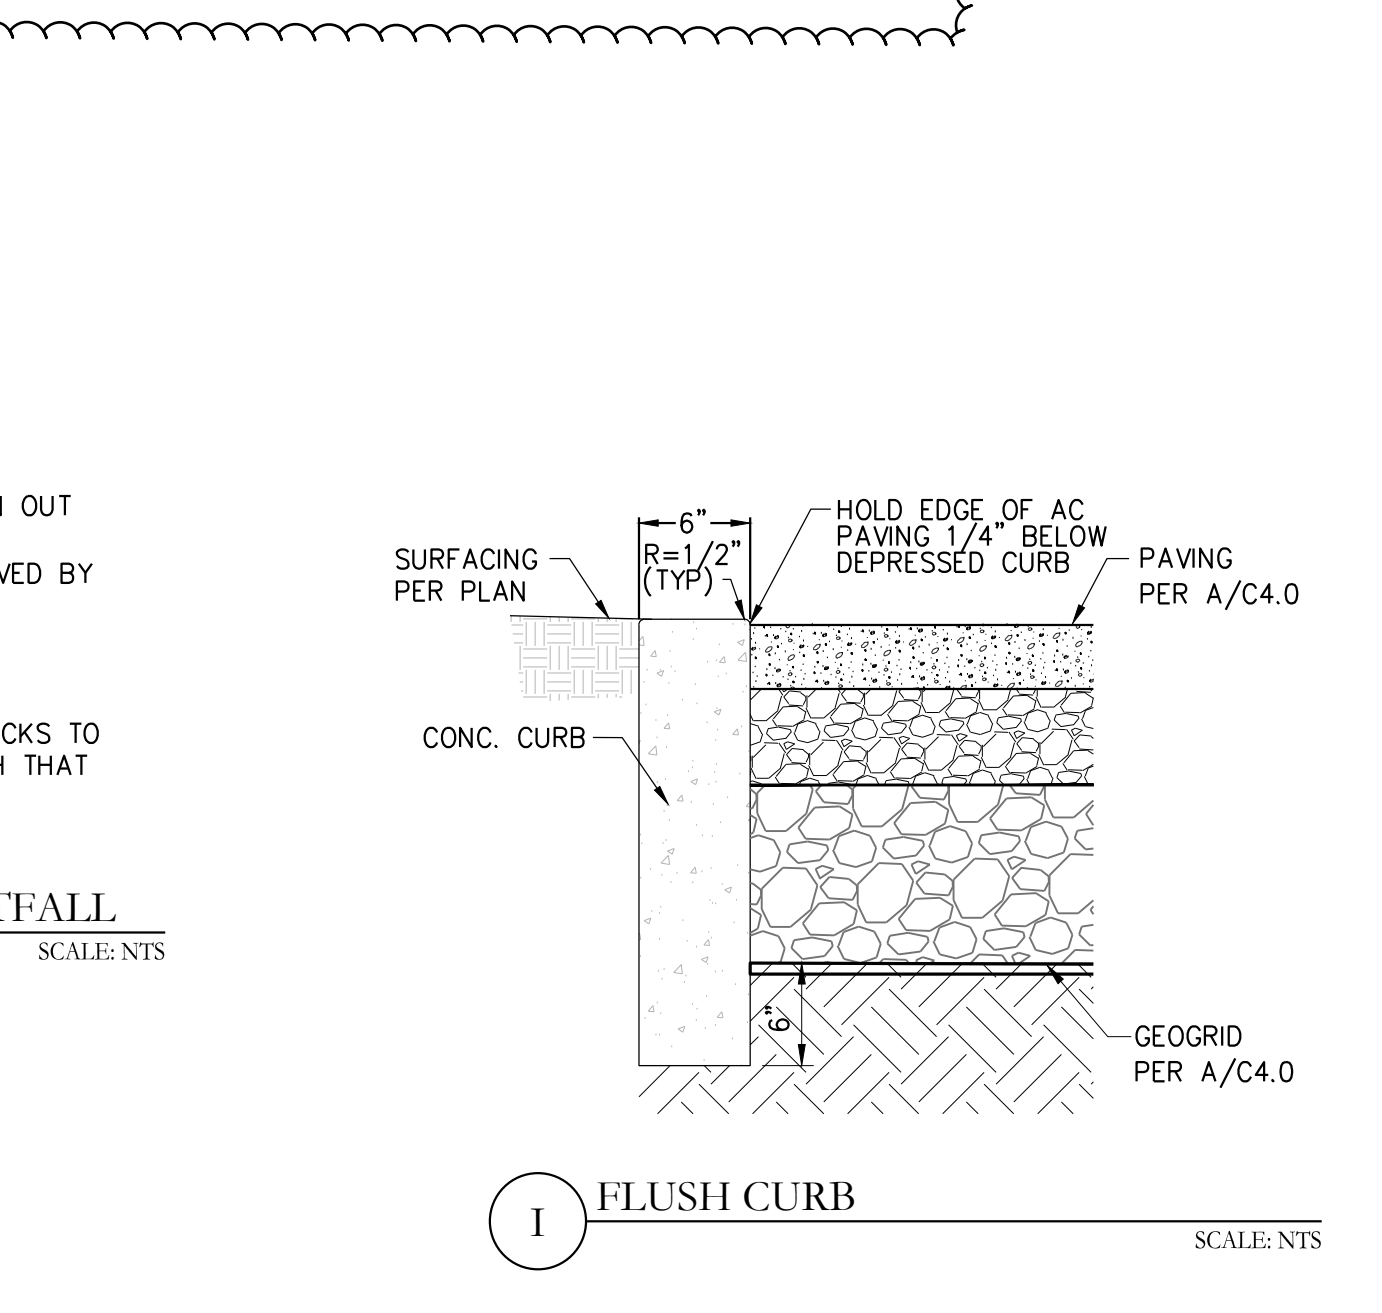

I FLUSH CURB

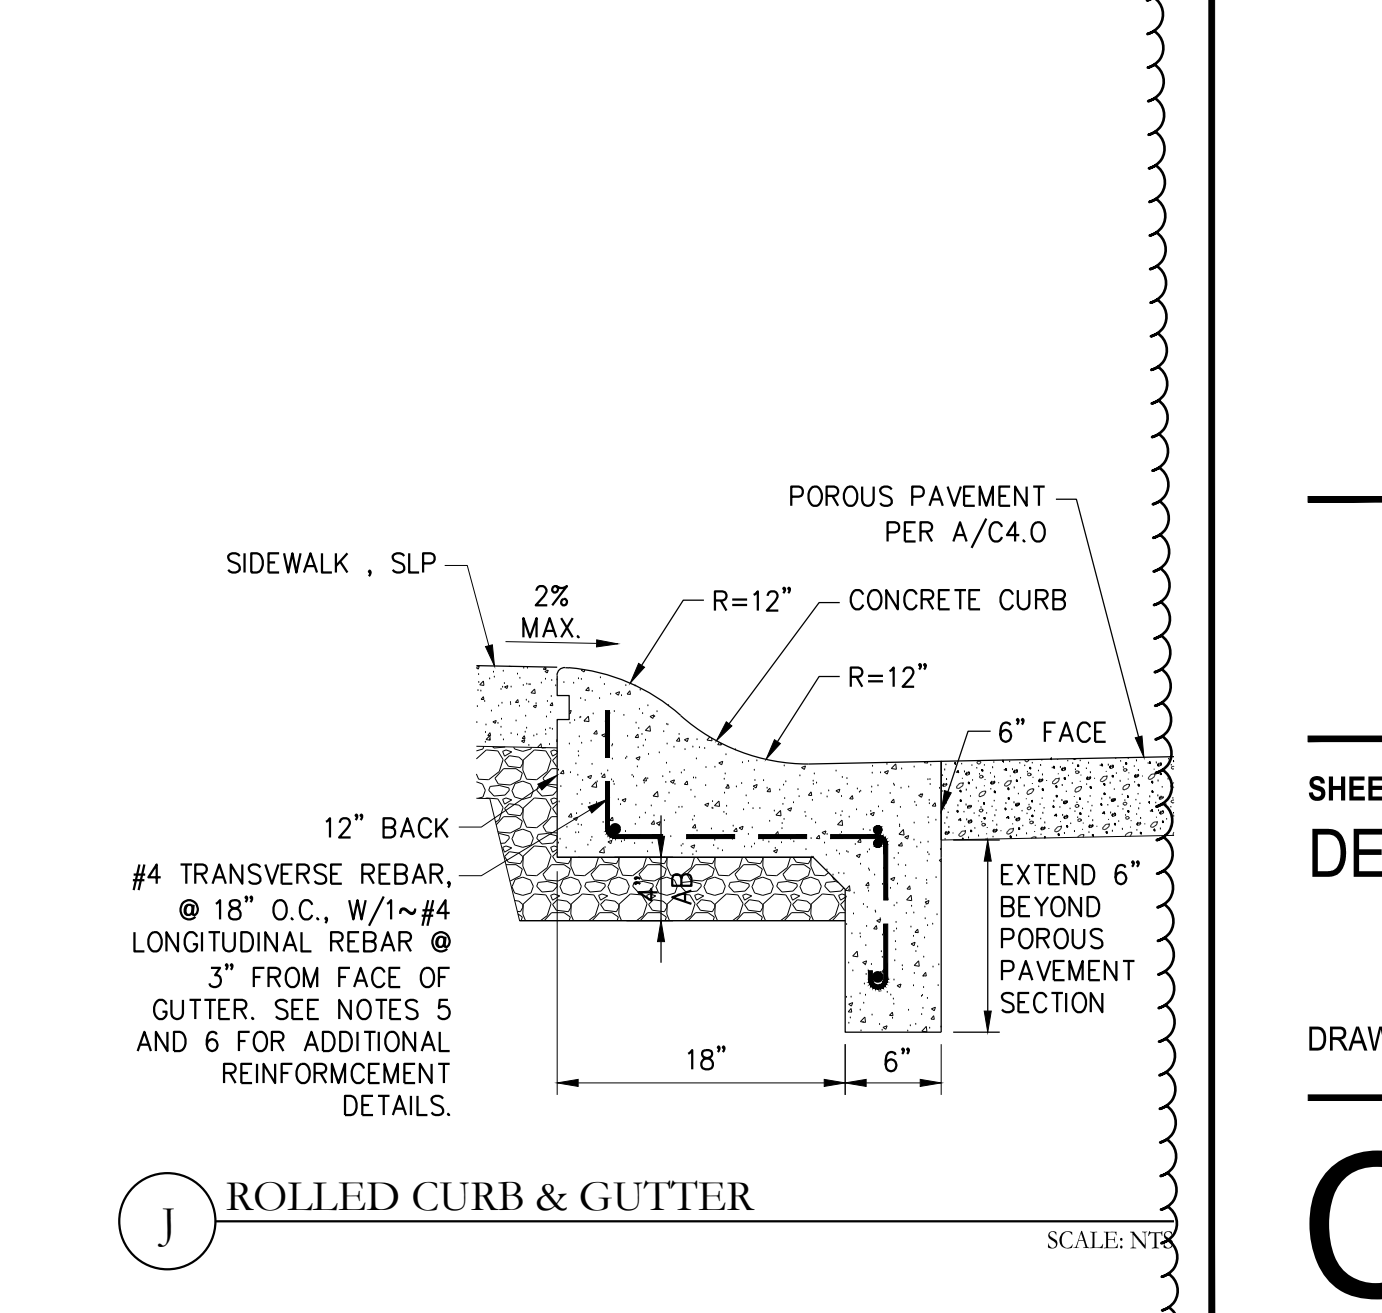

J ROLLED CURB & GUTTER

SUBMITTAL

Permit Submittal

DATE  
21 August 2017

REVISIONS

No.	Date	Description
Δ	9-18-2017	Permit Plan Check Response

REGISTRATION AND SIGNATURE



SHEET TITLE  
DETAILS

DRAWN BY: JG CHECKED BY: MW

# C4.0

PROJECT/CLIENT NAME

Dunphy Park Improvement Project

200 Napa Street  
Sausalito, CA 94965

Owner:  
City of Sausalito  
420 Litho St.  
Sausalito, CA 94965

RHAA PROJECT NUMBER

16042A

CONSULTANT

SUBMITTAL

Permit Submittal

DATE  
21 August 2017

REVISIONS

No.	Date	Description
1	9-18-2017	Permit Plan Check Response


REGISTRATION AND SIGNATURE




SHEET TITLE  
DETAILS

DRAWN BY: JG CHECKED BY: MW


# C4.1

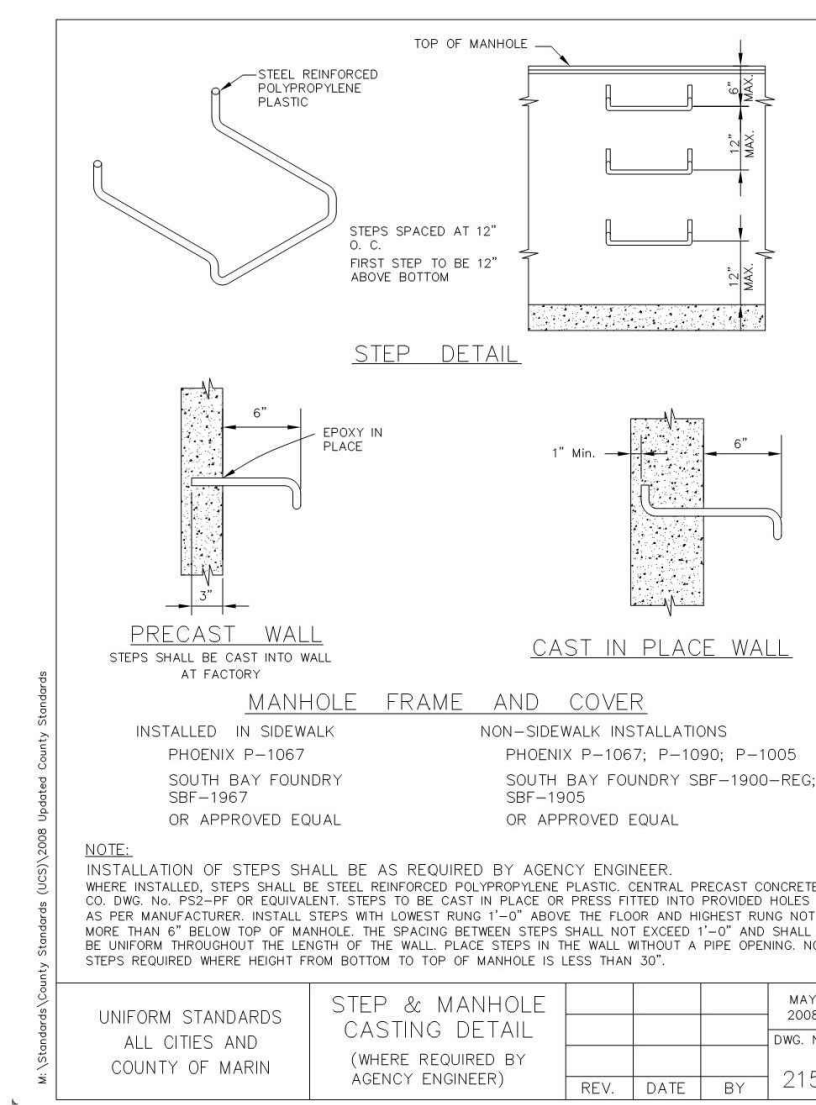


D STORM DRAIN STEP & MANHOLE CASTING DETAIL SCALE: NTS

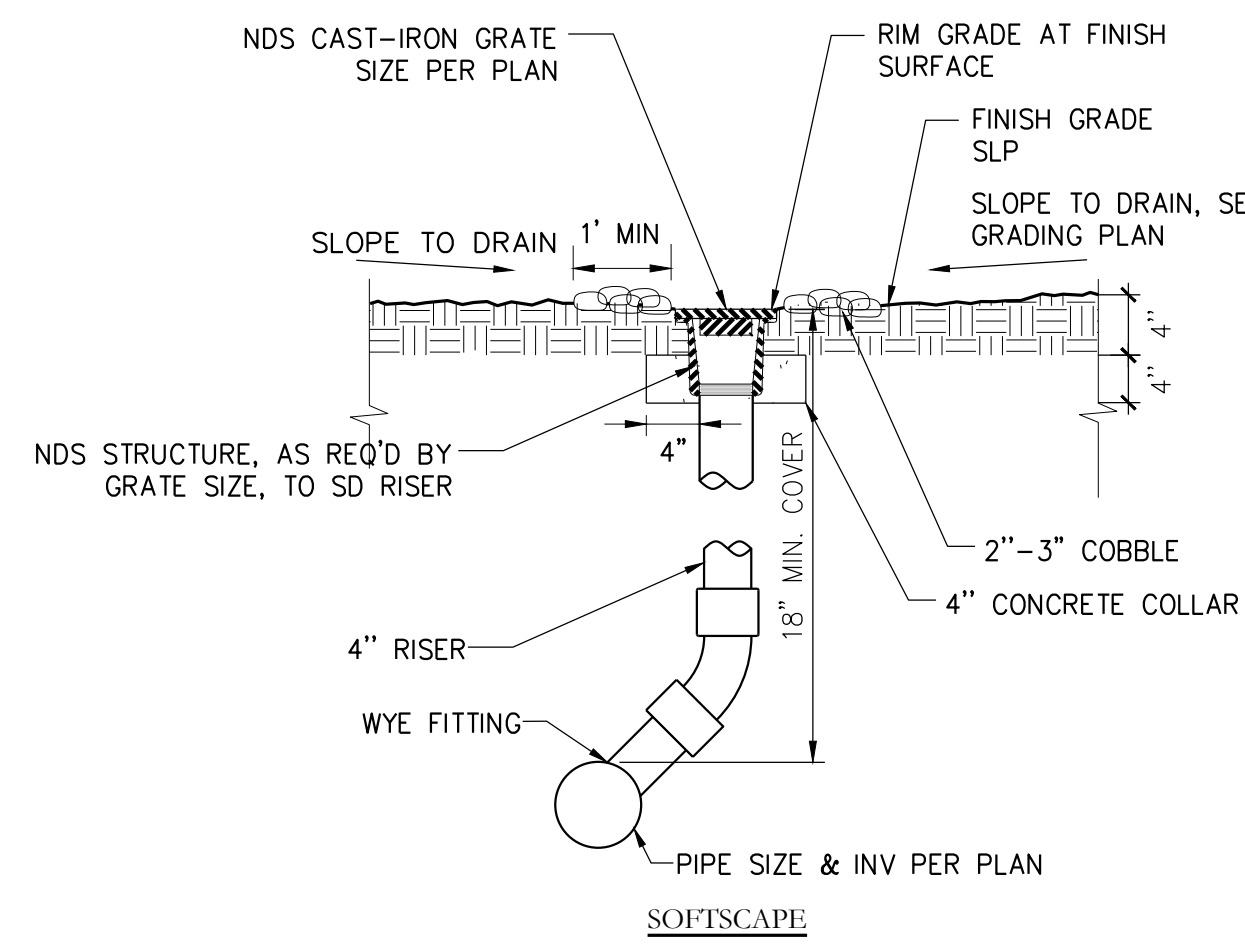


SCALE: NTS

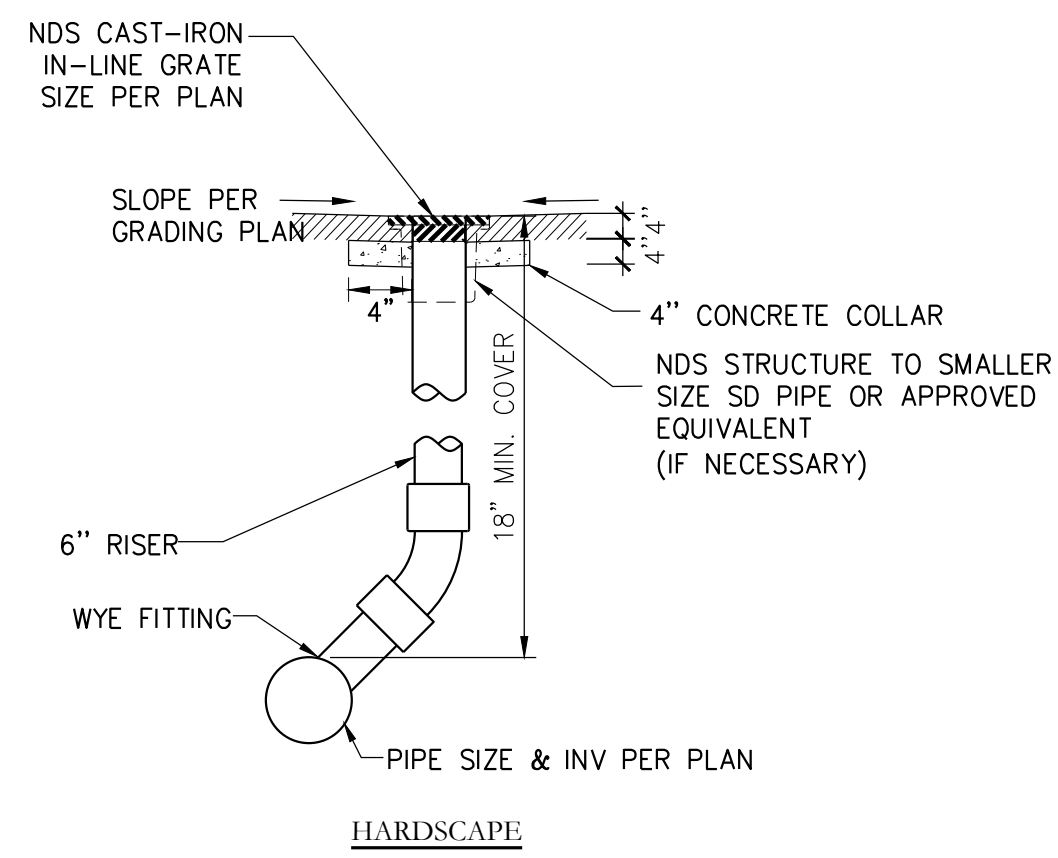


B HARDSCAPE AND SOFTSCAPE AREA DRAIN SCALE: NTS

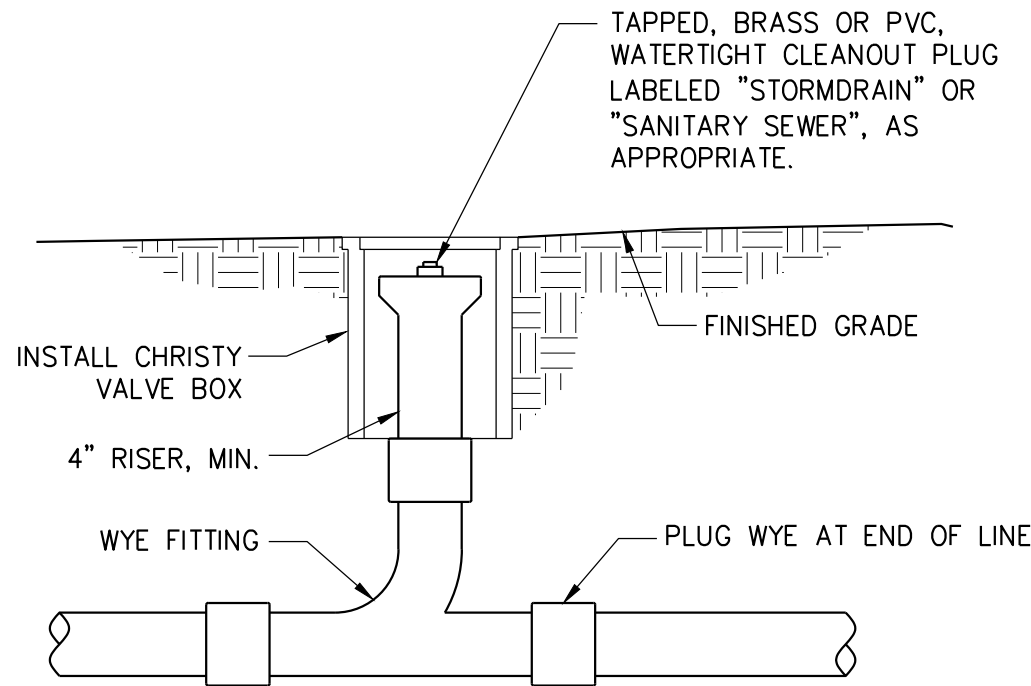

A STORM DRAIN CLEANOUT SCALE: NTS

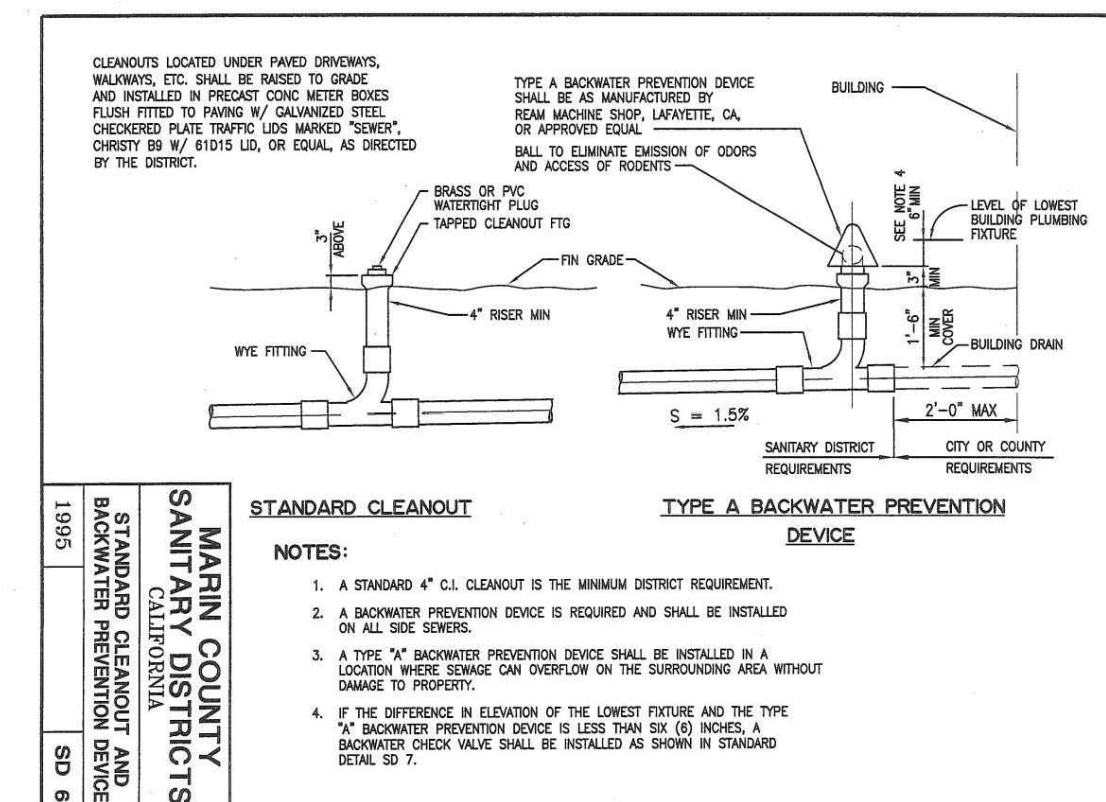

E SANITARY SEWER CLEANOUT SCALE: NTS

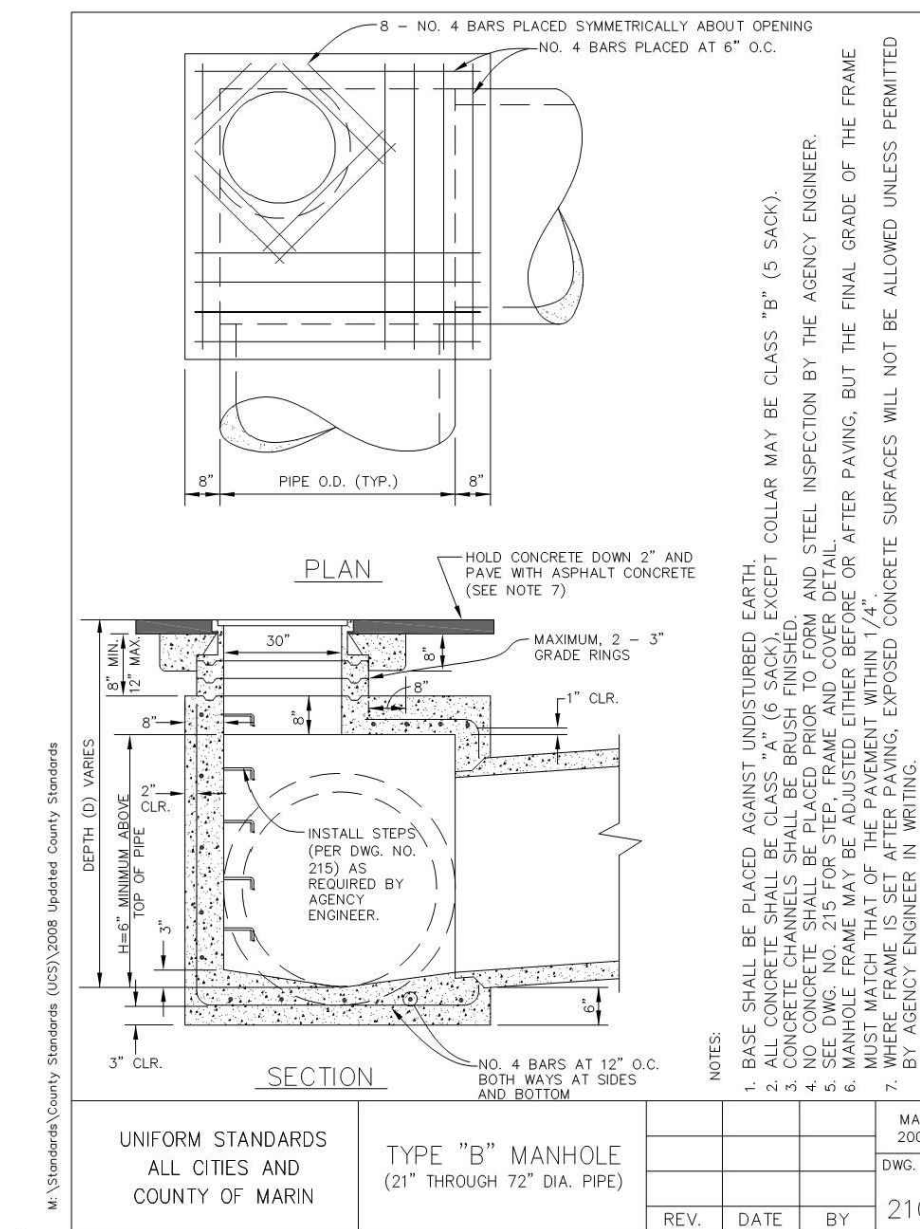

F STORM DRAIN MANHOLE TYPE B SCALE: NTS


NOTES:

- FRAME AND GRATES MAY BE SPECIFIED FOR PEDESTRIAN OR H20 TRAFFIC LOADING. ALL GRATES ARE BICYCLE PROOF. OPTION GRATE LOCKING DEVICE AVAILABLE ON REQUEST.
- INSTALL GRATE FLUSH WITH PROPOSED SURFACE PER DETAILS.
- DRAIN INLET TO BE OLD CASTLE PRECAST PRODUCTS, OR APPROVED EQUIVALENT.


DROP INLET TABLE

MODEL No.	CHK MODEL NAME	A IN	B IN	C IN	MM
CB1212	EK	12	300	12	300
CB1818	CK	18	450	18	450
CB1824	1K*	18	450	24	600
CB2424	2K	24	600	24	600
CB2430	3K	24	600	30	750
CB3030	5K	30	750	30	750
CB2436	1L	24	600	36	900
CB3636	1M	36	900	36	900
CB2448	3L	24	600	48	1200
CB3648	3M	36	900	48	1200
CB4848	1R	48	1200	48	1200


G TYPICAL SANITARY SEWER TRENCH SECTION SCALE: NTS

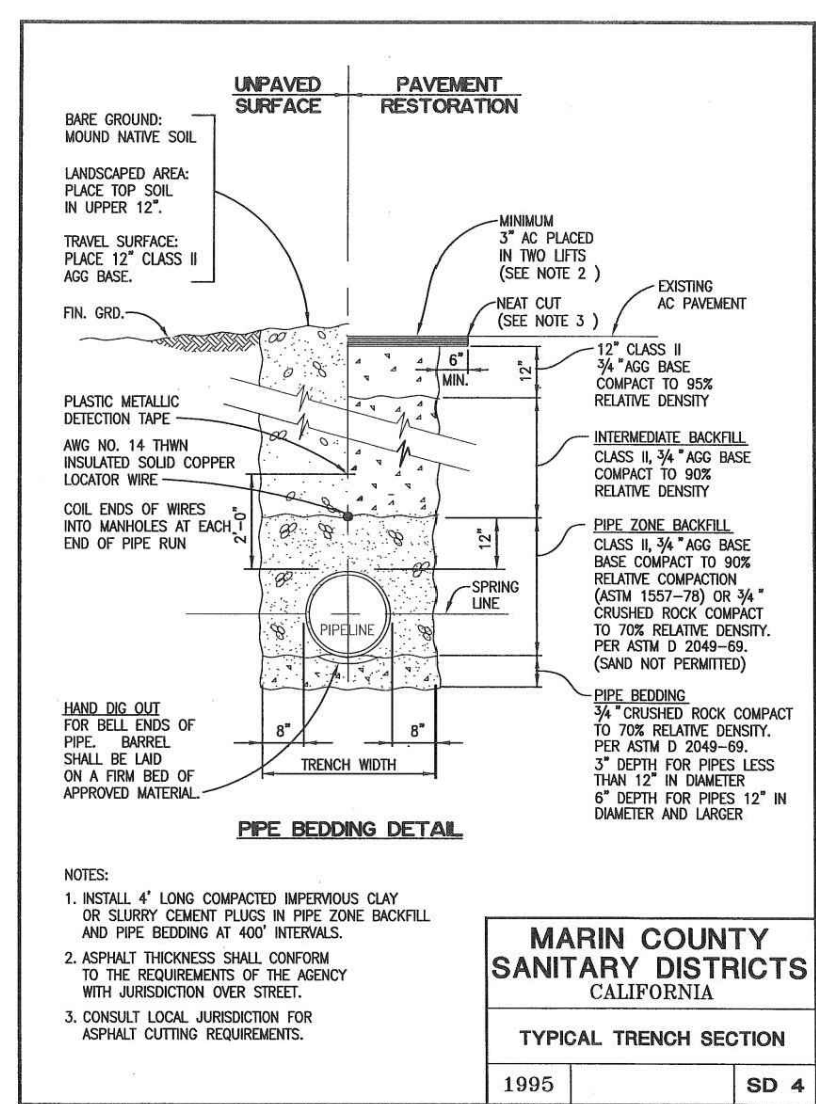

G TYPICAL SANITARY SEWER TRENCH SECTION SCALE: NTS

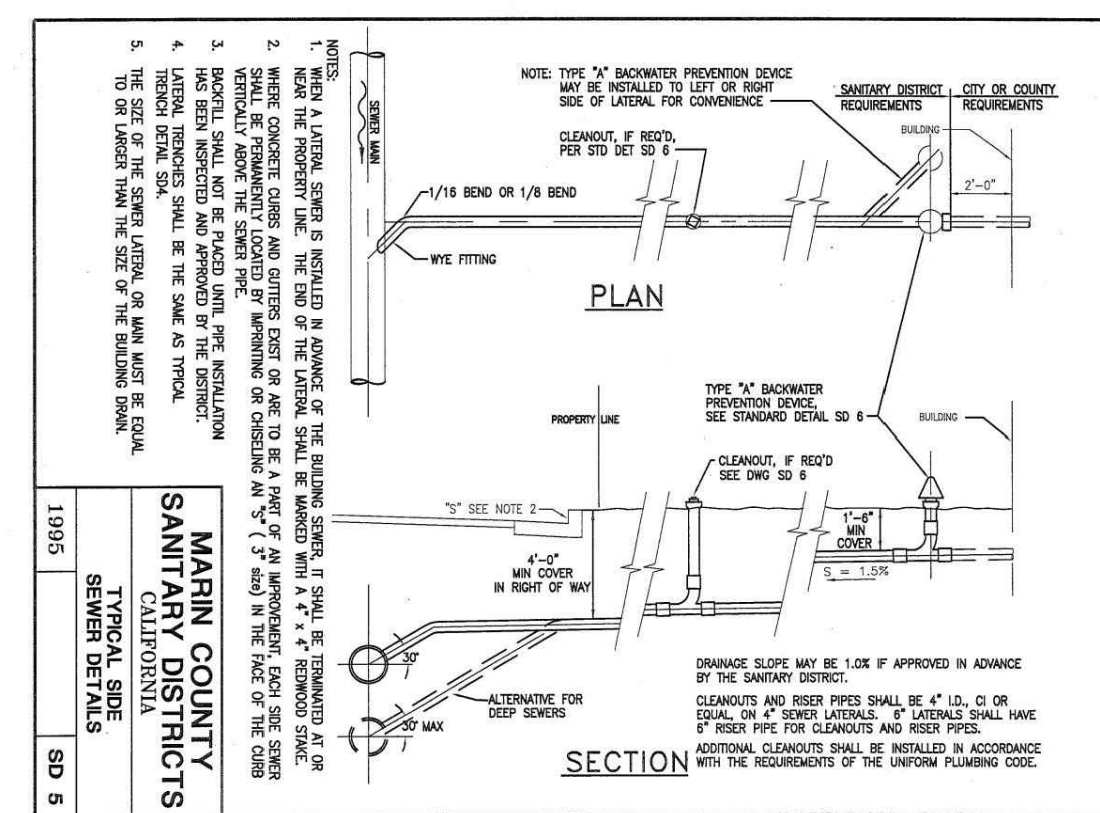

H TYPICAL SIDE SEWER DETAIL SCALE: NTS

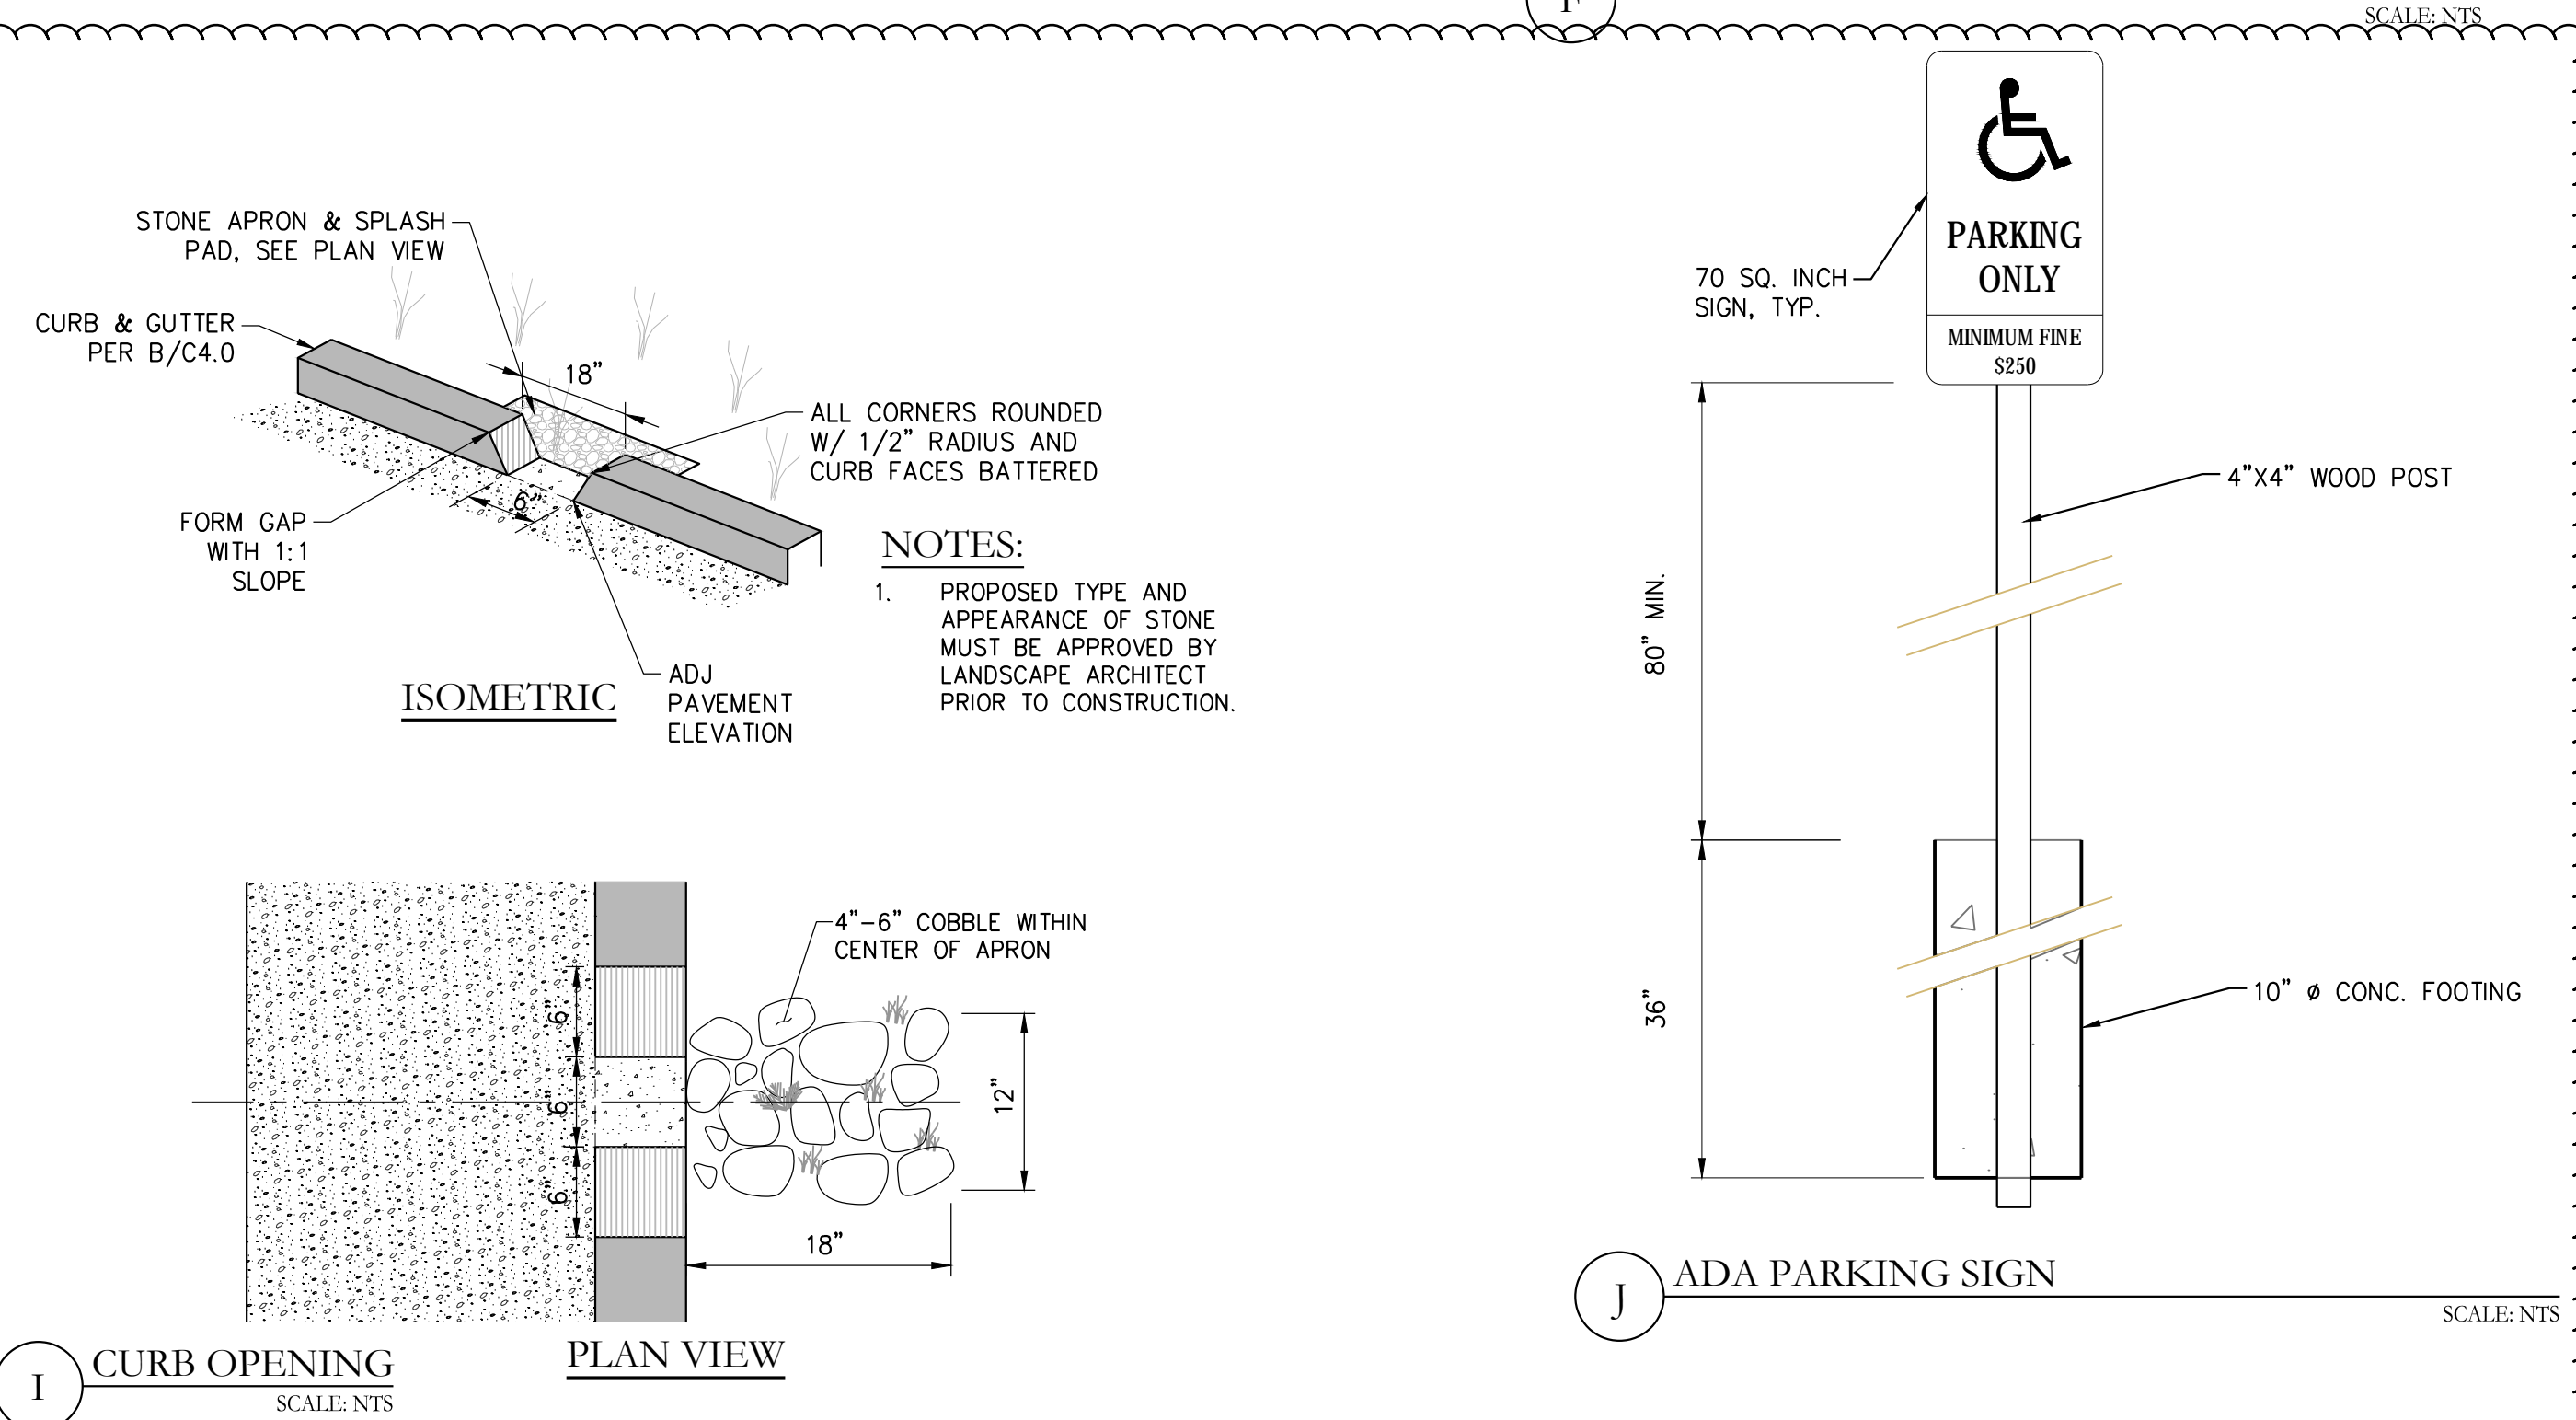

I CURB OPENING SCALE: NTS

J ADA PARKING SIGN SCALE: NTS

PROJECT/CLIENT NAME

Dunphy Park Improvement Project

200 Napa Street  
Sausalito, CA 94965

Owner:  
City of Sausalito  
420 Litho St.  
Sausalito, CA 94965

RHAA PROJECT NUMBER

16042A

CONSULTANT

SUBMITTAL


Permit Submittal

DATE  
21 August 2017

REVISIONS

No.	Date	Description
1	9-18-2017	Permit Plan Check Response




REGISTRATION AND SIGNATURE

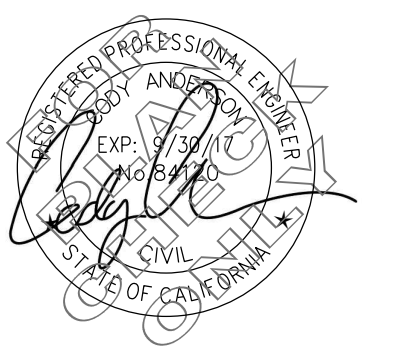

SHEET TITLE  
DETAILS

DRAWN BY: JG CHECKED BY: MW


# C4.2

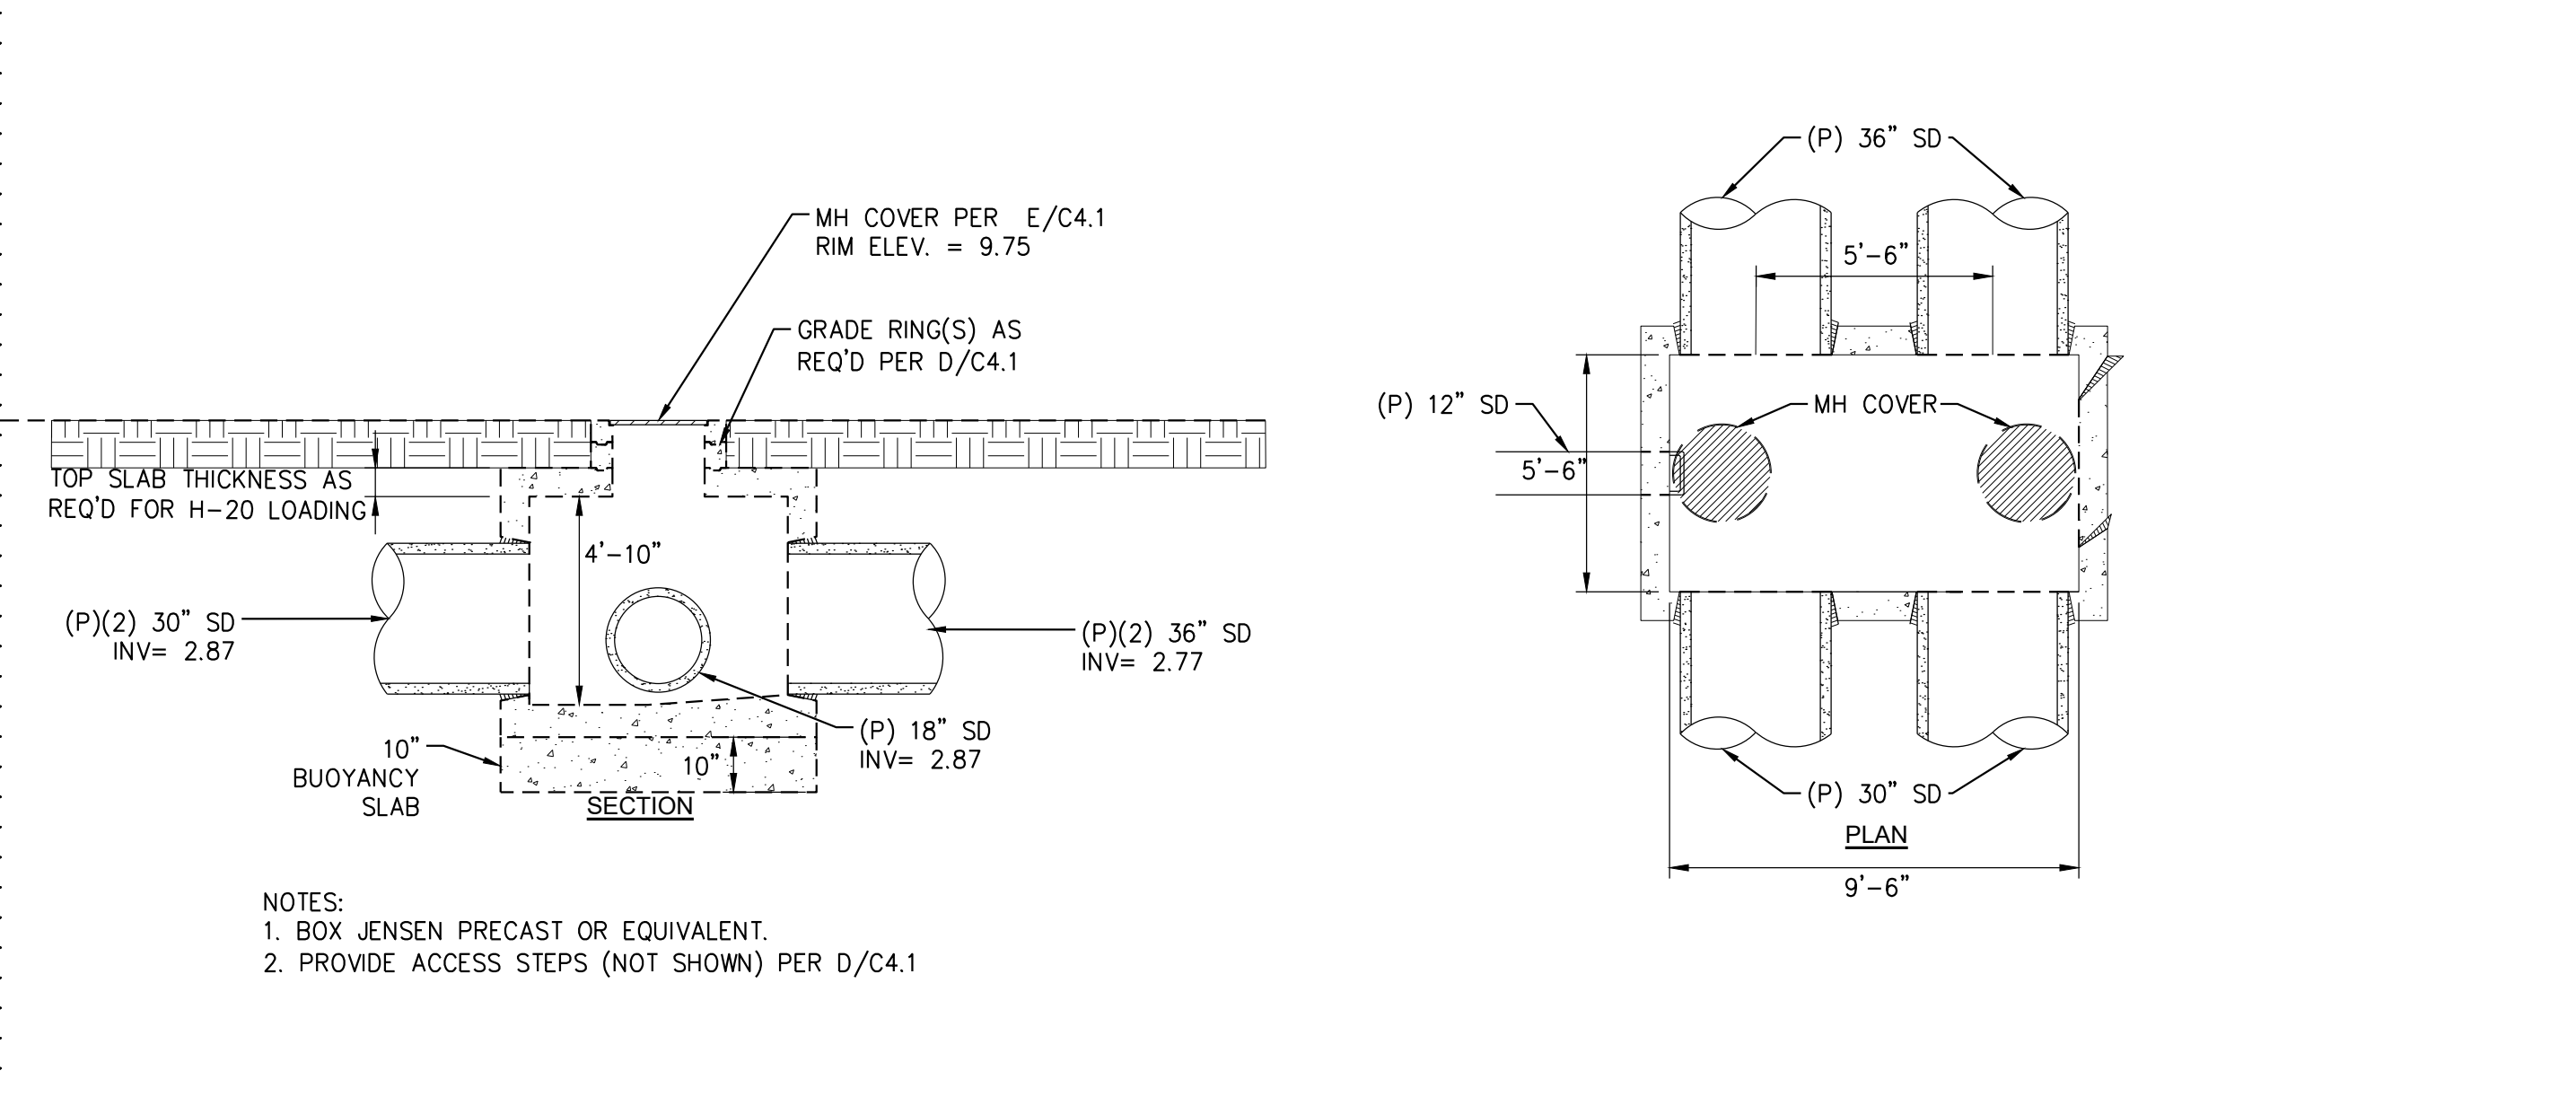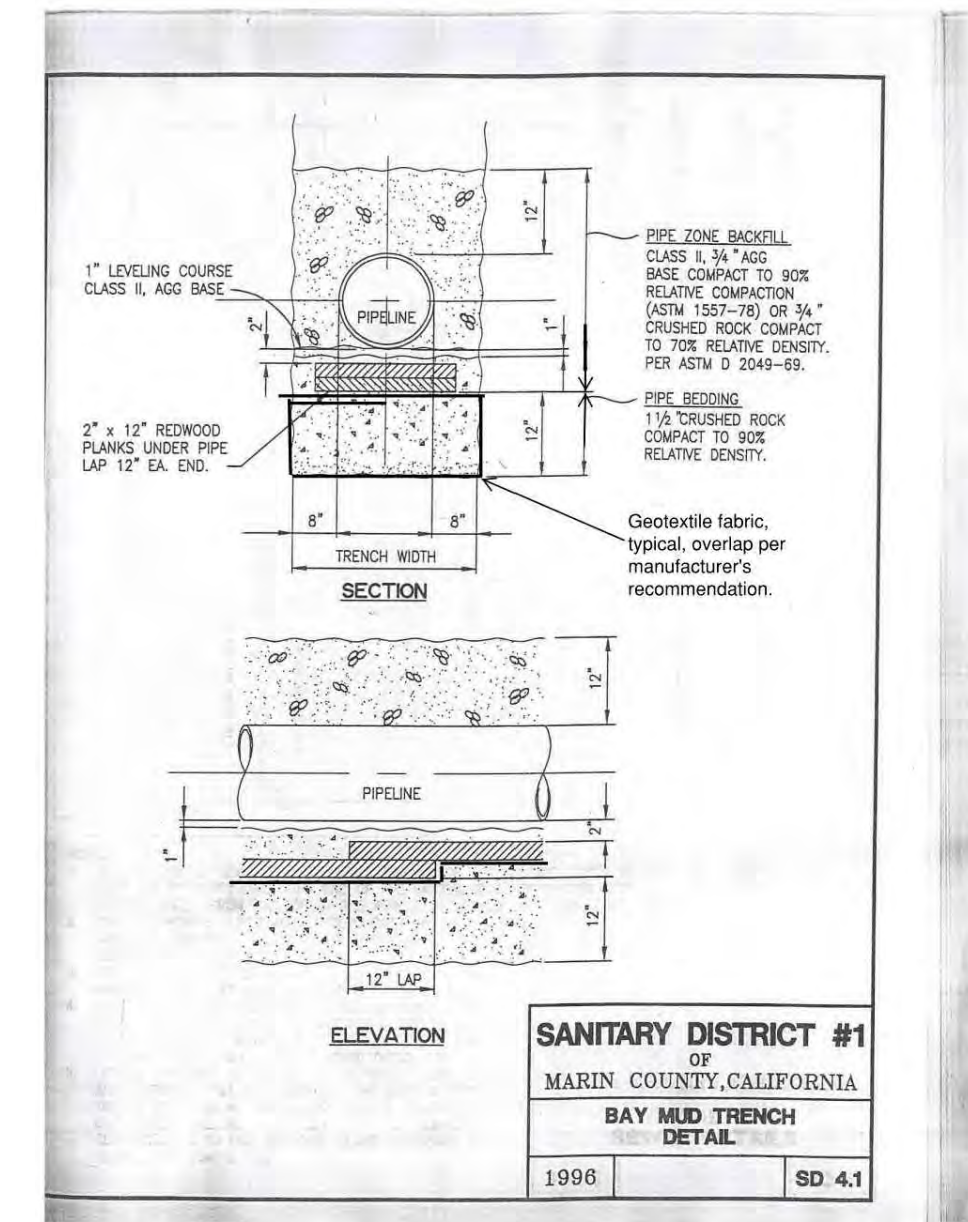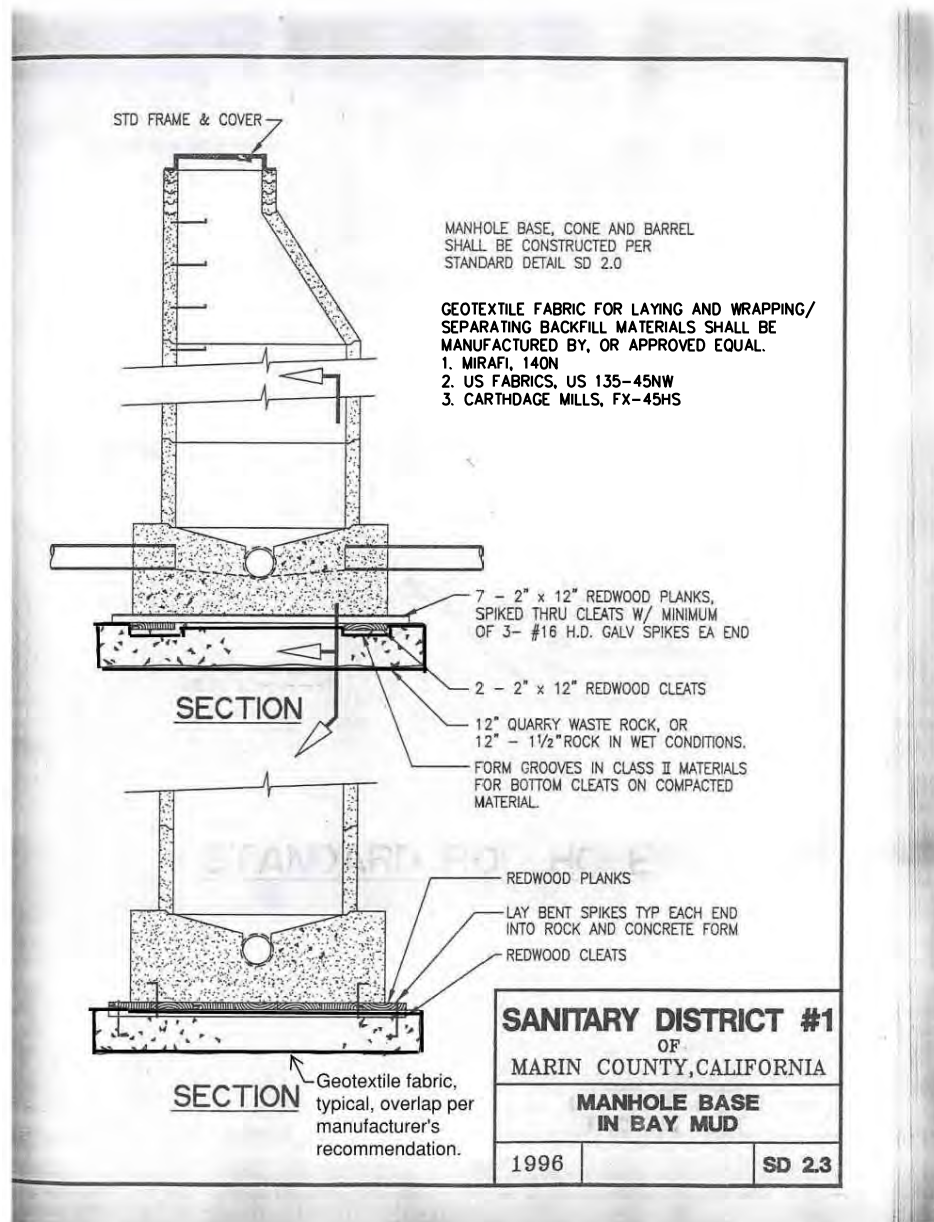


A JUNCTION BOX

B SEWER MANHOLE

C SEWER MANHOLE FRAME AND COVER

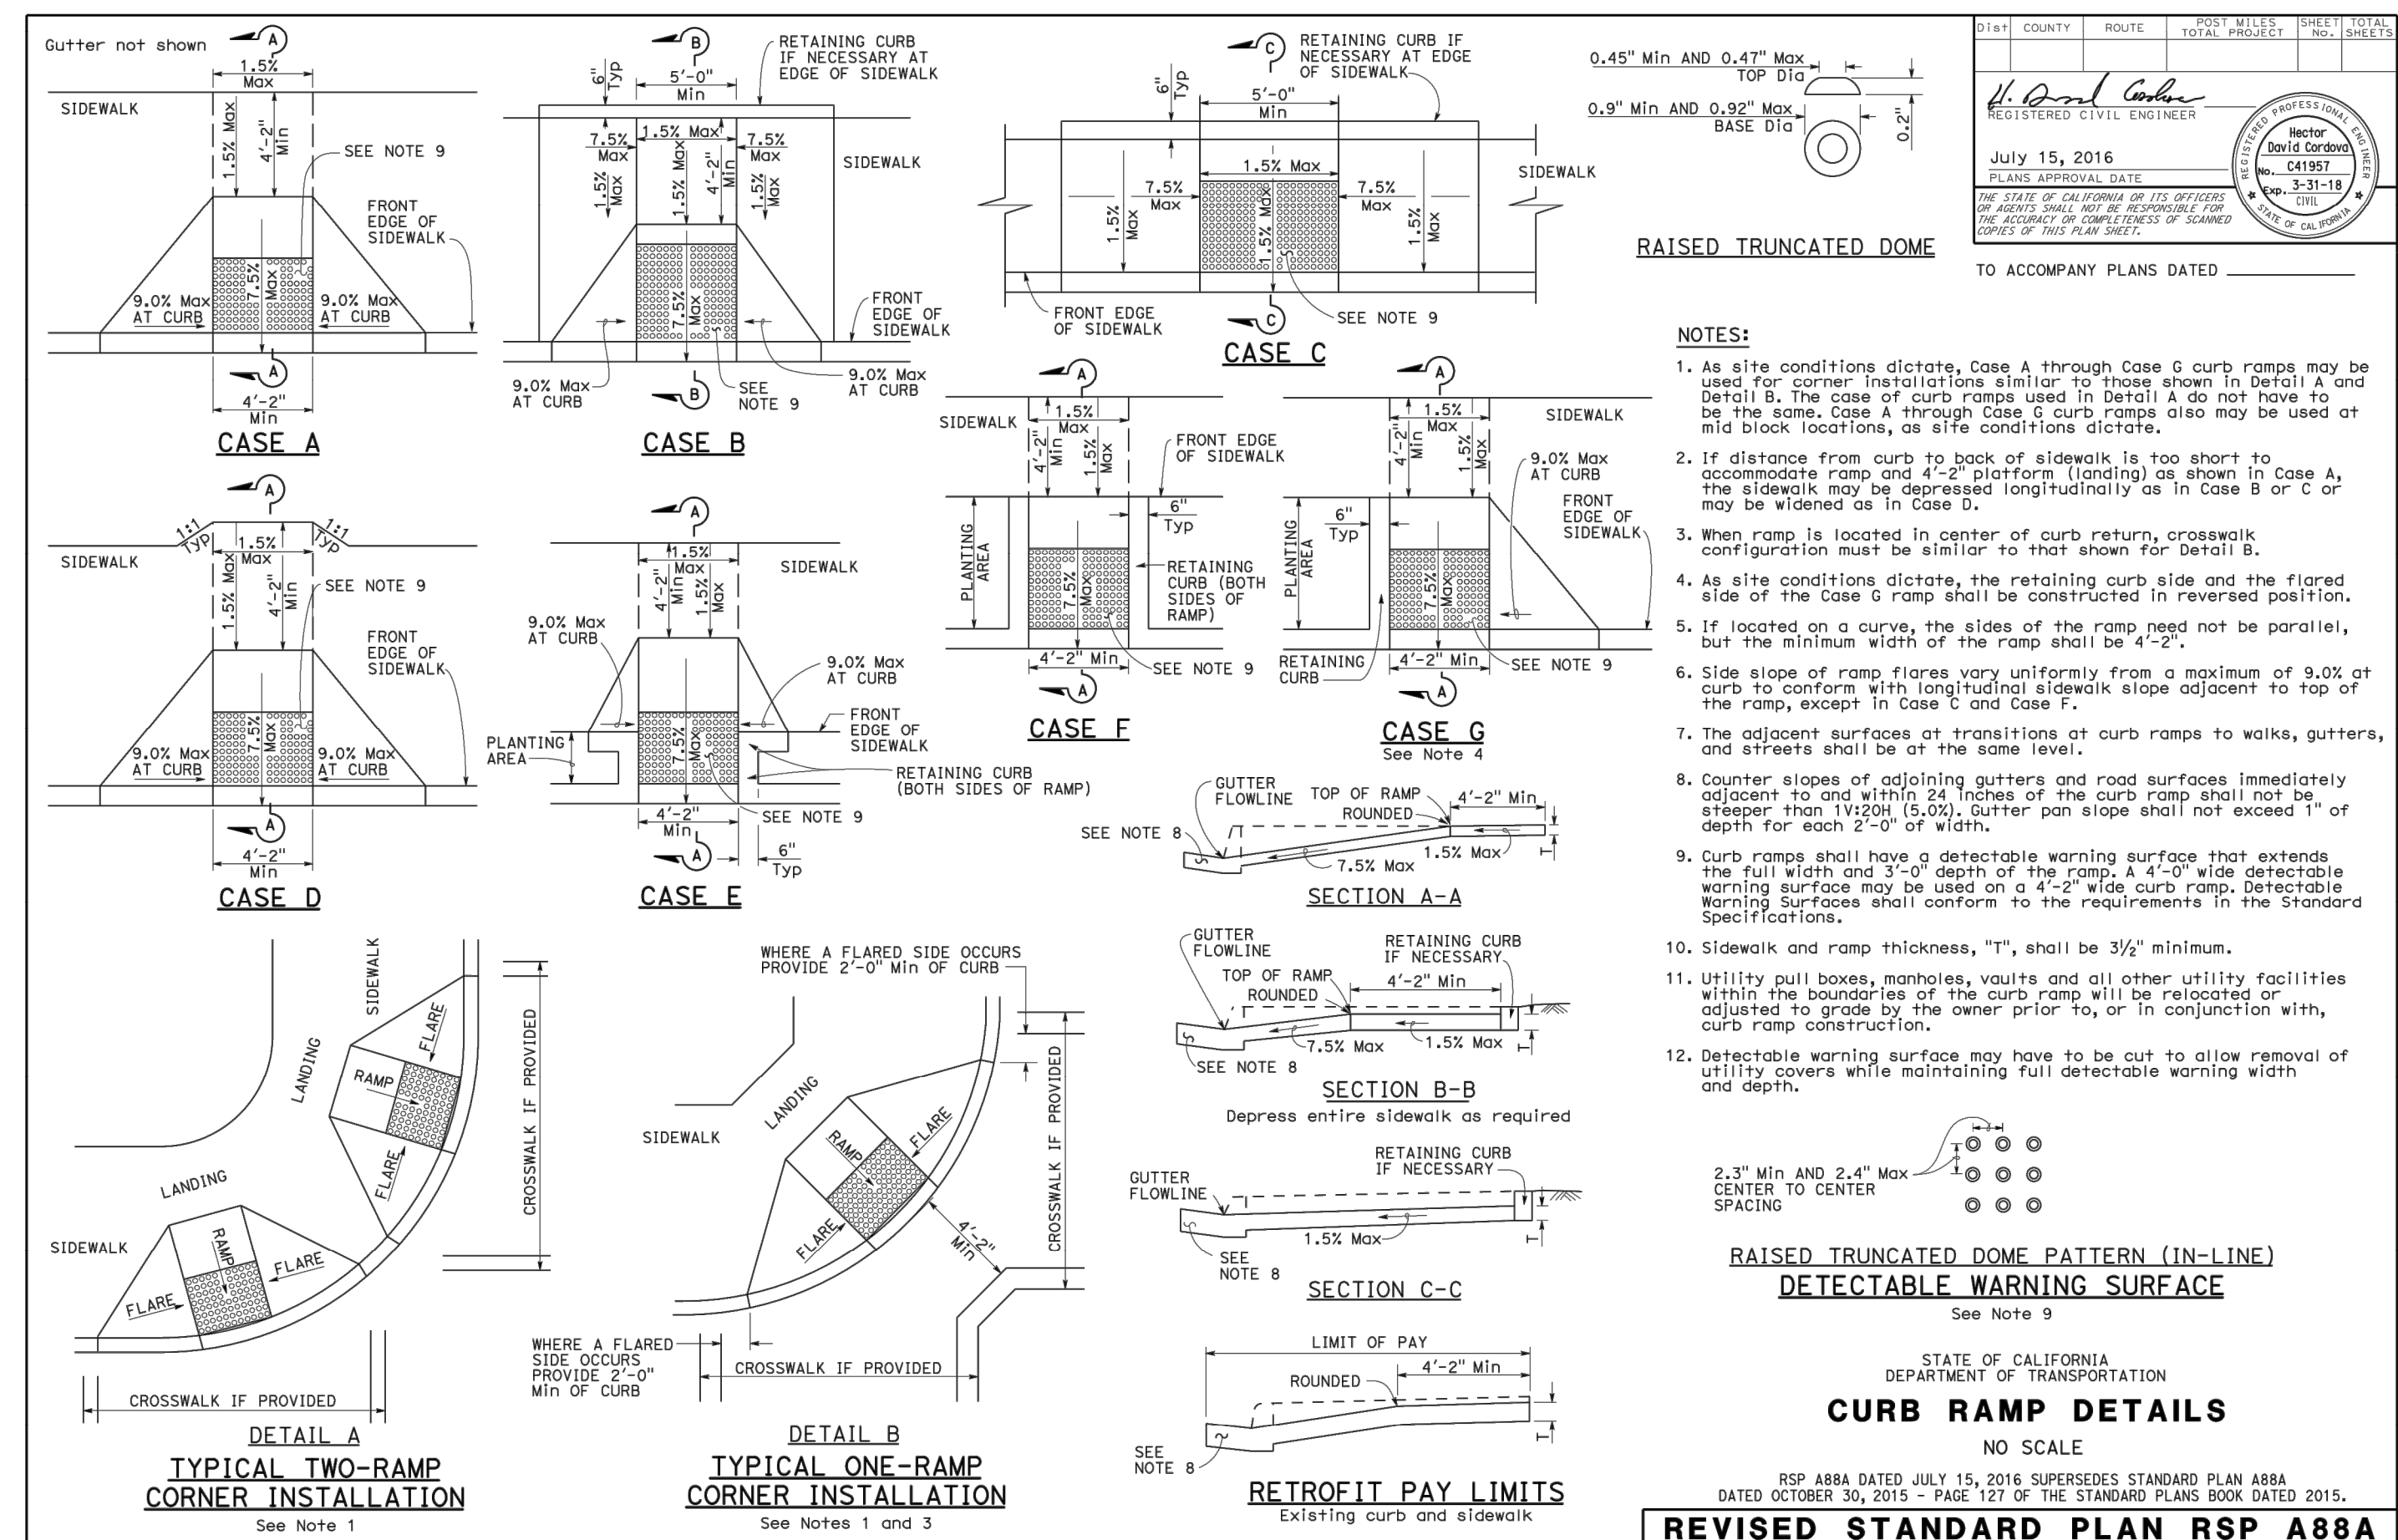

D ADA CURB RAMP

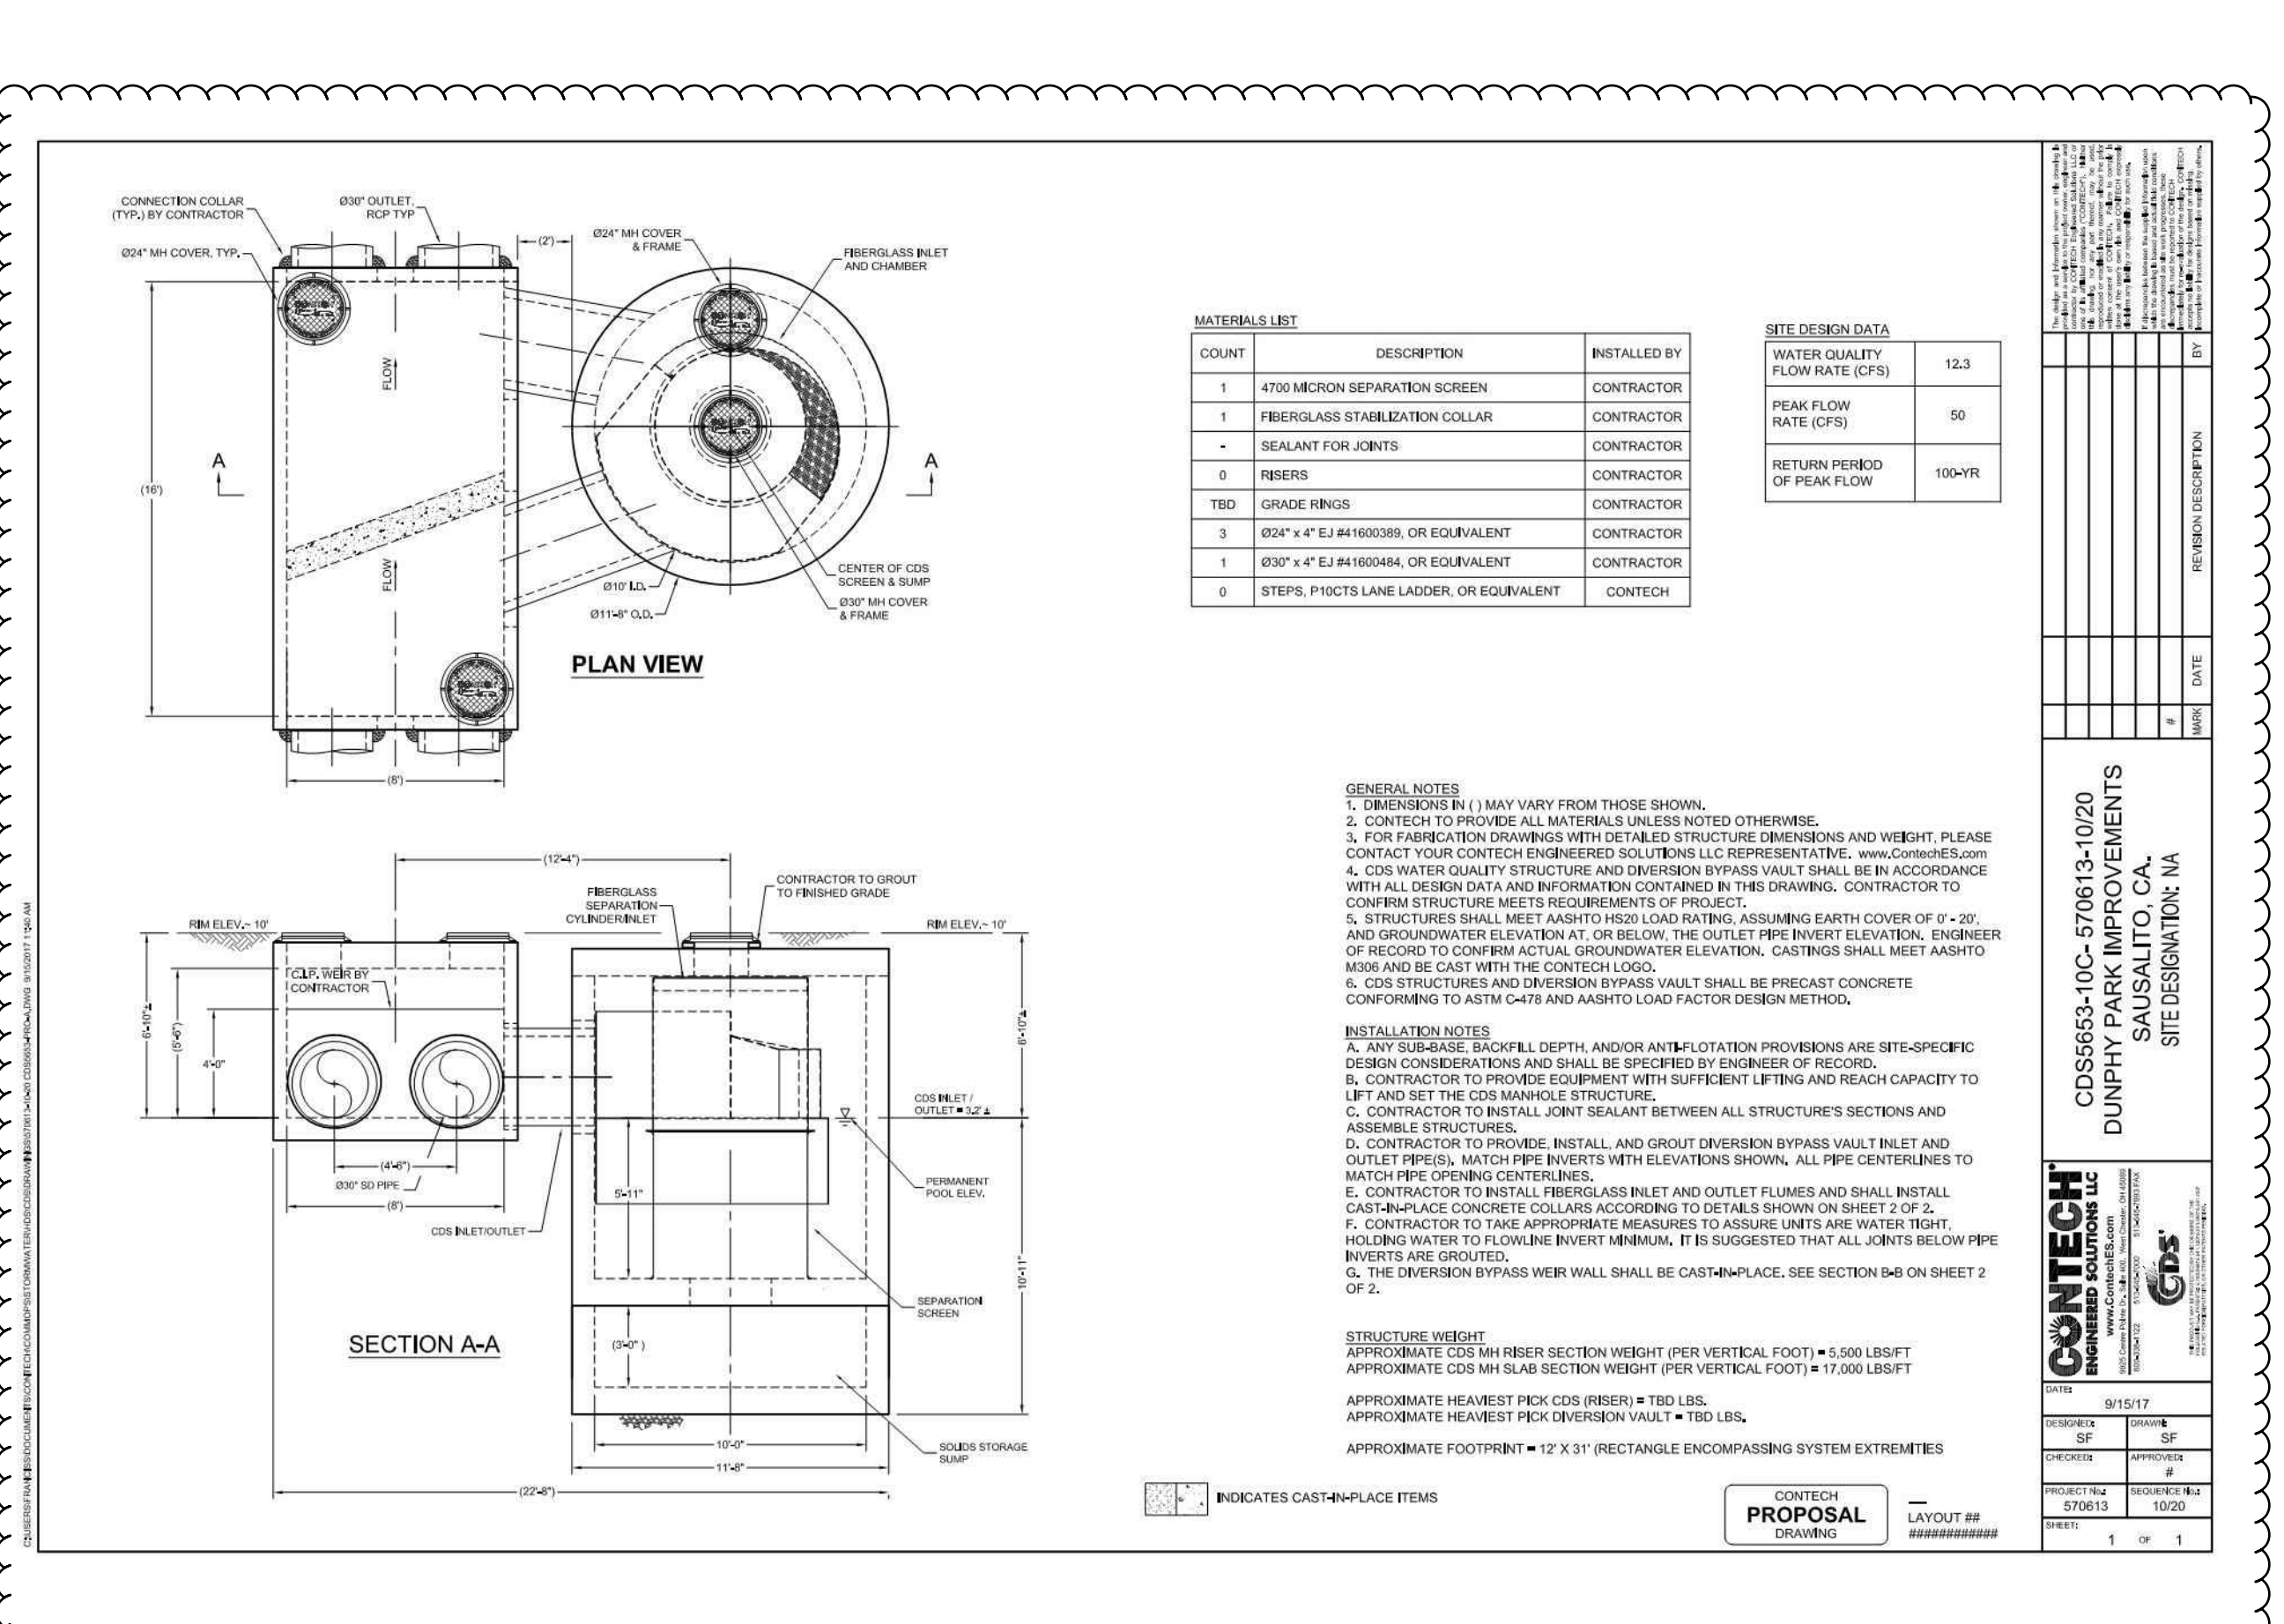

E SEDIMENT TRAP & INTERCEPT VAULT

P:\2017\17-02\_Dunphy\04\_Design\04\_CD\C4.01 - DETAILS.dwg - DETAIL: s.dwg - 2/15/2017 2:02 PM



PROJECT/CLIENT NAME

## Dunphy Park Improvement Project

200 Napa Street  
Sausalito, CA 94965

Owner:  
City of Sausalito  
420 Litho St.  
Sausalito, CA 94965

RHAA PROJECT NUMBER

16042A

CONSULTANT

SUBMITTAL

### Permit Submittal


DATE

21 August 2017

REVISIONS

No.	Date	Description
1	9-18-2017	Permit Plan Check Response

REGISTRATION AND SIGNATURE

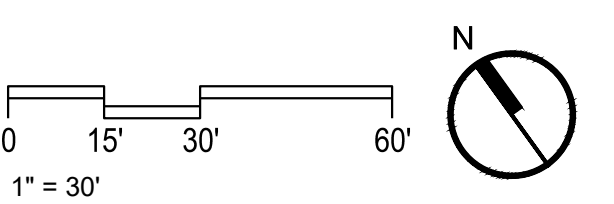

SHEET TITLE

## EROSION CONTROL PLAN

DRAWN BY: JG CHECKED BY: MW


# C5.0

### LEGEND


GRAVEL BAGS




STOCKPILE

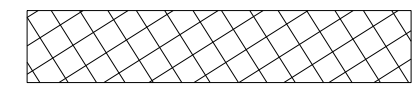


CONCRETE WASHOUT

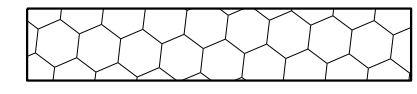

SILT FENCE

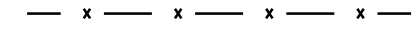


ERTEC PROWATTLE

 

### GENERAL NOTES:

1. FOR SITE DEMOLITION, SLP.
2. FOR TREE REMOVAL AND PROTECTION, SLP.
3. PLACE ERTEC S-FENCE AROUND DRAIN INLETS ALONG BRIDGEWAY AND NAPA STREET ADJACENT TO THE PROJECT.
4. ENSURE WADDLES ARE MONITORED TO PREVENT WILDLIFE FROM BEING TRAPPED.
5. REMOVE ALL EROSION CONTROL MEASURES UPON CONSTRUCTION COMPLETION.
6. CONTRACTOR TO PREVENT SEDIMENT BUILD UP ON ALL PERVIOUS HARDSCAPE SURFACES DURING CONSTRUCTION.

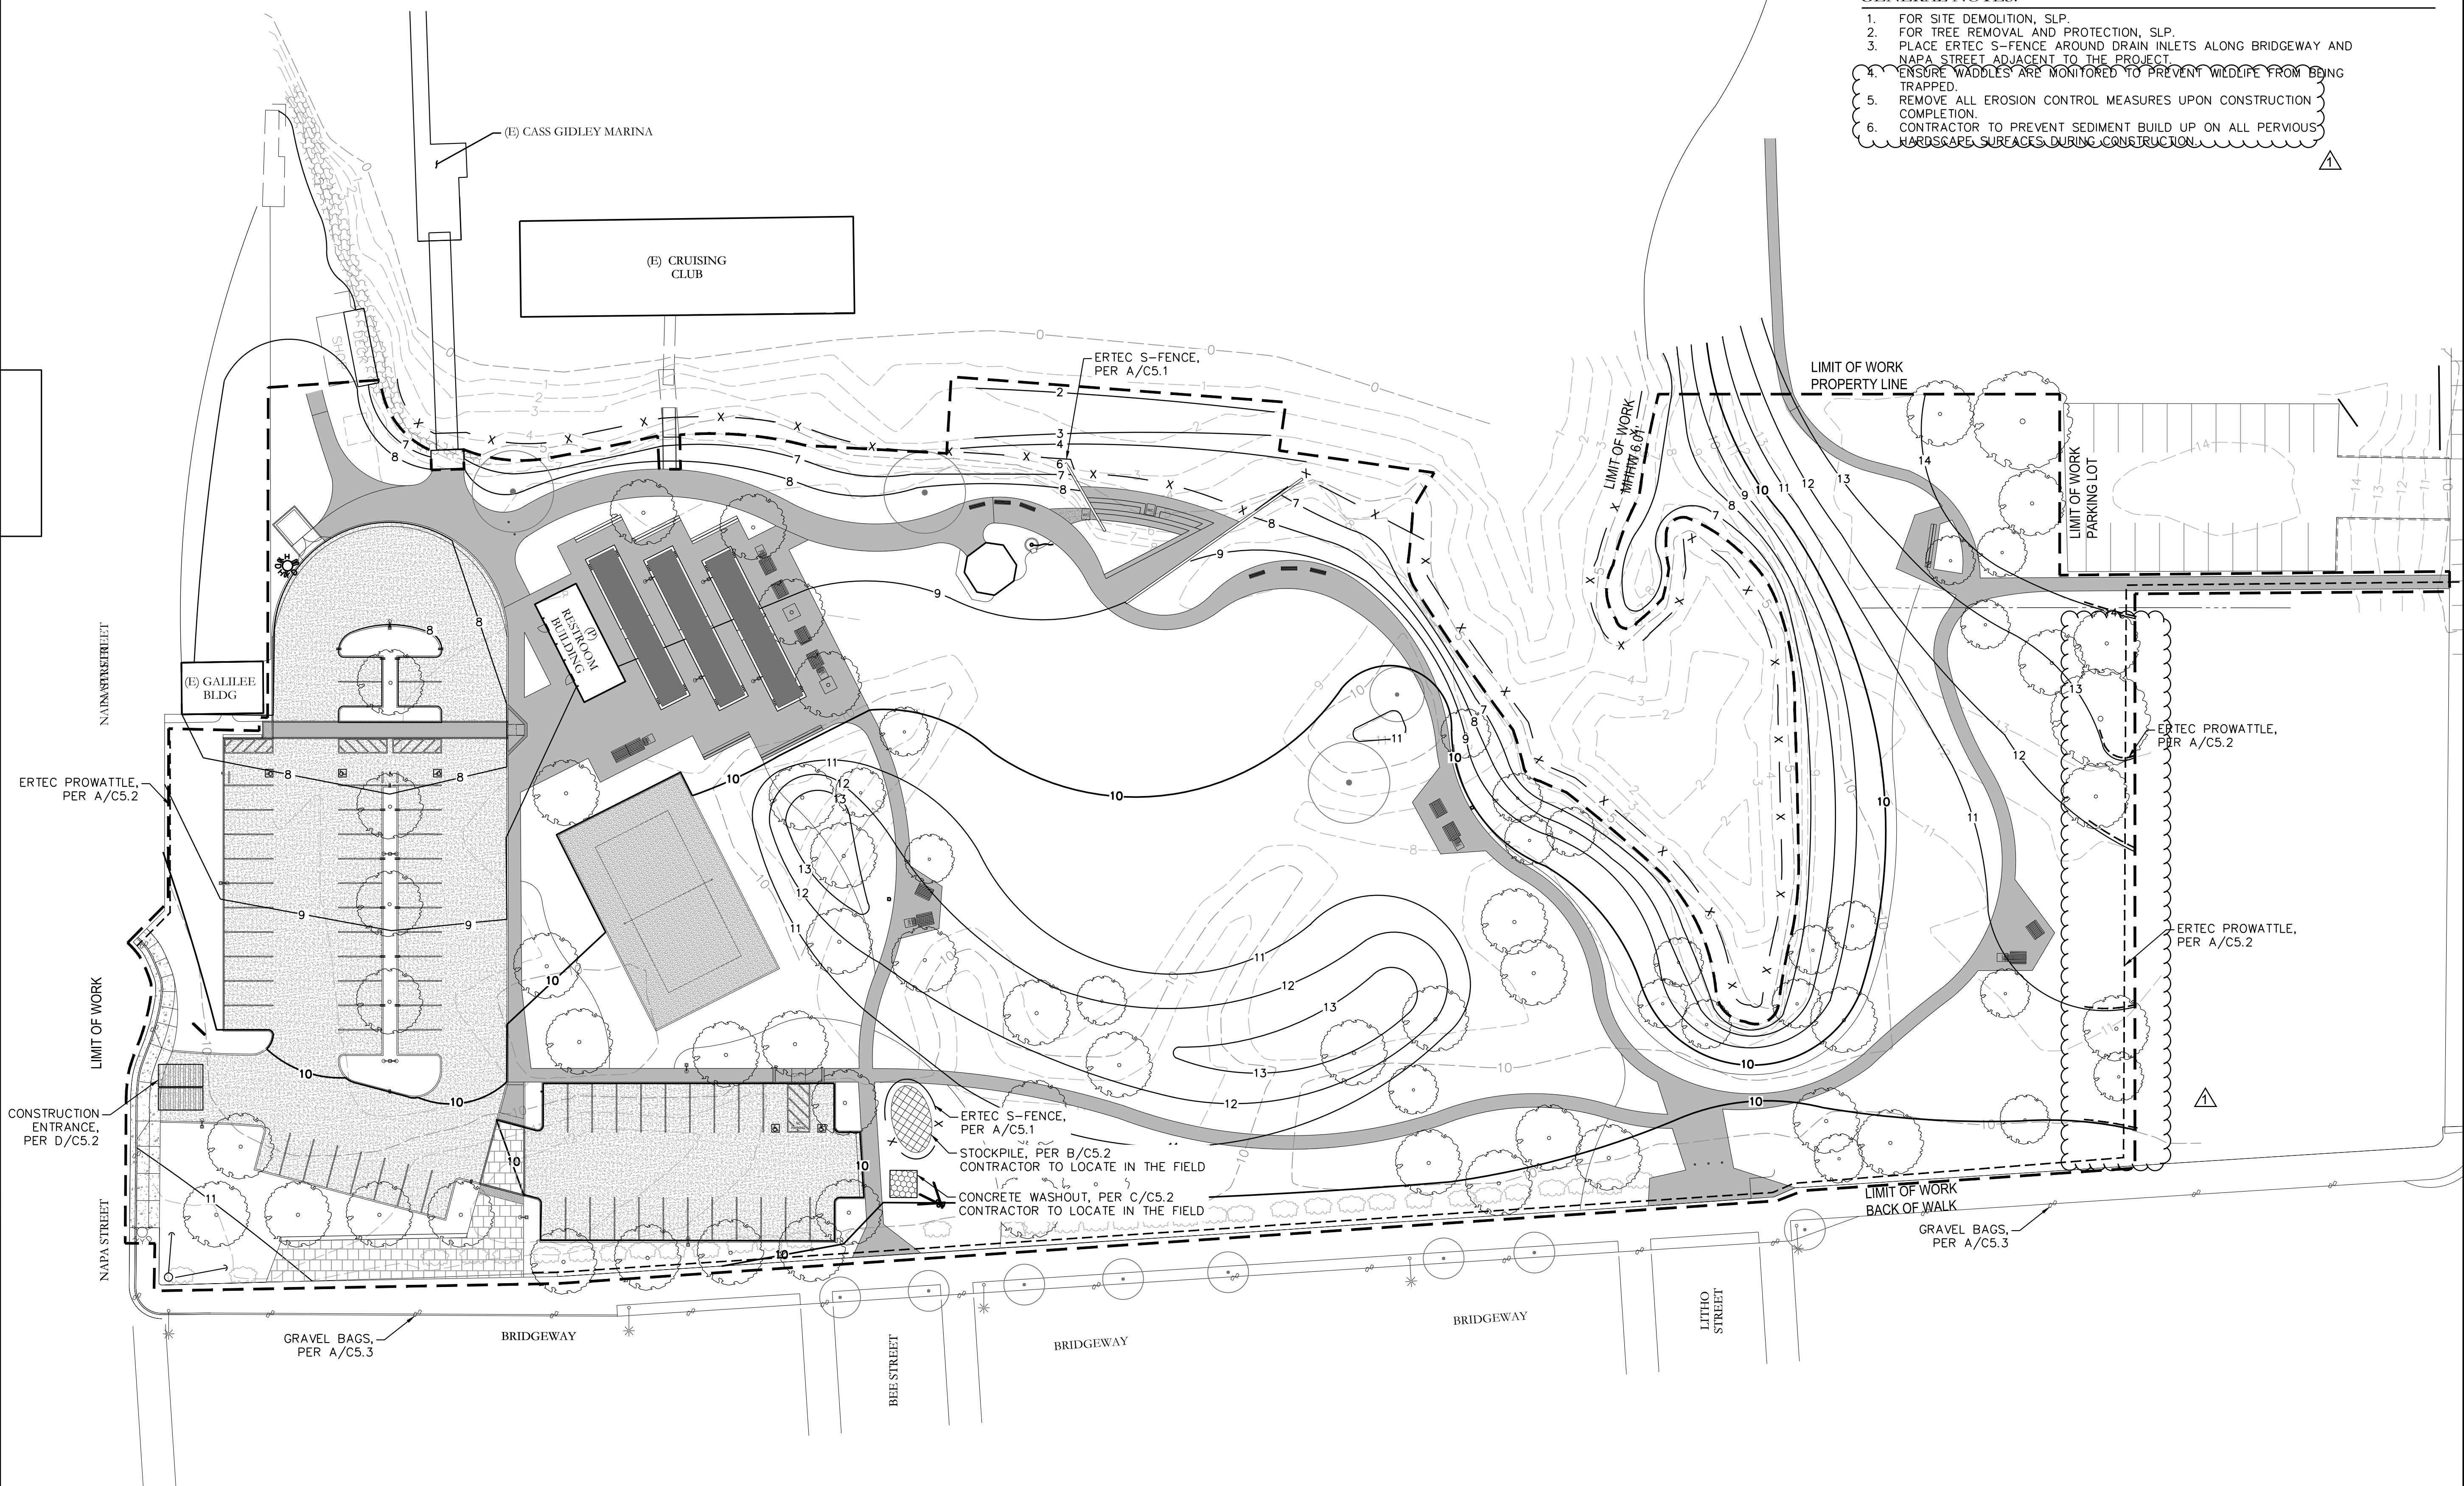

P:\2017\17-02\_Dunphy\01\_Design\01\_CD\C5.0 - EROSION CONTROL PLAN.dwg(25/01/15/2017 11:53:33 PMLARCHI) expand D:\600 x 24.00 Inches.rvt  
 Date Plotted: 9/15/2017 1:15 PM

ERTEC® S-FENCE™  
DETAILS


KEY BENEFITS:

- WILL NOT DETERIORATE OR BLOW DOWN
- REMOVE WITH MINIMAL DISTURBANCE TO LANDSCAPING
- COMPACT STORAGE AND TRANSPORTATION
- LONG LASTING (4+ YEARS)
- HIGH REUSABILITY
- LETS WATER FLOW OFF-SITE
- HIGH SEDIMENT RETENTION

APPROPRIATE APPLICATIONS:

- BASE OF STABILIZED SLOPES
- JOB PERIMETERS
- ALTERNATIVE TO SILT FENCE

FENCE HEIGHT "X"	FILTER WIDTH "Y"
10"	9"
14"	12"
20"	18"

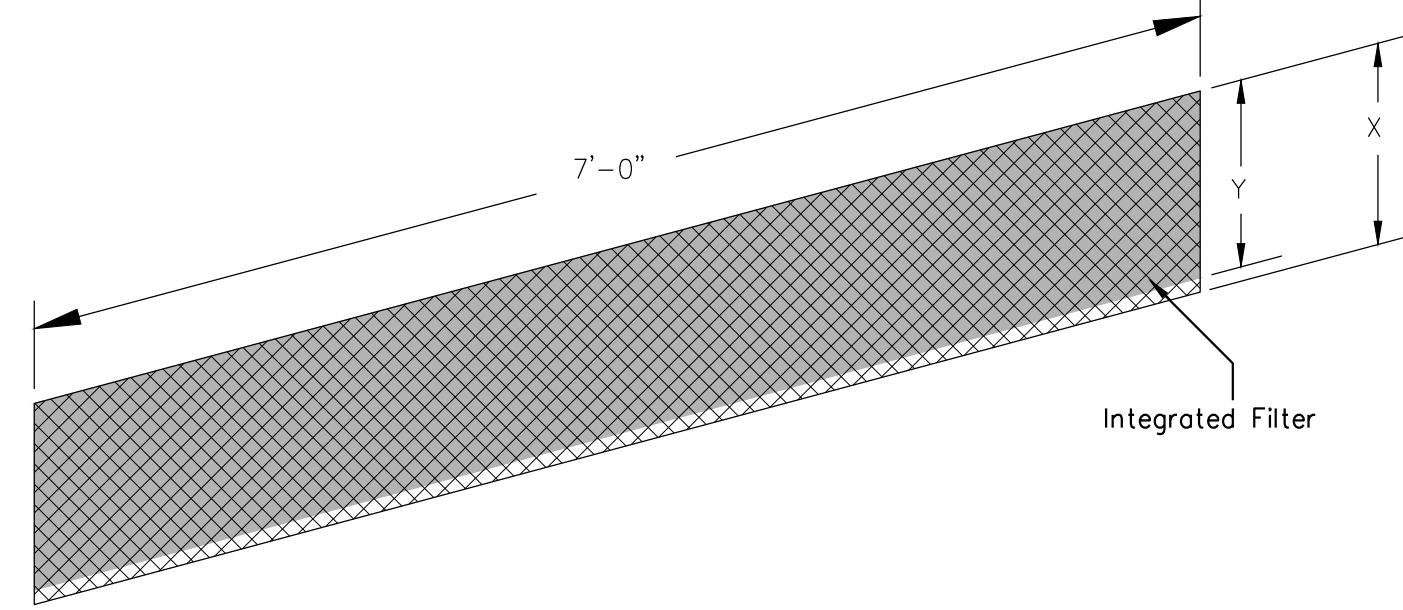

**PURPOSE:** S-FENCE™ IS USED TO FILTER SEDIMENT LADEN WATER AND DETAIN A HIGH PERCENTAGE OF SEDIMENT AND ASSOCIATED POLLUTANTS. THE SYSTEM REDUCES THE VELOCITY OF WATER AND ALLOWS IT TO SPREAD AND FLOW THROUGH AS LOWER VELOCITY SHEET FLOW. FLOW THROUGH DISCOURAGES END-AROUND FLOWS UNDER AND OVERFLOW. THE SYSTEM FILTERS CERTAIN SIZED SMALLER PARTICLES. THE FILTER DEVELOPS A FILTER CAKE, WHICH IN TURN FILTERS SMALLER AND SMALLER PARTICLES OVER TIME.

**DESIGN CRITERIA:** FOR DETAILED PRODUCT CHARACTERISTICS CONTACT ERTEC ENVIRONMENTAL SYSTEMS @ (866) 521-0724 OR [WWW.ERTECENVIRONMENTAL.COM](http://WWW.ERTECENVIRONMENTAL.COM). THE UNIT WEIGHT OF THE SYSTEM IS 0.30 LBS/FT<sup>2</sup> (10"), 0.40 LBS/FT<sup>2</sup> (14") AND 0.62 LBS/FT<sup>2</sup> (20"). FOR INSTALLATION PROCEDURES, FOLLOW THE INSTRUCTIONS ON THE ATTACHED DRAWINGS. THE LAST IN-LINE S-FENCE™ SHOULD BE BENT AND DOG-LEGGED UPLOPE TO ENSURE SEDIMENT CONTAINMENT.

**MAINTENANCE:** INSPECT S-FENCE™ WHEN RAIN IS FORECAST. PERFORM MAINTENANCE AS NEEDED OR AS REQUIRED. INSPECT S-FENCE™ FOLLOWING RAINFALL EVENTS AND AT LEAST DAILY DURING PROLONGED RAINFALL. MAINTAIN S-FENCE™ TO PROVIDE AN ADEQUATE SEDIMENT HOLDING CAPACITY. SEDIMENT SHALL BE REMOVED WHEN THE SEDIMENT ACCUMULATION REACHES 50% OF THE BARRIER HEIGHT. REMOVED SEDIMENT SHOULD BE INCORPORATED IN THE PROJECT OUTSIDE OF CONCENTRATED FLOW PATHS. REMOVE S-FENCE™ AFTER THE SITE HAS BEEN STABILIZED.

**\*\* NOT TO SCALE \*\*** U.S. and International Patents Apply ©2009 ERTEC Environmental Systems


ERTEC Environmental Systems  
<http://www.ertecsystems.com>

1150 Balboa Blvd., Suite 250, Alameda, CA 94501  
P: 866-521-0724 F: 910-521-3972

ERTEC\_Installation\_Details\_S-Fence.dwg  
P1 Details  
8.5" x 11" 1 of 4

ERTEC® S-FENCE™  
INSTALLATION DETAILS

10" OR 14", SF10 OR SF14

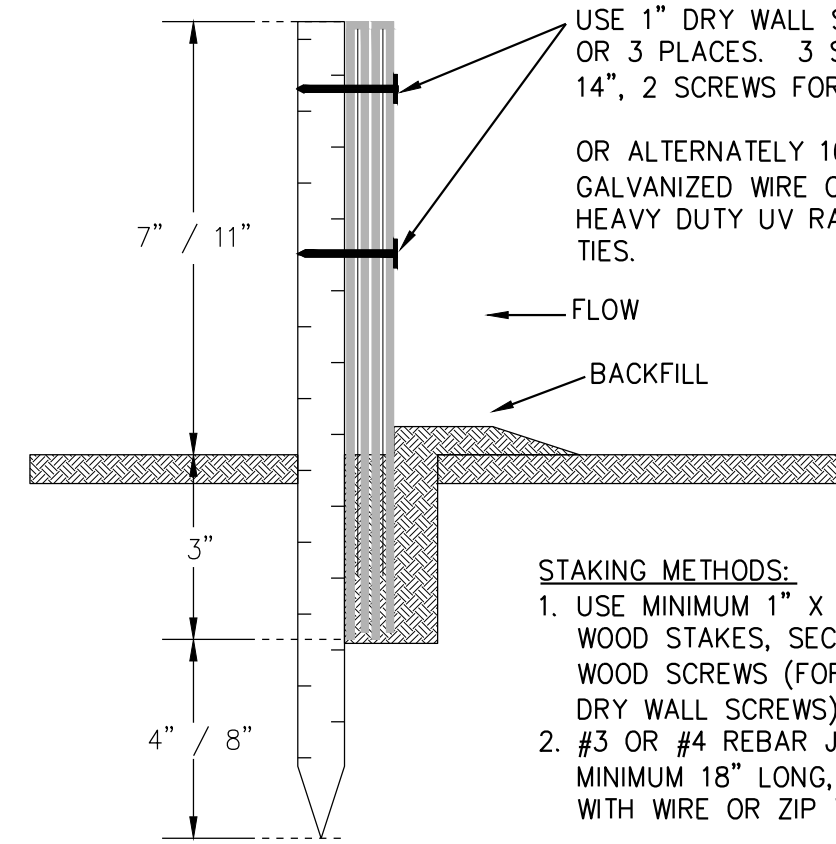


- STAKING METHODS:**
1. USE MINIMUM 1" X 2" X 18" WOOD STAKES, SECURE WITH WOOD SCREWS (FOR EXAMPLE DRY WALL SCREWS).
  2. #3 OR #4 REBAR J-HOOK MINIMUM 18" LONG, SECURE WITH WIRE OR ZIP TIES.

- NOTES:**
1. CUT TRENCH 1½" TO 2" WIDE, 3" TO 4" DEEP.
  2. INSTALL IN SLOT AGAINST DOWNSTREAM SIDE OF TRENCH WALL. BACKFILL THE TRENCH TO GRADE LEVEL.
  3. OVERLAP SEGMENTS BY AT LEAST 4". INSTALL STAKES ON DOWNSTREAM SIDE OF SEGMENT OVERLAPS.
  4. USE 1" DRY WALL SCREWS: 2 OR 3 PLACES. OR ALTERNATELY 16 GAUGE GALVANIZED WIRE OR 7" BLACK HEAVY DUTY UV STAPLE CABLE TIES (ZIP TIES) TO TIE SEGMENTS TOGETHER.

- NOTES:**
1. DOG-LEG AT END-OF-RUNS TO CONTAIN SEDIMENT.
  2. INSTALL ON SAME CONTOUR TO LIMIT SCOUR AND FLOW CONCENTRATION. DOG-LEG PERIODICALLY IF ON DOWN-HILL RUN TO MINIMIZE VELOCITY SCOUR.

- STAKING METHODS:**
1. WOODEN STAKE: USE 1" X 2" X 18" - ONE AT EACH OVERLAP OR 80" APART.
  2. #3 OR #4 REBAR J-HOOK MINIMUM 18" LONG. USE GALVANIZED WIRE OR ZIP TIES TO TIE SEGMENTS TO J-HOOK.

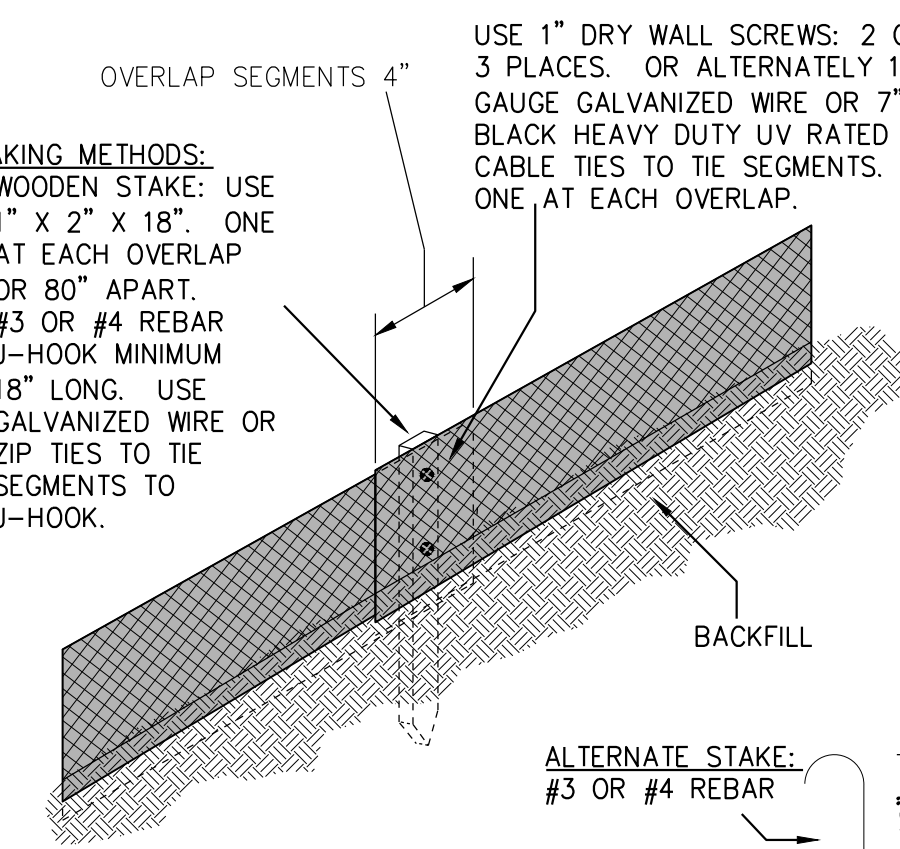

**\*\* NOT TO SCALE \*\*** U.S. and International Patents Apply ©2009 ERTEC Environmental Systems


ERTEC Environmental Systems  
<http://www.ertecsystems.com>

1150 Balboa Blvd., Suite 250, Alameda, CA 94501  
P: 866-521-0724 F: 910-521-3972


ERTEC\_Installation\_Details\_S-Fence.dwg  
P2 Installation Details  
8.5" x 11" 2 of 4

ERTEC® S-FENCE™  
INSTALLATION DETAILS

20", SF20

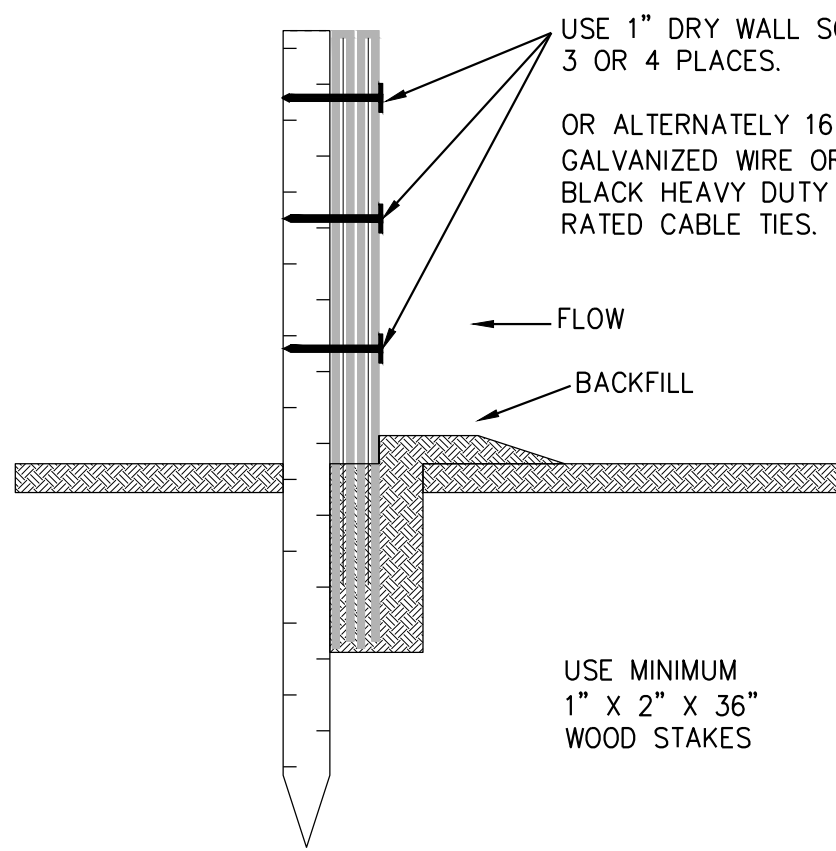

- NOTES:**
1. DOG-LEG AT END-OF-RUNS TO CONTAIN SEDIMENT.
  2. INSTALL ON SAME CONTOUR TO LIMIT SCOUR AND FLOW CONCENTRATION. DOG-LEG PERIODICALLY IF ON DOWN-HILL RUN TO MINIMIZE VELOCITY SCOUR.

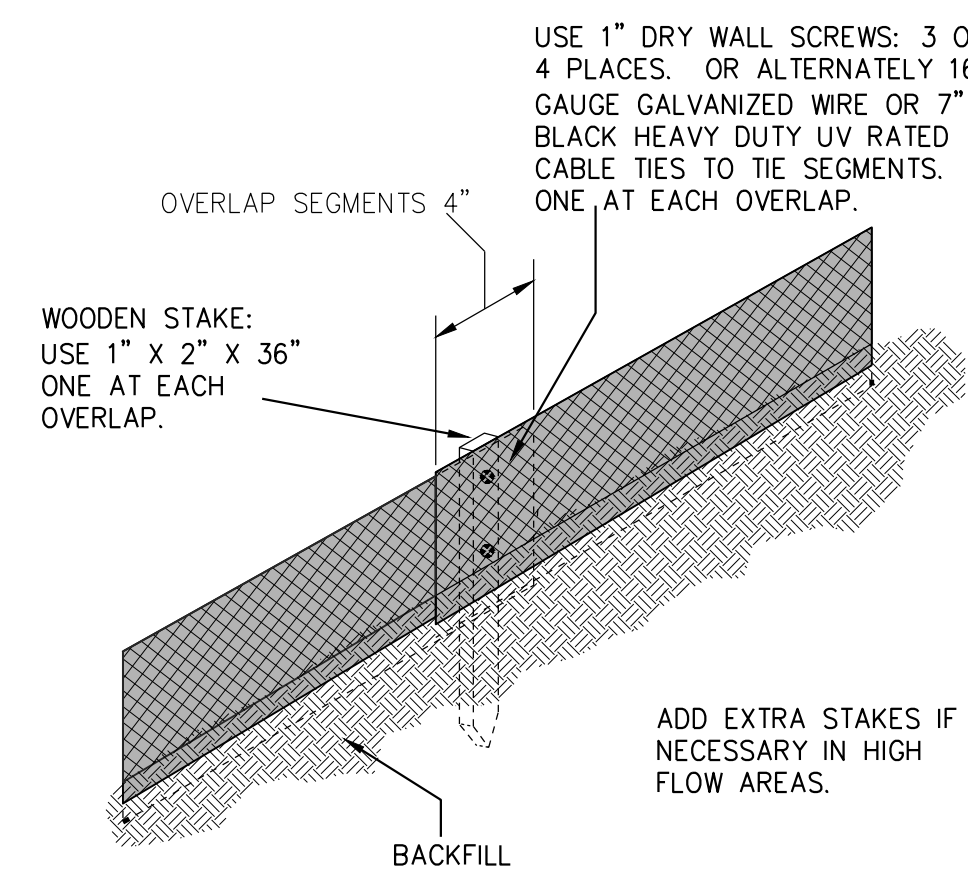

- NOTES:**
1. CUT TRENCH 1½" TO 2" WIDE, 4" DEEP.
  2. INSTALL IN SLOT AGAINST DOWNSTREAM SIDE OF TRENCH WALL. BACKFILL THE TRENCH TO GRADE LEVEL.
  3. OVERLAP SEGMENTS BY AT LEAST 4". INSTALL STAKES AT DOWNSTREAM SIDE OF SEGMENT OVERLAPS AND ALSO ONE STAKE IN BETWEEN SEGMENTS.
  4. USE 1" DRY WALL SCREWS: 3 OR 4 PLACES. OR ALTERNATELY 16 GAUGE GALVANIZED WIRE OR 7" BLACK HEAVY DUTY UV STAPLE CABLE TIES (ZIP TIES) TO TIE SEGMENTS TOGETHER.

**IMPORTANT:** ALL INFORMATION, INCLUDING ILLUSTRATIONS, IS BELIEVED TO BE RELIABLE. USERS, HOWEVER, SHOULD INDEPENDENTLY EVALUATE THE SUITABILITY OF EACH PROJECT FOR THEIR APPLICATION. ERTEC ENVIRONMENTAL SYSTEMS MAKES NO WARRANTIES AS TO THE ACCURACY OF COMPLETENESS OF THE INFORMATION, AND DISCLAIMS ANY LIABILITY REGARDING IS USE. ERTEC ENVIRONMENTAL SYSTEMS'S ONLY OBLIGATIONS ARE THOSE IN THE ERTEC ENVIRONMENTAL SYSTEMS STANDARD TERMS AND CONDITIONS OF SALE FOR THIS PRODUCT, AND IN NO CASE WILL ERTEC ENVIRONMENTAL SYSTEMS OR ITS DISTRIBUTORS BE LIABLE FOR ANY INCIDENTAL INDIRECT OR CONSEQUENTIAL DAMAGES ARISING FOR THE SALE, RESALE, USE OR MISUSE OF THE PRODUCT. SPECIFICATIONS ARE SUBJECT TO CHANGE WITHOUT NOTICE. IN ADDITION, ERTEC ENVIRONMENTAL SYSTEMS RESERVES THE RIGHT TO MAKE CHANGES, WITHOUT NOTIFICATION TO BUYER, TO PROCESSING OR MATERIALS THAT DO NOT AFFECT COMPLIANCE WITH ANY APPLICABLE SPECIFICATION.


**\*\* NOT TO SCALE \*\*** U.S. and International Patents Apply ©2009 ERTEC Environmental Systems

ERTEC Environmental Systems  
<http://www.ertecsystems.com>


1150 Balboa Blvd., Suite 250, Alameda, CA 94501  
P: 866-521-0724 F: 910-521-3972

ERTEC\_Installation\_Details\_S-Fence.dwg  
P3 Installation Details  
8.5" x 11" 3 of 4

ERTEC® S-FENCE™  
APPLICATION DETAIL -  
INSTALLATION NEXT TO  
PERIMETER FENCE

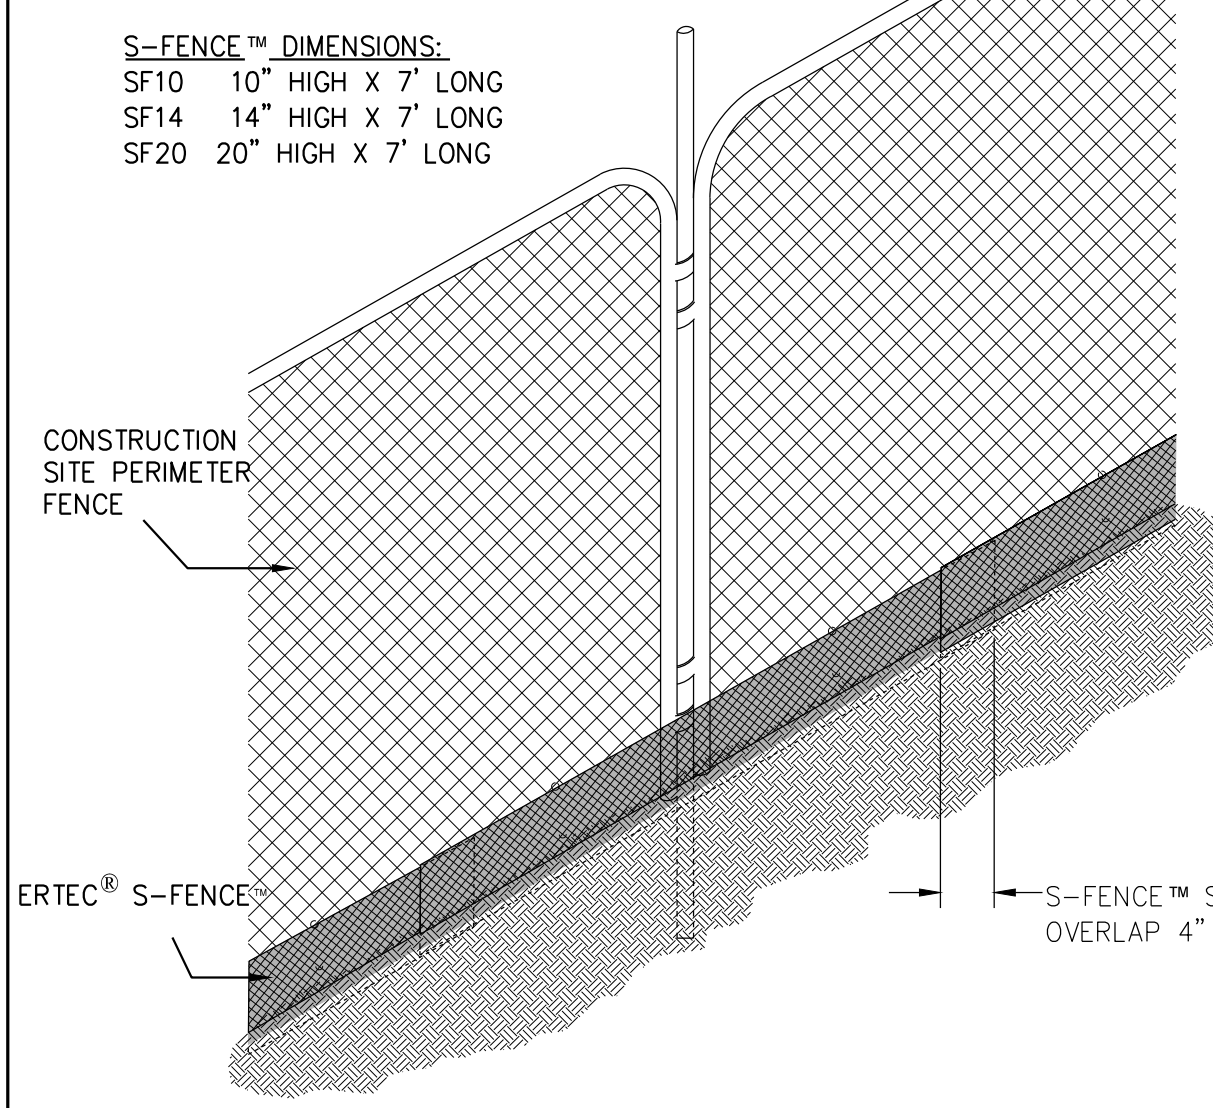

- S-FENCE™ DIMENSIONS:**
- SF10 10" HIGH X 7' LONG
  - SF14 14" HIGH X 7' LONG
  - SF20 20" HIGH X 7' LONG

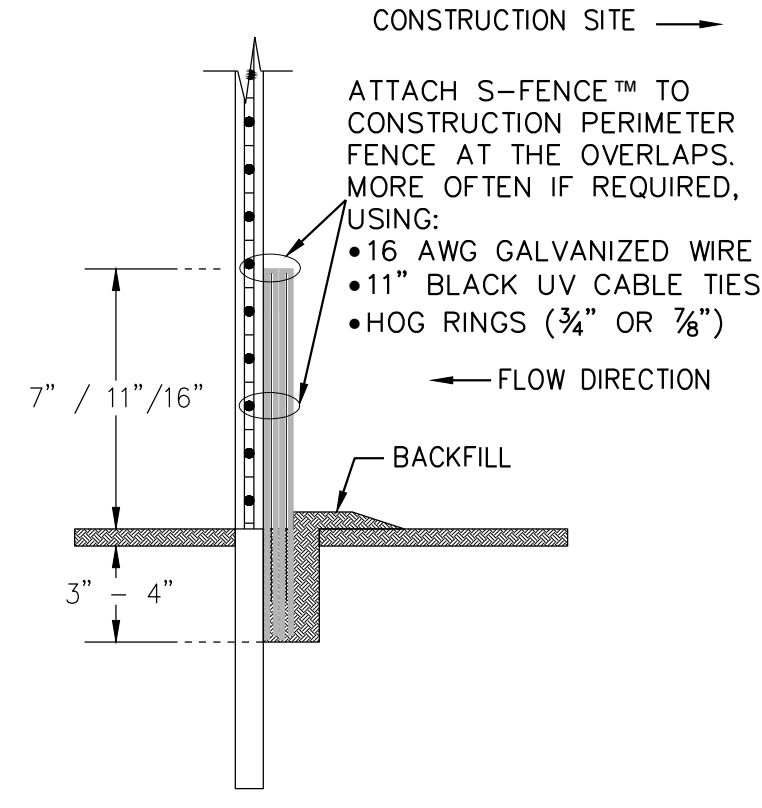

- NOTES:**
1. CABLE-TIES WILL REQUIRE A PILOT HOLE FOR INSERTION. USE A PUNCH OR SMALL NAIL.
  2. CUT TRENCH 1½" TO 2" WIDE, 3" TO 4" DEEP.
  3. INSTALL IN SLOT AGAINST DOWNSTREAM SIDE OF TRENCH WALL, BACKFILL THE TRENCH TO GRADE LEVEL.
  4. OVERLAP SEGMENTS BY AT LEAST 4".

**IMPORTANT:** ALL INFORMATION, INCLUDING ILLUSTRATIONS, IS BELIEVED TO BE RELIABLE. USERS, HOWEVER, SHOULD INDEPENDENTLY EVALUATE THE SUITABILITY OF EACH PROJECT FOR THEIR APPLICATION. ERTEC ENVIRONMENTAL SYSTEMS MAKES NO WARRANTIES AS TO THE ACCURACY OF COMPLETENESS OF THE INFORMATION, AND DISCLAIMS ANY LIABILITY REGARDING IS USE. ERTEC ENVIRONMENTAL SYSTEMS'S ONLY OBLIGATIONS ARE THOSE IN THE ERTEC ENVIRONMENTAL SYSTEMS STANDARD TERMS AND CONDITIONS OF SALE FOR THIS PRODUCT, AND IN NO CASE WILL ERTEC ENVIRONMENTAL SYSTEMS OR ITS DISTRIBUTORS BE LIABLE FOR ANY INCIDENTAL INDIRECT OR CONSEQUENTIAL DAMAGES ARISING FOR THE SALE, RESALE, USE OR MISUSE OF THE PRODUCT. SPECIFICATIONS ARE SUBJECT TO CHANGE WITHOUT NOTICE. IN ADDITION, ERTEC ENVIRONMENTAL SYSTEMS RESERVES THE RIGHT TO MAKE CHANGES, WITHOUT NOTIFICATION TO BUYER, TO PROCESSING OR MATERIALS THAT DO NOT AFFECT COMPLIANCE WITH ANY APPLICABLE SPECIFICATION.

**\*\* NOT TO SCALE \*\*** U.S. and International Patents Apply ©2009 ERTEC Environmental Systems

ERTEC Environmental Systems  
<http://www.ertecsystems.com>

1150 Balboa Blvd., Suite 250, Alameda, CA 94501  
P: 866-521-0724 F: 910-521-3972

ERTEC\_Installation\_Details\_S-Fence.dwg  
P4 Application Details  
8.5" x 11" 4 of 4

A S-FENCE INSTALLATION

SCALE: NTS

PROJECT/CLIENT NAME  
**Dunphy Park Improvement Project**

200 Napa Street  
Sausalito, CA 94965

Owner:  
City of Sausalito  
420 Litho St.  
Sausalito, CA 94965

RHAA PROJECT NUMBER  
**16042A**

CONSULTANT

SUBMITTAL  
**Permit Submittal**

DATE  
**21 August 2017**

REVISIONS

No.	Date	Description
1	9-18-2017	Permit Plan Check Response



REGISTRATION AND SIGNATURE



SHEET TITLE  
**EROSION CONTROL DETAILS**

DRAWN BY: JG CHECKED BY: MW

**C5.1**

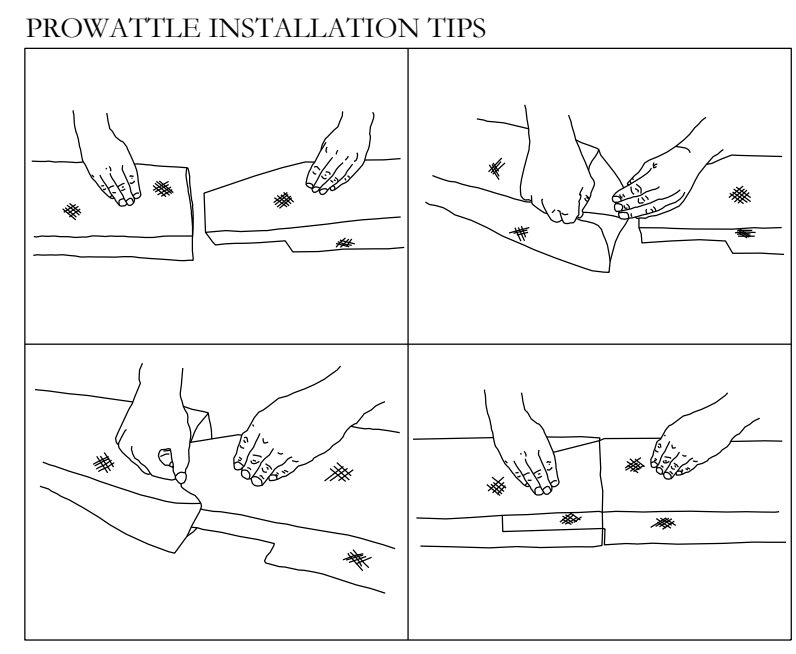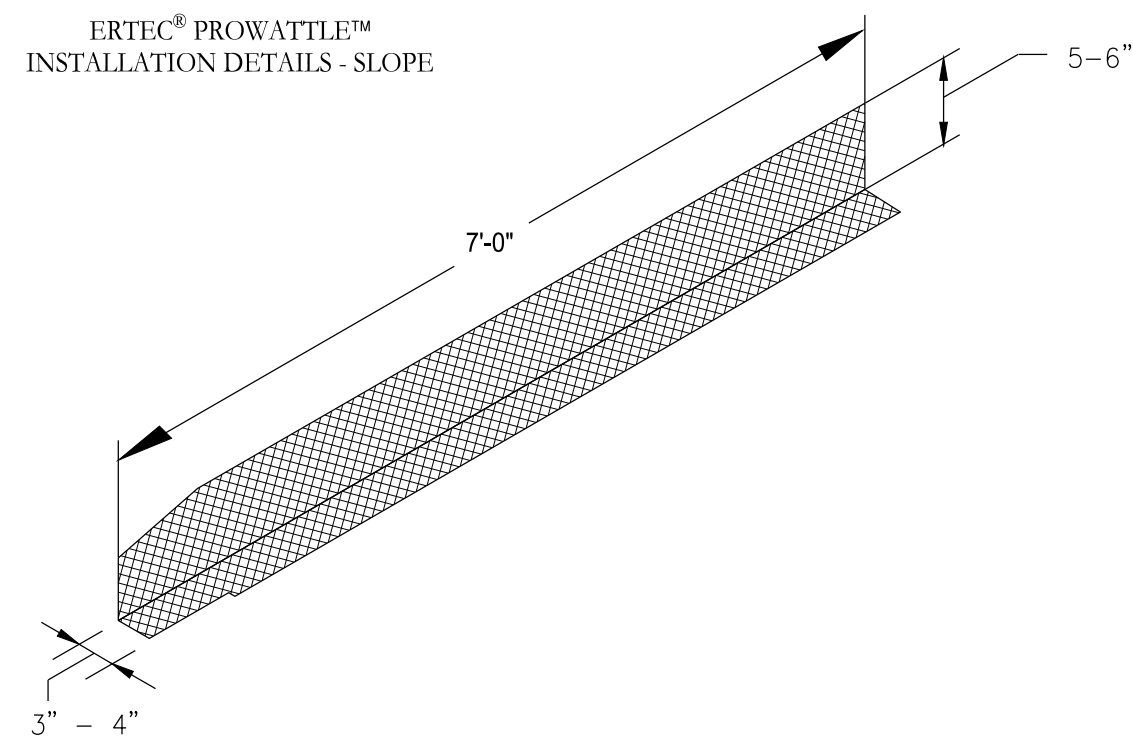

THE END OF ONE PW IS INSERTED INTO THE ADJOINING PW AND BUTTED UP AGAINST EACH OTHER. THEN BUTT THE TWO PW SEGMENTS TOGETHER FIRMLY.

FOR SLOPE INSTALLATION PROWATTLE SHALL BE INSTALLED AS FOLLOWS:  
 1. A SHELF-CUT SHALL BE CONSTRUCTED 4" HORIZONTALLY INTO THE SLOPE.  
 2. STAKES SHALL BE INSTALLED ON SLOPES. INSTALL STAKES 5 FEET APART. STAKES SHALL BE DRIVEN FLUSH WITH THE TOP OF THE PROWATTLE. WOOD STAKES SHALL BE AT MINIMUM: 1" X 1" X 12". REBAR J-HOOK STAKES (#3 OR #4) MUST BE A MINIMUM OF 18" LONG.  
 3. PROWATTLE SHALL BE PLACED AS FOLLOWS:



FEET APART ALONG THE SLOPE	SLOPE INCLINATION (VERTICAL:HORIZONTAL)
10 FEET	1:2 AND STEEPER
15 FEET	1:2 TO 1:4
20 FEET	1:4 AND 1:10
50 FEET	1:10 AND FLATTER

4. THE SHELF-CUT FOR PROWATTLE SHALL BE CLEARED OF OBSTRUCTIONS INCLUDING, BUT NOT LIMITED TO, ROCKS, CLODS, AND DEBRIS GREATER THAN 1" IN DIAMETER PRIOR TO INSTALLATION.  
 5. PROWATTLE SHALL BE INSTALLED PARALLEL TO THE SLOPE CONTOUR.  
 6. PROWATTLE SHALL BE INSTALLED PRIOR TO THE APPLICATION OF OTHER TEMPORARY EROSION CONTROL OR SOIL STABILIZATION MATERIALS IN THE SAME AREA.  
 7. WHEN NO LONGER REQUIRED, PROWATTLE CAN BE REMOVED AND REUSED. CRACK LOOSE AND SHAKE SEDIMENT FROM PROWATTLE SEGMENT. IT IS NOT NECESSARY TO CLEAN PROWATTLE OF ALL REMAINING SEDIMENT PRIOR TO REUSE (IT IS NOT NECESSARY TO PRESSURE-WASH PROWATTLE BETWEEN INSTALLATIONS). THE RESIDUAL SEDIMENT THAT REMAINS ON THE FILTER CAN BE BENEFICIAL AS A SECONDARY FILTER (FILTER CAKE) UPON SUBSEQUENT INSTALLATIONS. PRIOR TO REUSE, PERFORM 2-STEP QUALITY INSPECTION AS PER INSTALLATION GUIDE (WWW.ERTECSYSTEMS.COM).

**\*\* NOT TO SCALE \*\***

ERTEC Environmental Systems  
 1150 Balboa Blvd., Suite 250, Alameda, CA 94501  
 P: 866-521-0724 F: 510-521-3872  
 www.ertecsystems.com

ERTEC - Installation Details - P1 Slope Details  
 8.5" x 11" 1 of 3

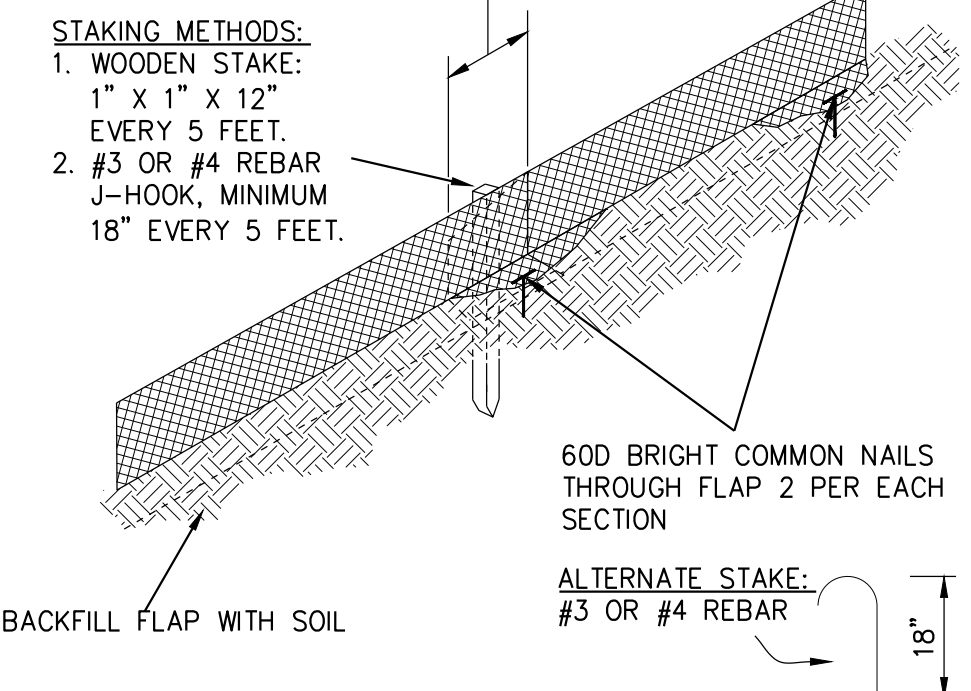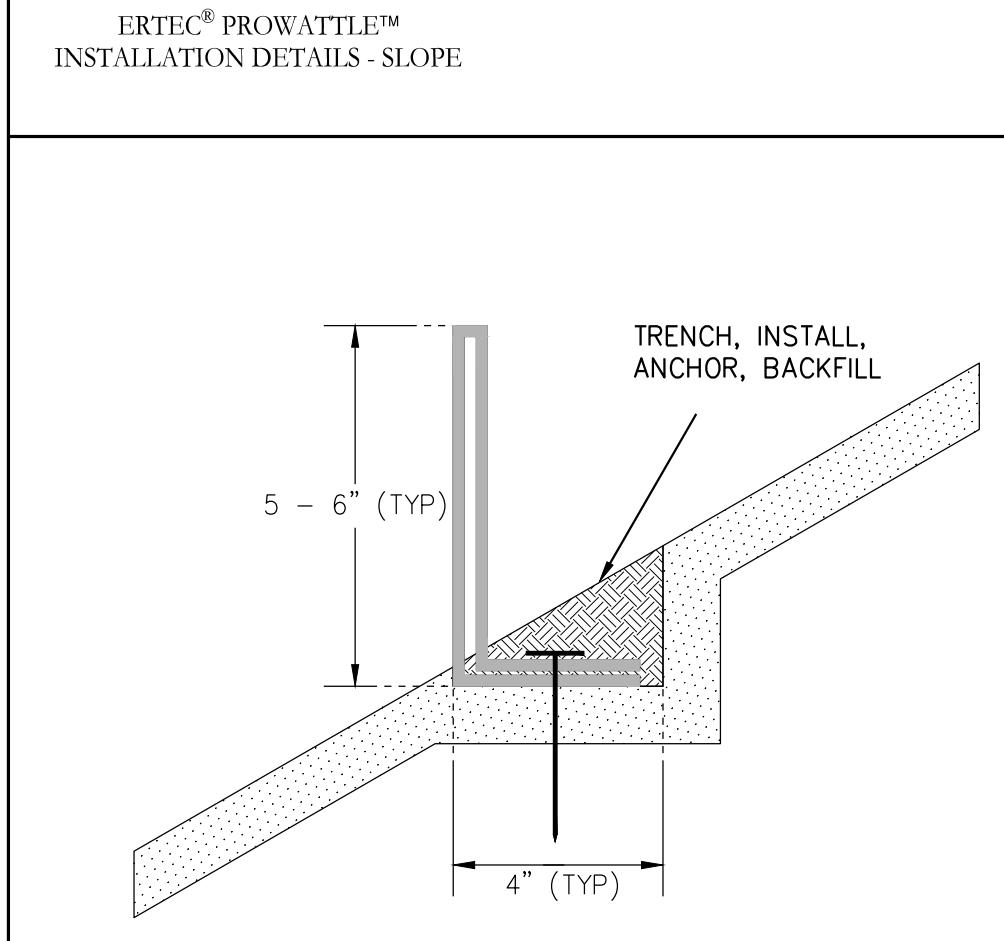


NOTES:  
 1. STAKES REQUIRED ON SLOPES  
 2. REINFORCE PROWATTLE WITH STAKES. INSTALL ONE STAKE EVERY 5 FEET.

NOTES:  
 1. INSERT ADJOINING SEGMENTS. CHAMFERED END FITS INSIDE ADJOINING SEGMENT.  
 2. USE 6" NAILS (60D BRIGHT-COMMON). INSTALL 2 NAILS PER EACH 7' SEGMENT, ONE AT OVERLAP AND ONE MID-SEGMENT.  
 3. INSTALL NAILS FLUSH WITH FLAP SO THAT FLAP IS IN GOOD CONTACT WITH SOIL.  
 4. COVER FLAP WITH SOIL TO PREVENT UNDERCUTTING.  
 5. REINFORCE WITH STAKES AS SHOWN - ONE STAKE EVERY 5 FEET. IT IS NOT NECESSARY TO FASTEN THE STAKES TO PROWATTLE. POSITION STAKE ON DOWNSTREAM SIDE OF PROWATTLE TO MINIMIZE LEANING.

**\*\* NOT TO SCALE \*\***

ERTEC Environmental Systems  
 1150 Balboa Blvd., Suite 250, Alameda, CA 94501  
 P: 866-521-0724 F: 510-521-3872  
 www.ertecsystems.com



ERTEC - Installation Details - P2 Slope Details  
 8.5" x 11" 2 of 3

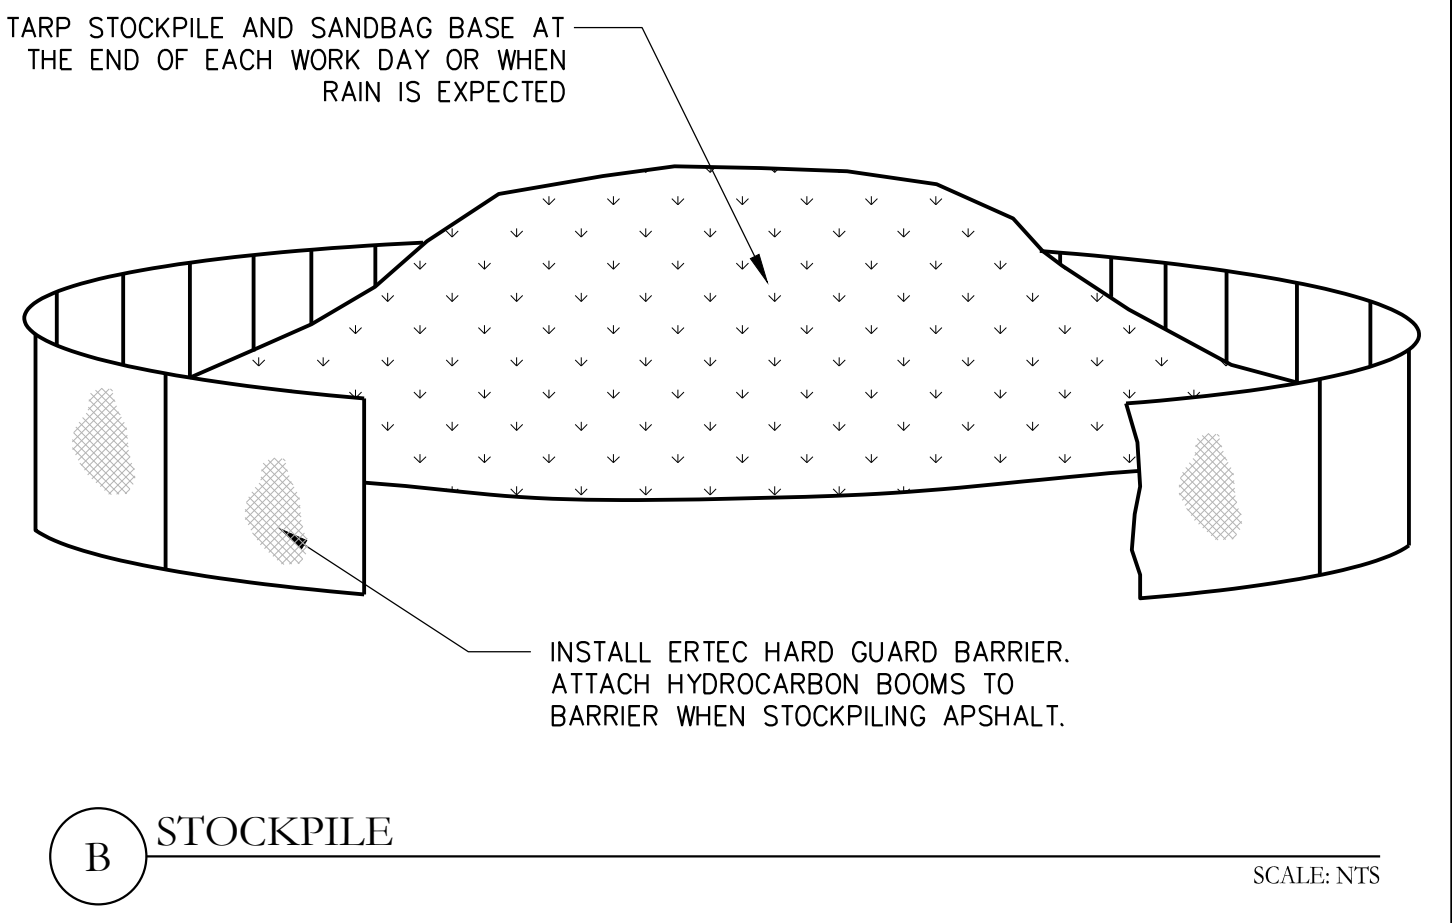

(B) STOCKPILE

SCALE: NTS

ERTEC PROWATTLE™ INSTALLATION DETAILS - PERIMETER

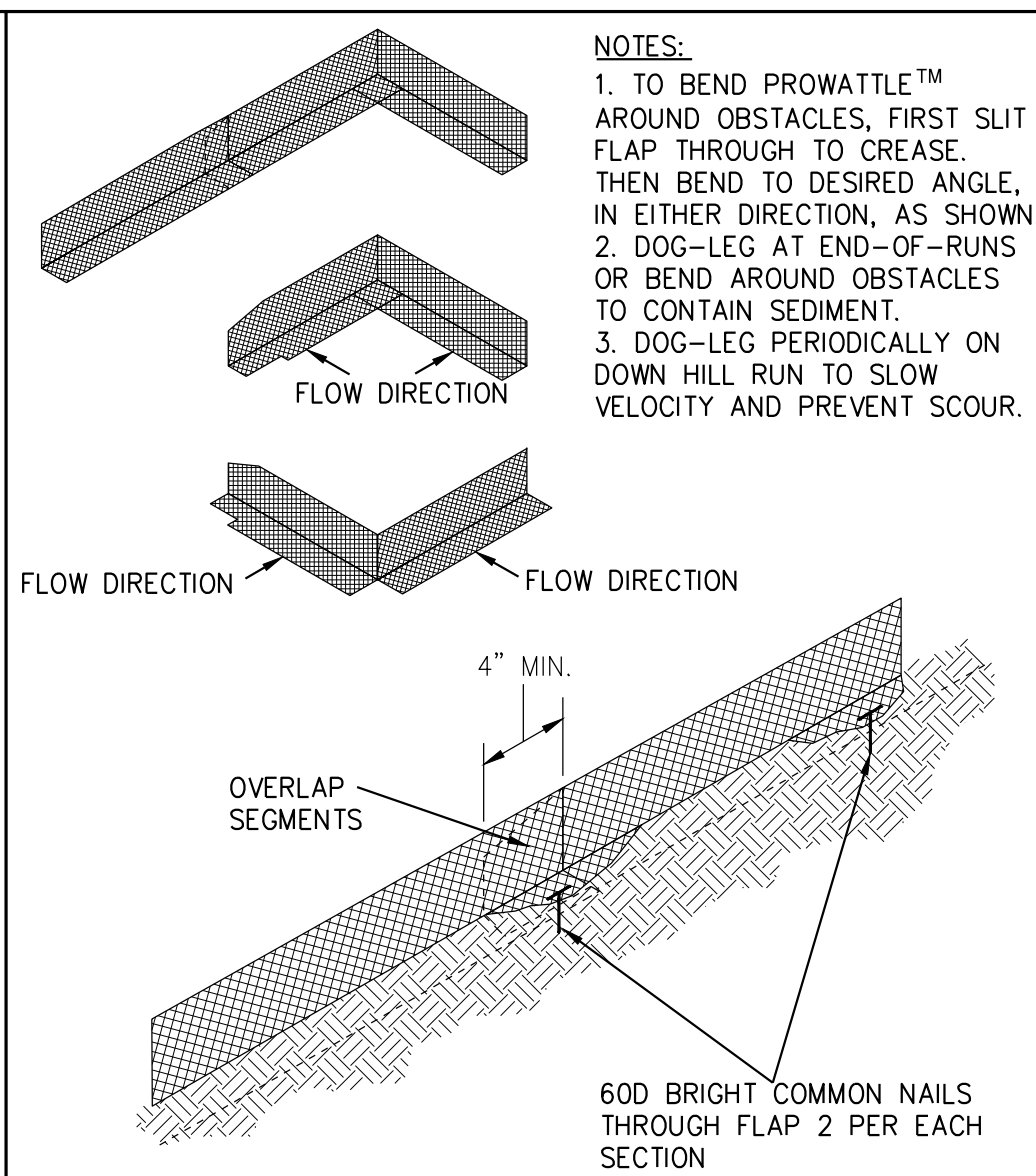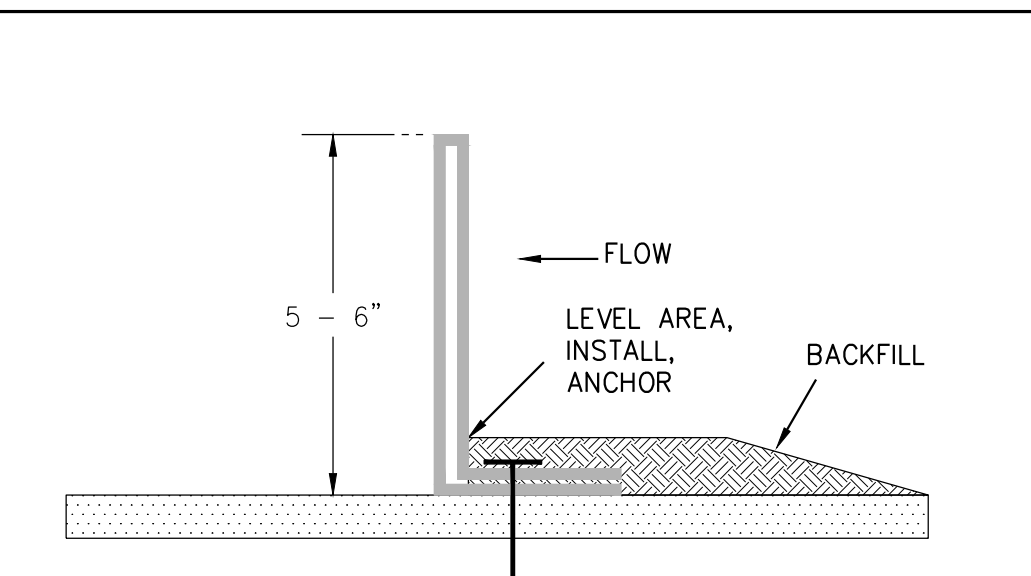

NOTES:  
 1. INSERT ADJOINING SEGMENTS. CHAMFERED END FITS INSIDE ADJOINING SEGMENT.  
 2. USE 6" NAILS (60D BRIGHT-COMMON). INSTALL 2 NAILS PER EACH 7' SEGMENT, ONE AT OVERLAP AND ONE MID-SEGMENT.  
 3. INSTALL NAILS FLUSH WITH FLAP SO THAT FLAP IS IN GOOD CONTACT WITH SOIL.  
 4. COVER FLAP WITH 1" OF SOIL TO PREVENT UNDERCUTTING - NOT NECESSARY TO TRENCH.  
 5. STAKES MIGHT BE REQUIRED. IF SO, INSTALL AS NECESSARY.

MAINTENANCE: PERFORM MAINTENANCE AS REQUIRED. INSPECT FOLLOWING RAINFALL EVENTS AND AT LEAST DAILY DURING PROLONGED RAINFALL. MAINTAIN TO PROVIDE AN ADEQUATE SEDIMENT HOLDING CAPACITY. DEBRIS SHALL BE REMOVED DAILY AND SEDIMENT SHALL BE REMOVED WHEN THE SEDIMENT ACCUMULATION REACHES 50% OF THE BARRIER HEIGHT. REMOVED SEDIMENT SHALL BE INCORPORATED IN THE PROJECT AT DESIGNATED LOCATIONS.

DISCLAIMER: ALL INFORMATION, INCLUDING ILLUSTRATIONS, IS BELIEVED TO BE RELIABLE. USERS, HOWEVER, SHOULD INDEPENDENTLY EVALUATE THE SUITABILITY OF EACH PROJECT FOR THEIR APPLICATION. ERTEC ENVIRONMENTAL SYSTEMS MAKES NO WARRANTIES AS TO THE ACCURACY OF COMPLETENESS OF THE INFORMATION AND DISCLAIMS ANY LIABILITY REGARDING IS USE. ERTEC ENVIRONMENTAL SYSTEMS'S ONLY OBLIGATIONS ARE THOSE IN THE ERTEC ENVIRONMENTAL SYSTEMS STANDARD TERMS AND CONDITIONS OF SALE FOR THIS PRODUCT, AND IN NO CASE WILL ERTEC ENVIRONMENTAL SYSTEMS OR ITS DISTRIBUTORS BE LIABLE FOR ANY INCIDENTAL, INDIRECT OR CONSEQUENTIAL DAMAGES ARISING FROM THE SALE, RESALE, USE OR MISUSE OF THE PRODUCT. SPECIFICATIONS ARE SUBJECT TO CHANGE WITHOUT NOTICE. IN ADDITION, ERTEC ENVIRONMENTAL SYSTEMS RESERVES THE RIGHT TO MAKE CHANGES, WITHOUT NOTIFICATION TO BUYER, TO PROCESSING OR MATERIALS THAT DO NOT AFFECT COMPLIANCE WITH ANY APPLICABLE SPECIFICATION.



**\*\* NOT TO SCALE \*\***

ERTEC Environmental Systems  
 1150 Balboa Blvd., Suite 250, Alameda, CA 94501  
 P: 866-521-0724 F: 510-521-3872  
 www.ertecsystems.com

ERTEC - Installation Details - P3 Perimeter  
 8.5" x 11" 3 of 3

(A) ERTEC PROWATTLE


SCALE: NTS

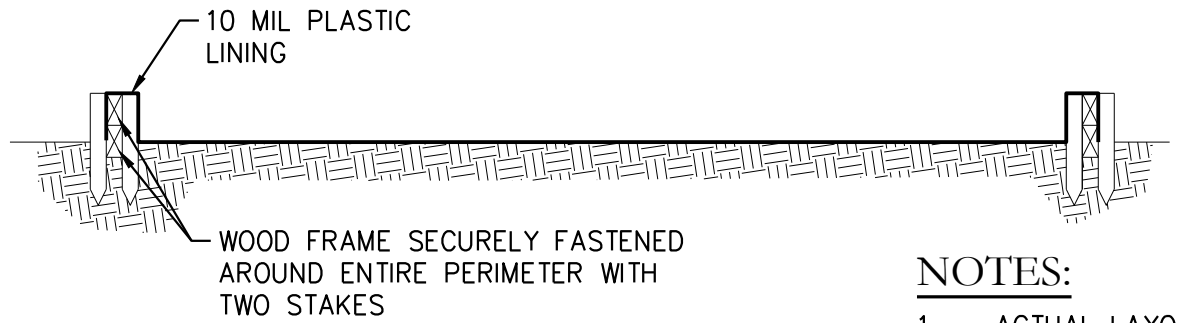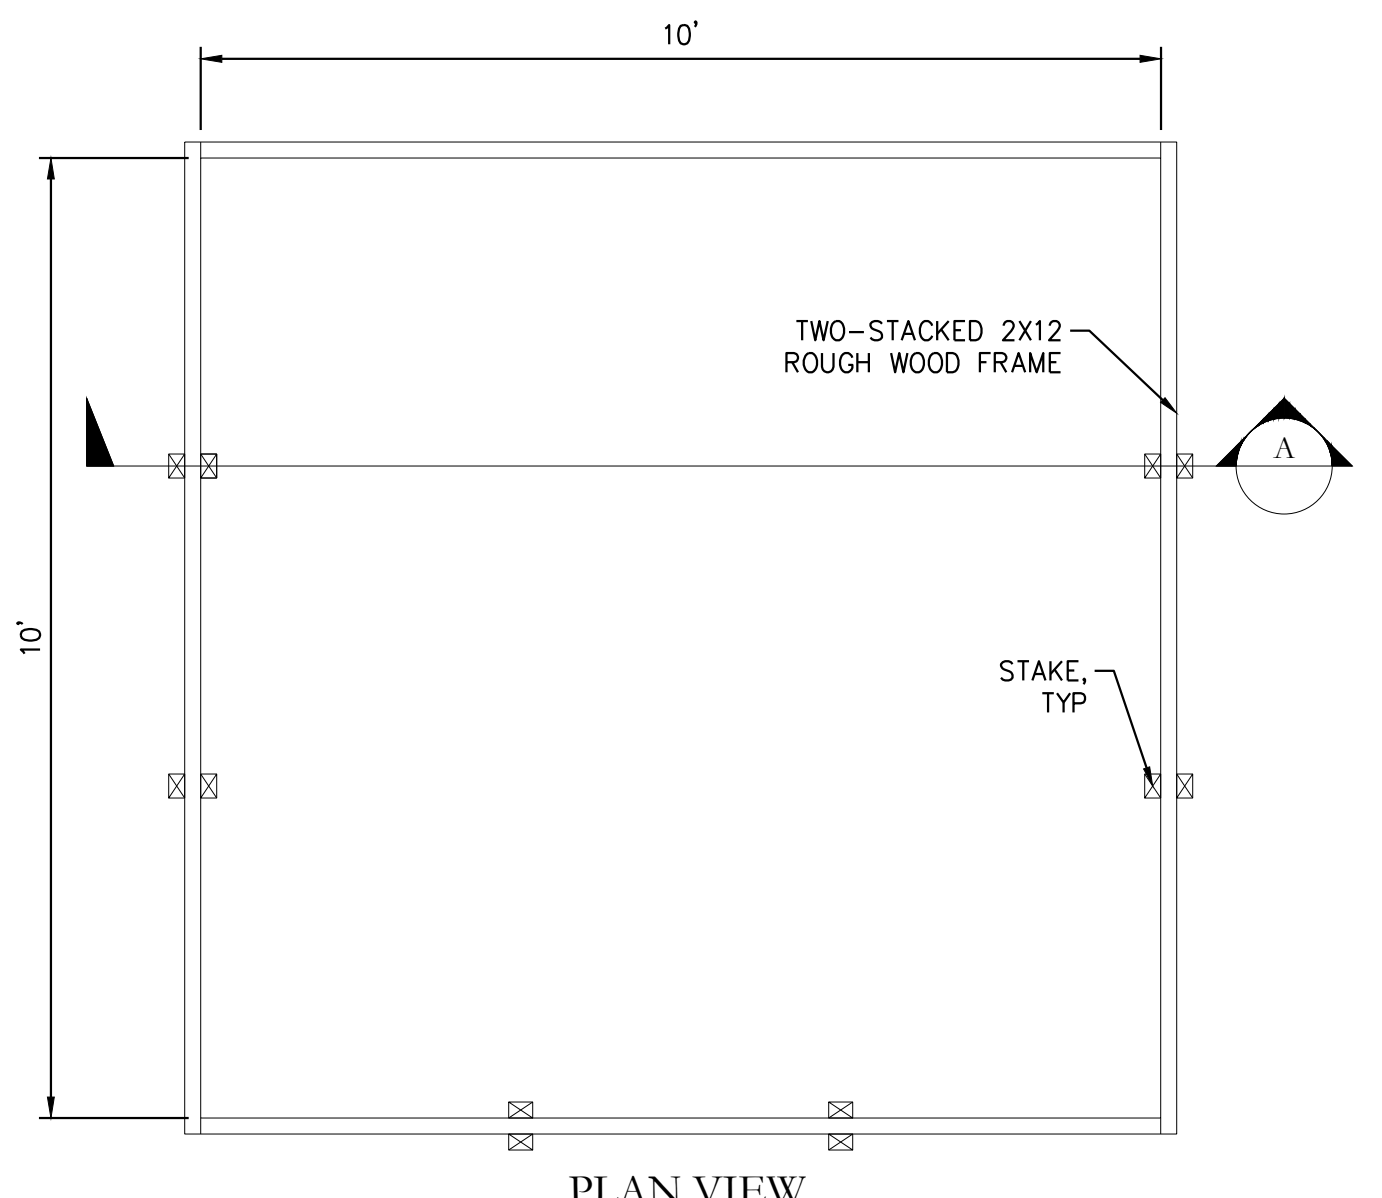

NOTES:  
 1. ACTUAL LAYOUT DETERMINED IN FIELD  
 2. THE CONCRETE WASHOUT SIGN SHALL BE INSTALLED WITHIN 30FT OF THE TEMPORARY CONCRETE WASHOUT FACILITY

(C) CONCRETE WASHOUT

SCALE: NTS

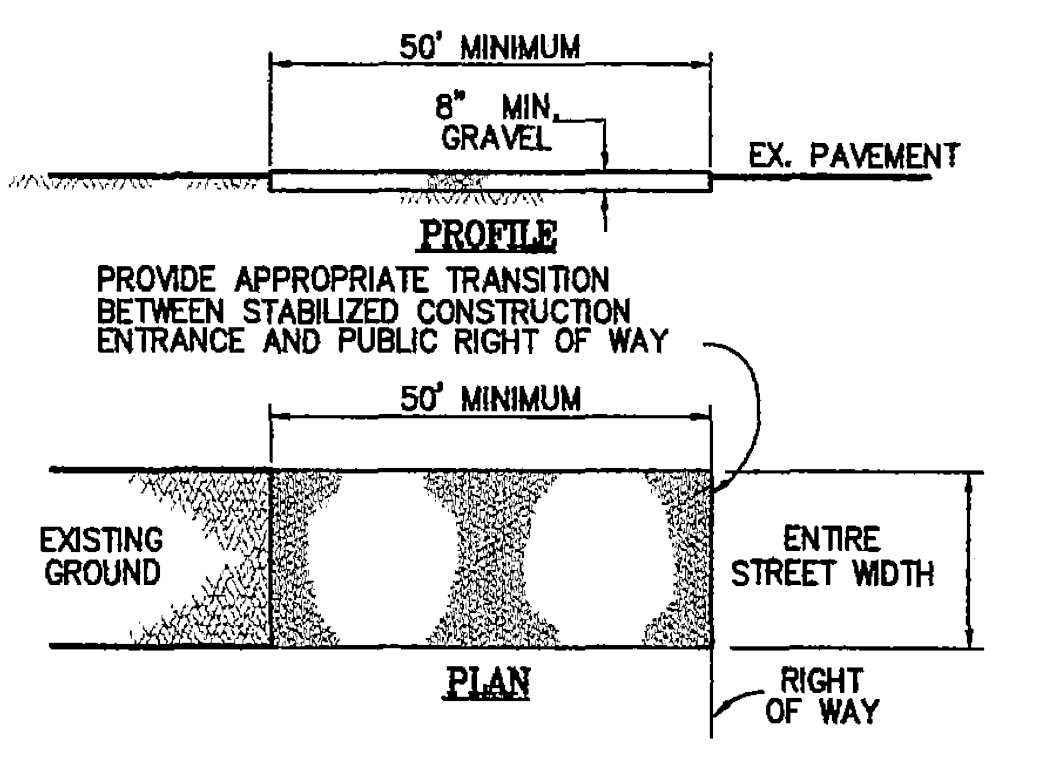

(D) CONSTRUCTION ENTRANCE

SCALE: NTS

CONSTRUCTION SPECIFICATIONS

1. THE MATERIAL FOR CONSTRUCTION SHALL BE 3 TO 4 INCH ROCK
2. LENGTH - AS EFFECTIVE, BUT NOT LESS THAN 50 FEET
3. THICKNESS - NOT LESS THAN TWELVE (12) INCHES
4. WIDTH - NOT LESS THAN FULL WIDTH OF ALL POINTS OF INGRESS OR EGRESS.
5. WASHING - WHEN NECESSARY, WHEELS SHALL BE CLEANED TO REMOVE SEDIMENT PRIOR TO ENTRANCE ONTO PUBLIC RIGHT OF WAY. WASHING IS REQUIRED, IT SHALL BE DONE ON AN AREA WITH CRUSHED STONE WHICH DRAINS INTO AN APPROVED SEDIMENT TRAP OR SEDIMENT BASIN. ALL SEDIMENT SHALL BE PREVENTED FROM ENTERING ANY STORM DRAIN, DITCH, OR WATERCOURSE THROUGH USE OF SAND BAGS, GRAVEL BOARDS OR OTHER APPROVED METHODS.
6. MAINTENANCE - THE ENTRANCE SHALL BE MAINTAINED IN A CONDITION WHICH WILL PREVENT TRACKING OR FLOWING OF SEDIMENT ONTO PUBLIC RIGHT OF WAY. THIS MAY REQUIRE PERIODIC TOP DRESSING WITH ADDITIONAL STONES AS CONDITIONS DEMAND AND REPAIR AND/OR CLEANOUT OF ANY MEASURES USED TO TRAP SEDIMENT. ALL SEDIMENT SPILLED, DROPPED, WASHED OR TRACKED ONTO PUBLIC RIGHT OF WAY MUST BE REMOVED IMMEDIATELY.

PROJECT/CLIENT NAME  
**Dunphy Park Improvement Project**

200 Napa Street  
 Sausalito, CA 94965

Owner:  
 City of Sausalito  
 420 Litho St.  
 Sausalito, CA 94965

RHAA PROJECT NUMBER  
**16042A**

CONSULTANT

SUBMITTAL

Permit Submittal

DATE  
**21 August 2017**

REVISIONS

No.	Date	Description
1	9-18-2017	Permit Plan Check Response

REGISTRATION AND SIGNATURE



SHEET TITLE  
**EROSION CONTROL DETAILS**

DRAWN BY: JG CHECKED BY: MW

**C5.2**



## BioD-Rockbag™

Biodegradable coir rock bags

Completely Wildlife Safe!

### Description


BioD-Rockbag, coir rock bags are made from BioD-Mat 90 woven coir mat which has a minimum weight of 980 g/ sq.m and 38% open area. These bags are strong, durable and completely wildlife safe. These coir rock bags filter sediment effectively and can stand heavy equipment better than synthetic rock bags. Each bag comes with coir twine string so that these bags can be joined together to perform as one unit. Coir rock bags are manufactured to conform to the following properties:

### Specifications

Property	BioD-Rockbag™
Unit weight	29 oz/sy (980 g/m)
Thickness	0.35 in (9 mm)
Rock bag sizes	24 in x 10 in (60 cm x 25 cm) 24 in x 36 in (60 cm x 90 cm)
Fabric	BioD-Mat 90 woven bristle coir blanket
Strength of fabric	
Machine direction	2024 lbs./ft. (29.6 kN/m)
Cross direction	1160 lbs/ft (17 kN/m)




1 800 760 3218  
Tel: 770 506 8211 Fax: 770 506 0391  
E-mail: rolanka@rolanka.com  
Web: www.rolanka.com  
SBA's 8(a) & SDB and DOT DBE Certified

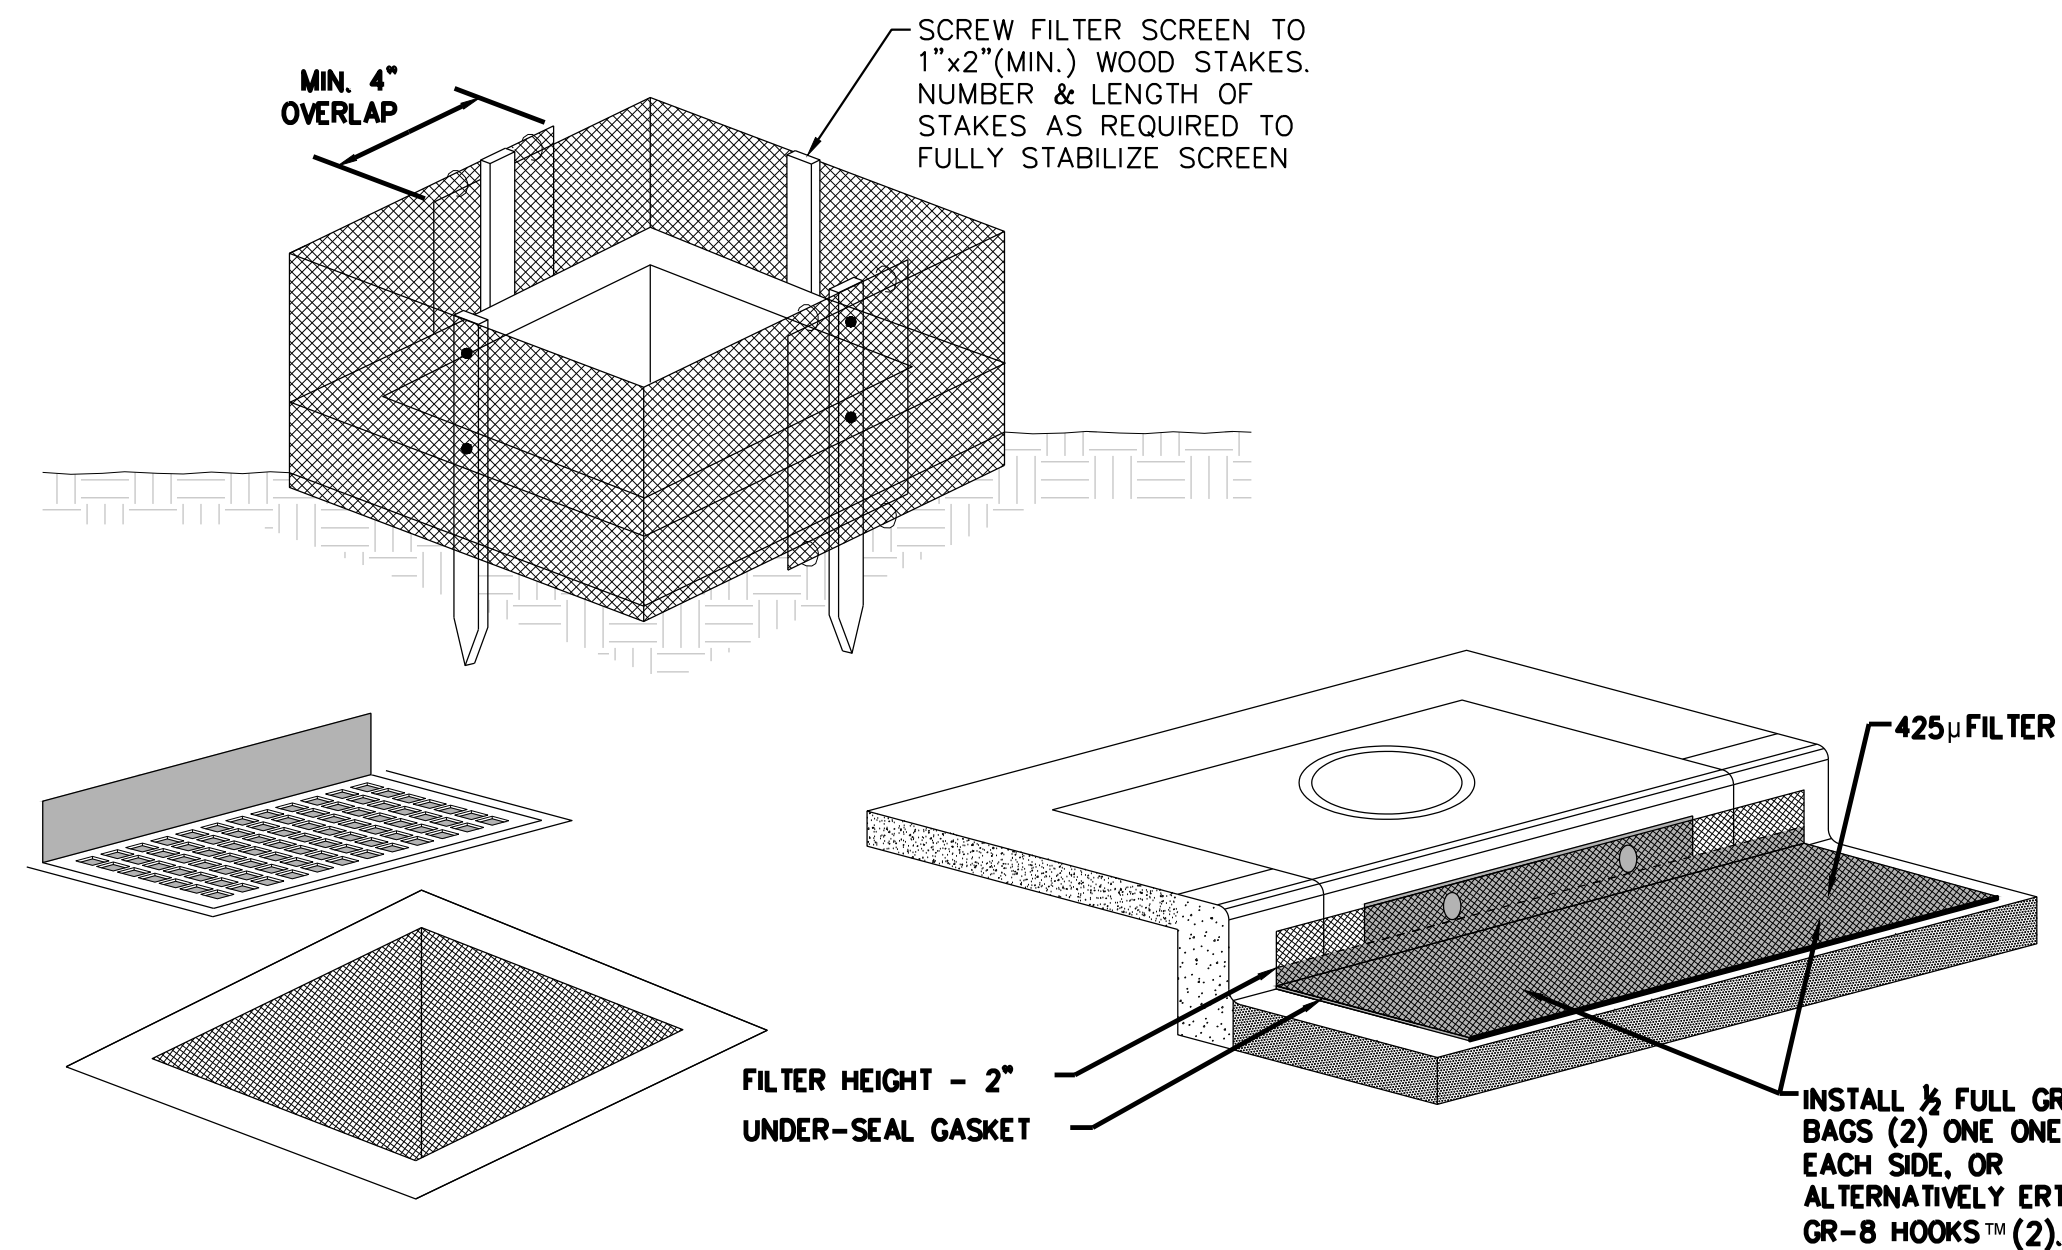

A GRAVEL BAGS SCALE: NTS

B DROP GUARD INSTALLATION SCALE: NTS

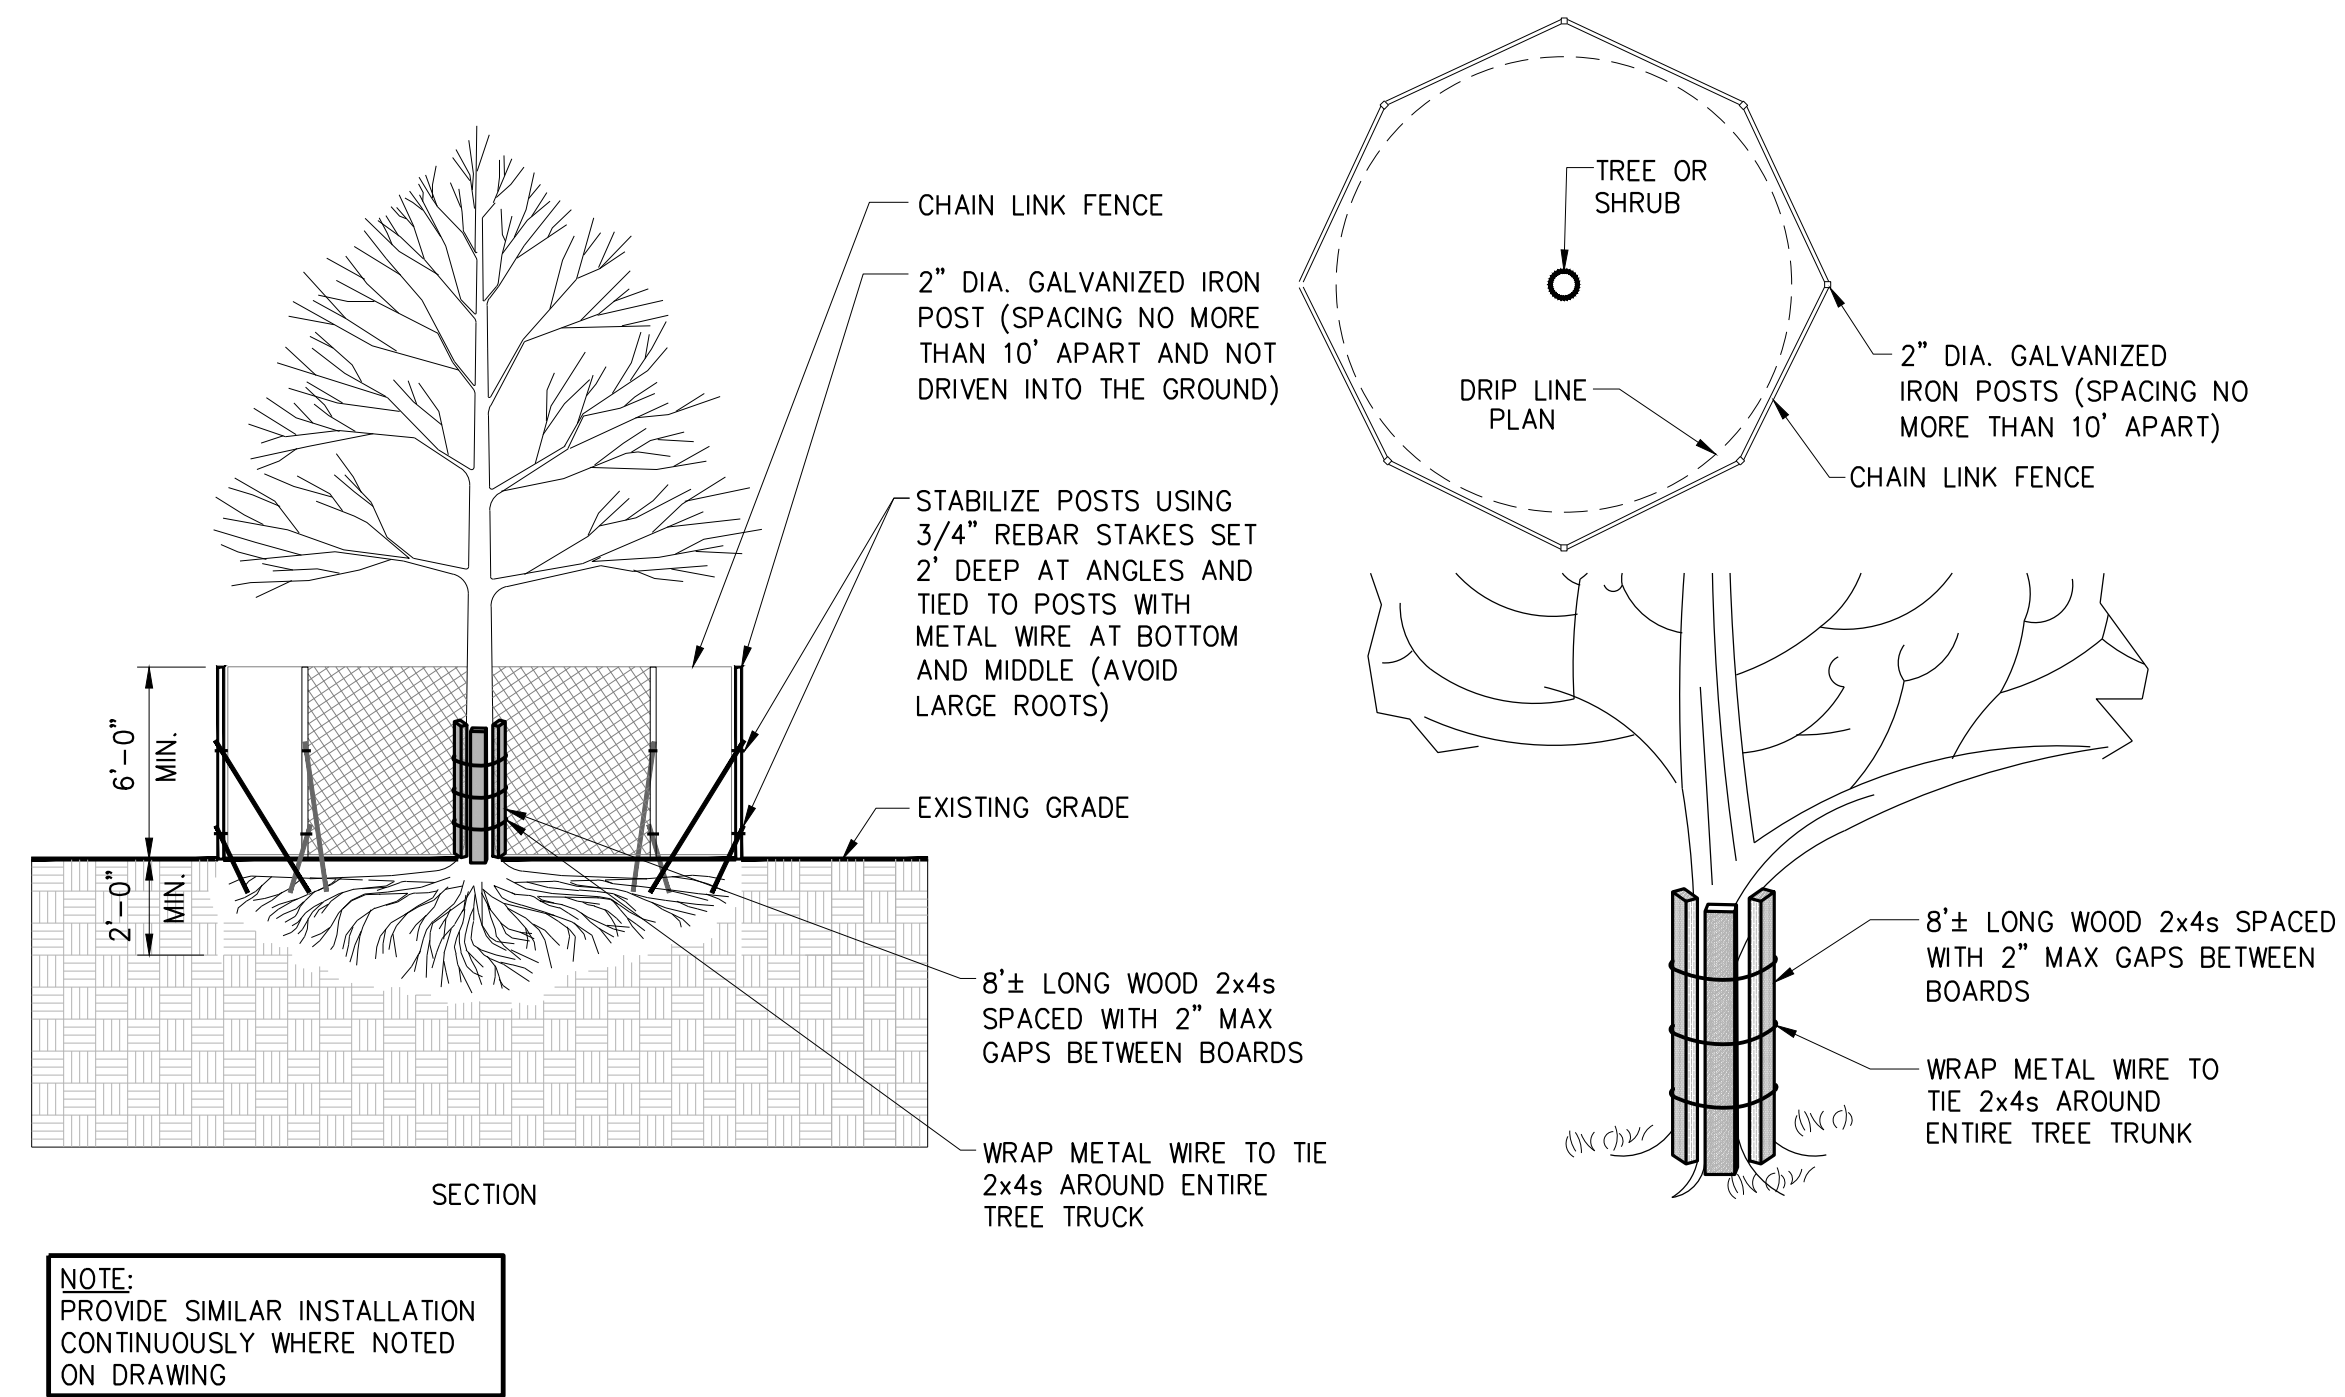

NOTE:  
PROVIDE SIMILAR INSTALLATION  
CONTINUOUSLY WHERE NOTED  
ON DRAWING

C TREE PROTECTION FENCE SCALE: NTS

# rhaa

LANDSCAPE ARCHITECTURE + PLANNING  
225 Miller Avenue, Mill Valley, CA 94941  
T 415 383 7900 F 415 383 1433 www.rhaa.com

PROJECT/CLIENT NAME

Dunphy Park  
Improvement Project

200 Napa Street  
Sausalito, CA 94965

Owner:  
City of Sausalito  
420 Litho St.  
Sausalito, CA 94965

RHAA PROJECT NUMBER

16042A

CONSULTANT

SUBMITTAL

Permit Submittal

DATE  
21 August 2017

REVISIONS

No.	Date	Description
1	9-18-2017	Permit Plan Check Response

REGISTRATION AND SIGNATURE



SHEET TITLE

EROSION CONTROL  
DETAILS

DRAWN BY: JG CHECKED BY: MW

# C5.3

PROJECT/CLIENT NAME

## Dunphy Park Improvement Project

200 Napa Street  
Sausalito, CA 94965

Owner:  
City of Sausalito  
420 Litho St.  
Sausalito, CA 94965

RHAA PROJECT NUMBER

16042A

CONSULTANT



SUBMITTAL



### Permit Submittal

DATE  
21 August 2017

REVISIONS

No.	Date	Description
1	9-18-2017	Permit Plan Check Response

REGISTRATION AND SIGNATURE

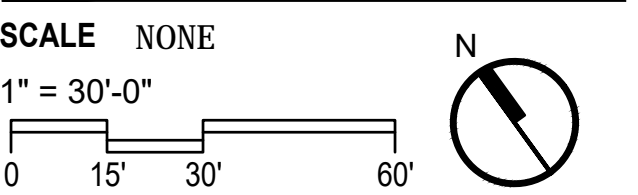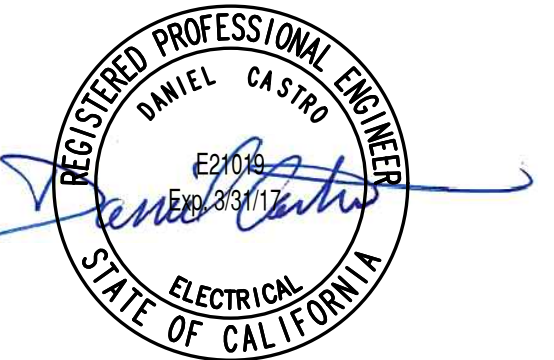

SHEET TITLE

ELECTRICAL  
LEGEND AND  
NOTES

DRAWN BY: KZ CHECKED BY:

E0.1

POWER SYMBOLS		GENERAL NOTES		LIGHTING SYMBOLS		CODE COMPLIANCE	
	PANELBOARD, 120/240V, SURFACE MOUNTED SIZE APPROXIMATELY AS SHOWN		DUPLEX CONVENIENCE RECEPTACLE OUTLET, WITH GROUND MOUNT AT +18" UON, 125V, 15A, TAMPER RESISTANT TYPE		FLUORESCENT OR LED LIGHTING FIXTURE, REFER TO FIXTURE SCHEDULE FOR ADDITIONAL INFORMATION A1 = FIXTURE TYPE 13 = CIRCUIT o = SWITCH LEG	ALL WORK PERFORMED UNDER THIS CONTRACT SHALL CONFORM TO THE FOLLOWING CODES AND REGULATIONS AS APPLICABLE:  • 2016 CALIFORNIA BUILDING STANDARDS ADMINISTRATIVE CODE (PART 1, TITLE 24, CCR) • 2016 CALIFORNIA BUILDING CODE, VOLUMES 1 AND 2 (PART 2, TITLE 24, CCR) • 2016 CALIFORNIA ELECTRICAL CODE (PART 3, TITLE 24, CCR) • 2016 CALIFORNIA ENERGY CODE (PART 6, TITLE 24, CCR) • 2016 CALIFORNIA FIRE CODE (PART 9, TITLE 24, CCR) • 2016 CALIFORNIA REFERENCED STANDARDS CODE (PART 12, TITLE 24, CCR)	
	PANELBOARD, 120/240V, FLUSH MOUNTED SIZE APPROXIMATELY AS SHOWN		DOUBLE DUPLEX CONVENIENCE RECEPTACLE OUTLET, WITH GROUND MOUNT AT +18" UON, 125V, 20A		ROUND PENDANT LIGHTING FIXTURE, REFER TO FIXTURE SCHEDULE FOR ADDITIONAL INFORMATION		
	DISCONNECT SWITCH (F=FUSED)		GFCI DUPLEX CONVENIENCE RECEPTACLE OUTLET, MOUNT HORIZONTALLY AT +6" ABOVE COUNTER UON, 125V, 15A		ROUND RECESSED DOWNLIGHT, REFER TO FIXTURE SCHEDULE FOR ADDITIONAL INFORMATION		
	ELECTRICAL MOTOR CONNECTION		GFCI DUPLEX CONVENIENCE RECEPTACLE OUTLET, WITH GROUND MOUNT AT +18" UON, 125V, 15A		FLUORESCENT OR LED LIGHTING FIXTURE, WALL MOUNTED, REFER TO FIXTURE SCHEDULE FOR ADDITIONAL INFORMATION		
	JUNCTION BOX, MOUNT ABOVE ACCESSIBLE CEILING UON		CONTROLLED DUPLEX CONVENIENCE RECEPTACLE OUTLET, UON, 125V, 15A. THE LETTER INDICATES THE SWITCH LEG.		EXIT SIGN WITH INTEGRAL EMERGENCY BACKUP, CEILING OR WALL MOUNTED. DIRECTIONAL ARROW(S) AS INDICATED, ILLUMINATED FACE AS INDICATED BY SHADING.		
	JUNCTION BOX, WALL MOUNTED, +18" UON		DUPLEX GROUND RECEPTACLE OUTPUT FLUSH MOUNTED IN CEILING. 125V, 20A		FLUORESCENT OR LED LIGHTING FIXTURE WITH INTEGRAL EMERGENCY BATTERY BACKUP.		
	JUNCTION BOX, FLOOR MOUNTED		DUPLEX CONVENIENCE RECEPTACLE OUTLET, MOUNT HORIZONTALLY AT +6" ABOVE COUNTER UON, 125V, 15A		LIGHTING FIXTURE(S). POLE MOUNTED. NUMBER OF ARMS AS SHOWN ON DRAWINGS. REFER TO FIXTURE SCHEDULE FOR ADDITIONAL INFORMATION A1 = FIXTURE TYPE 13 = CIRCUIT		
	STANDARD TEL/DATA WALL OUTLET, MOUNT AT SAME HEIGHT AS ADJACENT RECEPTACLE.		SPECIALTY RECEPTACLE OUTLET, MOUNT AT +18" UON TYPE AS INDICATED				
	STANDARD DATA WALL OUTLET, MOUNT AT SAME HEIGHT AS ADJACENT RECEPTACLE.		RECESSED FLUSH DUPLEX RECEPTACLE OUTLET 125V, 20A.				
	SYSTEM SMOKE DETECTOR, SURFACE MOUNTED IN CEILING		RECESSED FLUSH DOUBLE DUPLEX RECEPTACLE OUTLET, 125V, 20A.				
	SINGLE POLE SWITCH, MOUNT AT +42" UON, LETTER INDICATES THE SWITCH LEG UON		MOTION SENSOR				
	KEY OPERATED SWITCH, MOUNT AT +42" UON		PHOTOCCELL				
	CONDUIT AND WIRE RUN IN WALL OR CEILING SPACE						
	CONDUIT AND WIRE RUN CONCEALED IN SLAB, UNDER SLAB OR UNDERGROUND						
ABBREVIATIONS				CONVENTIONS			
AC ABOVE COUNTER	(E) EXISTING TO REMAIN	GND GROUND	(N) NEW	(R) EXISTING TO BE RELOCATED	UG UNDER GROUND		
AFF ABOVE FINISHED FLOOR	EC EMPTY CONDUIT	GD GARBAGE DISPOSAL	N, NEUT NEUTRAL	RAC RIGID ALUMINUM CONDUIT	UON UNLESS OTHERWISE NOTED		
AIC AMPERES INTERRUPTING CAPACITY	ECC ENGINEERING CONTROL CENTER	G GROUND FAULT INTERRUPTER	NC NOT IN CONTRACT	RS RIGID STEEL	VFD VARIABLE FREQUENCY DRIVE		
AHU AIR HANDLING UNIT	ECH ELECTRIC CABINET HEATER	HID HIGH INTENSITY DISCHARGE	NO NORMALLY CLOSED	RSC RIGID STEEL CONDUIT	VP VIDEO PROJECTOR		
ATS AUTOMATIC TRANSFER SWITCH	EF EXHAUST FAN	HP HEAT PUMP	NO NORMALLY OPEN	SCC SECURITY CONTROL CENTER	VSD VARIABLE SPEED DRIVE		
A/V AUDIO VISUAL	ELEV ELEVATOR	HX HEAT EXCHANGER	NEC NATIONAL ELECTRICAL CODE	SDR STUDIO DIMMER RACK	WP WEATHERPROOF		
	EM EMERGENCY		NTS NOT TO SCALE	SEP SEWAGE EJECTOR PUMP	WT WATER TIGHT		
B BOILER	EMT ELECTRICAL METALLIC TUBING		OL OVERLOAD RELAY	SP SUMP PUMP	(X) EXISTING TO BE REMOVED		
BMS BUILDING MANAGEMENT SYSTEM	EPO EMERGENCY POWER OFF	IC INTERRUPTING CAPACITY	OG OZONE GENERATOR	ST STANDBY	XFMR TRANSFORMER		
BP BOOSTER PUMP	EPW ELECTRIC WATER HEATER	IG ISOLATED GROUND		TB TELEPHONE BOARD	XP EXPLOSION PROOF		
	EWC ELECTRIC WATER COOLER	IW instant water heater		TBC TO BE ADVISED			
C CONDUIT		IP IRRIGATION PUMP		TCL TO BE CONFIRMED			
C.O. CONDUIT ONLY	F FUSED		P PUMP	TEL TELECOM			
CB CIRCUIT BREAKER	FAFP FIRE ALARM ANNUNCIATOR PANEL	JB JUNCTION BOX	PB PUSHBUTTON SWITCH	TF TRANSFER FAN			
CO CARBON MONOXIDE SENSOR	FACP FIRE ALARM CONTROL PANEL		PC PHOTOCCELL	TP TRANSFER PANEL			
CHWP CHILLED WATER PUMP	FATC FIRE ALARM TERMINAL PANEL	LCP LIGHTING CONTROL PANEL	PV POST INDICATING VALVE	TYP TYPICAL			
CKT CIRCUIT	FBO FURNISHED BY OTHERS		PNL PANELBOARD				
CL CENTER LINE	FCC FIRE CONTROL CENTER	MAU MAKE UP AIR UNIT	POC POINT OF CONNECTION				
CM COFFEE MAKER	FCU FAN COIL UNIT	MCC MOTOR CONTROL CENTER	POS POINT OF SALE				
CP CIRCULATION PUMP	FLUOR FLUORESCENT	MIC MINERAL INSULATED CABLE	PRT PRINTER				
CT CURRENT TRANSFORMER	FP FIRE PUMP	MD MOTORIZED DOOR	PVC POLYVINYL CHLORIDE CONDUIT				
CU CONDENSING UNIT	FVNR FULL VOLTAGE NON-REVERSING	MS MOTORIZED SHADES					
D DEDICATED (POWER & SIGNAL) /DIMMING (LIGHTING)		MW MICROWAVE					
DP DIMMING PANEL							

DUNPHY PARK IMPROVEMENTS VOLTAGE DROP CALCULATION							
FEEDER	MAX. CURRENT (A)	SUPPLYING BREAKER RATING (A)	FEEDER SIZE (AWG/KCM)	LENGTH (FT) FROM MAIN SWITCHBOARD (Approx)	IMPEDANCE (Z) (OHMS/KFT)	VOLTAGE DROP (V)	% VD (MAX. 3%)
PNL MAIN	60	100	# 1	10	0.1641	0.20	0.08
PNL R	10	50	# 6	360	0.4632	3.34	1.39

### 4 VOLTAGE DROP CALCULATION

SCALE: NONE

LIGHTING FIXTURE SCHEDULE											
TYPE	DESCRIPTION	MANUFACTURER	MODEL	LAMP(S)	DRIVER	DIMMING TYPE	VOLTS (V)	WATTS (W)	EFFICACY (LPW)	MOUNTING TYPE	LOCATION
F1	POLE LIGHTING, FLARED EDGE, BASE FIXTURE, FLAT GLASS LENS, 4500K, 6665 LUMENS, COORDINATE COLOR WITH ARCHITECT. SINGLE ARM MOUNTING CONFIGURATION. ELECTRONIC BUTTON PHOTOCONTROL	STERNBERG LIGHTING	1A-1970LED-F-BG-4ARC-45-T3R-MDL03-FG-PEC	LED	LED DRIVER	0-10	120	65 W each	102.6	POLE SINGLE ARM	TYPICAL
F2	POLE LIGHTING, FLARED EDGE, BASE FIXTURE, FLAT GLASS LENS, 4500K, 6665 LUMENS, COORDINATE COLOR WITH ARCHITECT. DOUBLE ARM MOUNTING CONFIGURATION. ELECTRONIC BUTTON PHOTOCONTROL	STERNBERG LIGHTING	2A-1970LED-F-BG-4ARC-45-T3R-MDL03-FG-PEC	LED	LED DRIVER	0-10	120	65 W each	102.6	POLE DOUBLE ARM	TYPICAL

### LIGHTING GENERAL NOTES:

- ALL LIGHTING FIXTURES SHALL BE SUPPLIED WITH THE MOUNTING ACCESSORIES, TRIMS AND/OR SHROUDS NECESSARY TO PROPERLY AND COMPLETELY INSTALL THE FIXTURES. CONTRACTOR SHALL VERIFY WITH ARCHITECT THE COLOR AND FINISH OF FIXTURES TO THE CLOSEST STANDARD COLOR AND FINISH BEFORE ORDERING.
- COORDINATE LIGHTING CONTROLS AND PROVIDE AS REQUIRED BY MANUFACTURER TO ACHIEVE A COMPLETE WORKING SYSTEM.

### 3 LIGHTING FIXTURE SCHEDULE

SCALE: NONE

WIRING SCHEDULE - COPPER CONDUCTORS (0-600V)									
CIRCUIT RATING	CONDUIT SIZE (INCHES)						CONDUCTOR SIZE		
	G	N	NG	NGI	NNG	NNGI	PHASE/NEUTRAL	GND*	IG
15	0.75	0.75	0.75	0.75	0.75	0.75	12	12	
20	0.75	0.75	0.75	0.75	0.75	0.75	12	12	
30	0.75	0.75	0.75	0.75	0.75	0.75	10	10	
40	0.75	0.75	1	1	1	1	8	10	
50	1	1	1.25	1.25	1.25	1.25	6	10	
60	1.25	1.25	1.25	1.5	1.5	1.5	4	10	
70	1.25	1.25	1.25	1.5	1.5	1.5	4	8	
80	1.25	1.25	1.5	2	2	2	2	8	
90	1.25	1.25	1.5	2	2	2	2	8	
100	1.5	1.5	2	2	2	2.5	1	8	
110	1.5	1.5	2	2	2	2.5	1	6	
125	1.5	1.5	2	2	2	2.5	1	6	
150	2	2	2	2.5	2.5	2.5	1/0	6	
175	2	2	2	2.5	2.5	2.5	2/0	6	
200	2	2	2.5	2.5	2.5	3	3/0	6	
225	2.5	2.5	2.5	3	3	3	4/0	4	
250	2.5	2.5	3	3	3	3.5	250	4	
300	3	3	3.5	3.5	3.5	4	350	4	
350	3.5	3.5	4	4	4	5	500	2	
400	2@2	2@2	2@2.5	2@2.5	2@2.5	2@3	3/0	2	
450	2@2.5	2@2.5	2@2.5	2@3	2@3	2@3	4/0	2	
500	2@2.5	2@2.5	2@3	2@3	2@3	2@3.5	250	1	
600	2@3	2@3	2@3.5	2@3.5	2@3.5	2@4	350	1	
700	2@3.5	2@3.5	2@4	2@4	2@4	2@5	500	1/0	
800	3@3	3@3	3@3.5	3@3.5	3@3.5	3@3.5	300	1/0	
1000	3@3	3@3	3@3.5	3@4	3@4	3@4	400	2/0	
1200	4@3	4@3	4@3.5	4@3.5	4@3.5	4@4	350	3/0	
1600	5@3	5@3	5@3.5	5@4	5@4	5@4	400	4/0	
2000	6@3.5	6@3.5	6@4	6@4	6@4	6@5	500	250	
2500	7@3.5	7@3.5	7@4	7@4	7@4	7@4	500	350	
3000	8@3.5	8@3.5	8@4	8@4	8@4	8@4	500	400	

SUBSCRIPT KEY	
SUBSCRIPT	CONDUCTORS PER CONDUIT
G	PHASE CONDUCTORS, 1 GROUNDING CONDUCTOR
N	PHASE CONDUCTORS, 1 NEUTRAL CONDUCTOR, CONDUIT GROUND
NG	PHASE CONDUCTORS, 1 NEUTRAL CONDUCTOR, 1 GROUNDING CONDUCTOR
NGI	PHASE CONDUCTORS, 1 NEUTRAL CONDUCTOR, 1 GROUNDING CONDUCTOR, 1 ISOLATED GROUNDING CONDUCTOR
NNG	PHASE CONDUCTORS, 2 NEUTRAL CONDUCTORS*, 1 GROUNDING CONDUCTOR
NNGI	PHASE CONDUCTORS, 2 NEUTRAL CONDUCTORS*, 1 GROUNDING CONDUCTOR, 1 ISOLATED GROUNDING CONDUCTOR

### 2 WIRING SCHEDULE

SCALE: NONE

LIGHTING SEQUENCE OF OPERATION									
ROOM TYPE / FUNCTION	OCCUPANCY SENSOR-AUTO ON	OCCUPANCY SENSOR-MANUAL OFF	OCCUPANCY SENSOR-AUTO OFF	OCCUPANCY SENSOR-PARTIAL ON/OFF	MANUAL ON/OFF SWITCH	DAYLIGHT SENSOR + AUTO DIMMING	MANUAL DIMMING	TIME CLOCK	
RESTROOMS	•	•	•		•				
UTILITY ROOM					•				
EXTERIOR LIGHTING ATTACHED TO RESTROOM BUILDING					•	•		•	
EXTERIOR LIGHTING - PARKING LOT LIGHTING FIXTURES						•		•	
EXTERIOR LIGHTING - BOCCÉ COURT LIGHTING FIXTURES					•	•		•	

### 5 LIGHTING SEQUENCE OF OPERATION

SCALE: NONE

NAME: R (ADD/ALT)*		VOLTAGE: 120/240			BUS SIZE: 50A				MIN. AIC:			
MOUNT:	SURFACE	PHASE/WIRE: 1PH 3W			MAIN: 50A				SERVED FROM: MAIN			
CKT NO.	BKR/POLE	DESCRIPTION	ØA	ØB	R	L/C	M	N	K	DESCRIPTION	BKR/POLE	CKT NO.
1	20/1	RESTROOM LIGHTS	100	360		100				RESTROOM GFCI REC	20/1	2
3	20/1	RESTROOM EXT LIGHTS	120	360		120				RESTROOM GFCI REC	20/1	4
5	20/1	DOOR LOCK	100	400		100				RESTROOM EF	20/1	6
7	20/1	SPARE	0	400		400				RESTROOM EF	20/1	8
9	20/1	SPARE	0	0		0				SPARE	20/1	10
11		SPACE	0	0		0				SPACE		12
CONNECTED LOAD SUBTOTALS			960	880	720	320	800	0	0			
CONNECTED LOAD (KVA)			1.8									
CONNECTED LOAD (AMPS):			7.67							65% OF CONNECTED	0.0	KVA
DEMAND LOAD (AMPS):			9.25							100% OF CONNECTED	0.0	KVA
										CONNECTED + 25% LARGEST	1.1	KVA
										125% OF CONNECTED	0.4	KVA
										FIRST 10KVA + 50% REMAINDER	0.72	KVA
										TOTAL CALCULATED DEMAND LOAD PER NEC	2.2	KVA

NAME: MAIN		VOLTAGE: 120/240			BUS SIZE: 100A				MIN. AIC:			
MOUNT:	EXTERIOR	PHASE/WIRE: 1PH 3W			MAIN: 100A				SERVED FROM: PG&E TX			
CKT NO.	BKR/POLE	DESCRIPTION	ØA	ØB	R	L/C	M	N	K	DESCRIPTION	BKR/POLE	CKT NO.
1	20/1	PARKING LIGHTS	650	4800		650				GAZEBO SPIDER BOX	50/2	2
3	20/1	BOCCÉ LIGHTS	520	4800		520				GAZEBO REC	20/1	6
5	20/1	IRRIGATION CTRL	50	180		50				GAZEBO REC	20/1	8
7	50/2	PNL R (RESTROOM ADD/ALT)	960	880	720	320	800	0	0	PICNIC REC	20/1	10
9		SPARE	0	360		360				BOCCÉ REC	20/1	12
11	20/1	SPARE	0	180		180				SPARE	20/1	14
13	20/1	SPARE	0	0		0				SPARE	20/1	16
15	20/1	SPACE	0	0		0				SPACE		18
17		SPACE	0	0		0				SPACE		20
19		SPACE	0	0		0				SPACE		20
CONNECTED LOAD SUBTOTALS			7000	6560	11220	1540	800	0	0			
CONNECTED LOAD (KVA)			13.6									
CONNECTED LOAD (AMPS):			56.50							65% OF CONNECTED	0.0	KVA
DEMAND LOAD (AMPS):			58.06							100% OF CONNECTED	0.0	KVA
										CONNECTED + 25% LARGEST	1.4	KVA
										125% OF CONNECTED	1.9	KVA
										FIRST 10KVA + 50% REMAINDER	10.61	KVA
										TOTAL CALCULATED DEMAND LOAD PER NEC	13.9	KVA


### 1 PANELBOARD SCHEDULES

SCALE: NONE

PROJECT/CLIENT NAME  
**Dunphy Park Improvement Project**

200 Napa Street  
Sausalito, CA 94965  
  
Owner:  
City of Sausalito  
420 Litho St.  
Sausalito, CA 94965

RHAA PROJECT NUMBER  
16042A  
  
CONSULTANT

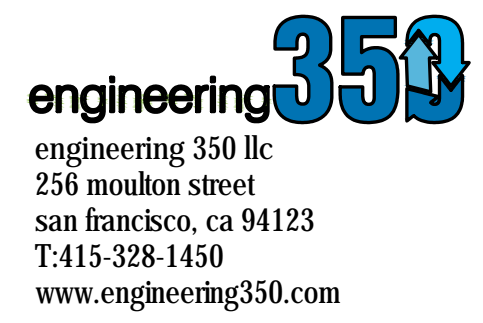


SUBMITTAL  
Permit Submittal

DATE  
21 August 2017

REVISIONS		
No.	Date	Description
1	9-18-2017	Permit Plan Check Response

REGISTRATION AND SIGNATURE

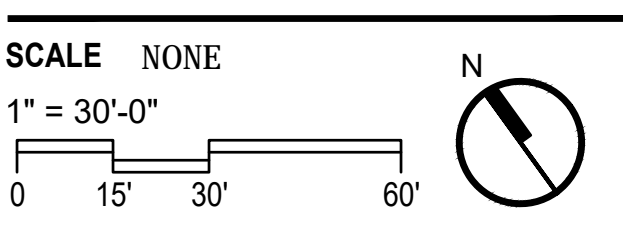

SHEET TITLE  
**ELECTRICAL SCHEDULES**

DRAWN BY: KZ CHECKED BY:

PROJECT/CLIENT NAME

Dunphy Park Improvement Project

200 Napa Street
Sausalito, CA 94965

Owner:
City of Sausalito
420 Litho St.
Sausalito, CA 94965

RHAA PROJECT NUMBER

16042A

CONSULTANT



engineering 350 llc
256 moulton street
san francisco, ca 94123
T: 415-328-1450
www.engineering350.com

SUBMITTAL

Permit Submittal


DATE

21 August 2017


REVISIONS

Table with columns: No., Date, Description. Row 1: 1, 9-18-2017, Permit Plan Check Response

REGISTRATION AND SIGNATURE

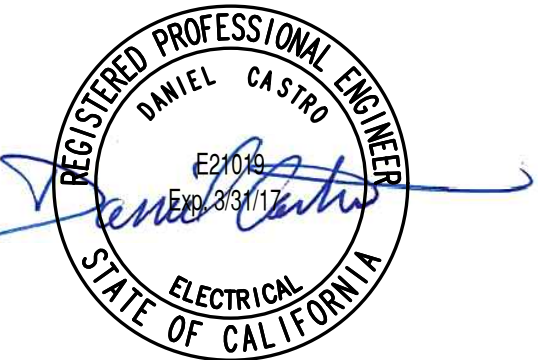

SCALE NONE

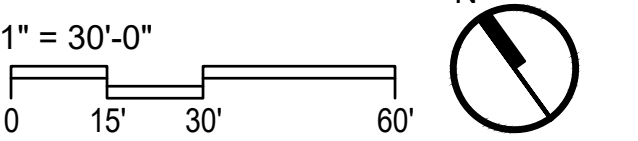

SHEET TITLE

TITLE 24 COMPLIANCE

DRAWN BY: KZ CHECKED BY:

STATE OF CALIFORNIA Electrical Power Distribution CERTIFICATE OF COMPLIANCE NRCC-ELC-01-E (Page 3 of 6)

A. Service Electrical Metering
Check one of the three boxes below if the electrical power distribution system is in compliance with Section 130.5(a).
[ ] For newly installed electrical service in newly constructed buildings...
[ ] For new or replacement electrical service equipment in existing buildings...
[X] EXCEPTION to Electrical Service Metering: Service or feeder for which the utility company provides a metering system...

Table with columns: Electrical Service Schedule, Electrical Service Rating, Metering Capabilities, Exception to 130.5(a), Field Inspector. Row 1: 01, 02, 03, 04, 05, 06, 07, 08. Row 2: PNL MAIN / EXTERIOR, 12.1 kVA, [X], [ ], [X], [ ], [X], [ ], [X], [ ]

STATE OF CALIFORNIA Electrical Power Distribution CERTIFICATE OF COMPLIANCE NRCC-ELC-01-E (Page 2 of 6)

Table with columns: Document Number, Document Title / Descriptions, Document Sheet # or Page #, Applicable subsection of Section 130.5. Row 1: ELECTRICAL DRAWINGS SET, ELECTRICAL CALCS & SCHEDULES, E0.2, 130.5(c)

STATE OF CALIFORNIA Electrical Power Distribution CERTIFICATE OF COMPLIANCE NRCC-ELC-01-E (Page 1 of 6)

General Information
Project Address: 200 NAPA STREET, SAUSALITO, CA 94965
Climate Zone: CZ3
Building Type: [X] Nonresidential, [ ] High-Rise Residential, [ ] School, [ ] Relocatable Public Schools, [ ] Hotel/Motel
Phase of Construction: [ ] New Construction, [ ] Addition, [X] Alteration

Table with columns: Document Number, Document Title / Descriptions, Document Sheet # or Page #, Indicate which subsection of Section 130.5 is related to the document... Row 1: ELECTRICAL DRAWINGS SET, ELECTRICAL CALCS & SCHEDULES, E0.2, 130.5(c)

STATE OF CALIFORNIA Electrical Power Distribution CERTIFICATE OF COMPLIANCE NRCC-ELC-01-E (Page 6 of 6)

DOCUMENTATION AUTHOR'S DECLARATION STATEMENT
I certify that this Certificate of Compliance documentation is accurate and complete.
Documentation Author Name: MARIA NAZAR NAIM
Company: ENGINEERING 350 LLC
Address: 256 MOULTON STREET, SAN FRANCISCO, CA 94123

RESPONSIBLE PERSON'S DECLARATION STATEMENT
I certify the following under penalty of perjury, under the laws of the State of California:
1. The information provided on this Certificate of Compliance is true and correct.
2. I am eligible under Division 3 of the Business and Professions Code to accept responsibility for the building design or system design identified on this Certificate of Compliance (responsible designer).
Responsible Designer Name: DANIEL CASTRO
Company: ENGINEERING 350 LLC
Address: 256 MOULTON STREET, SAN FRANCISCO, CA 94123

STATE OF CALIFORNIA Electrical Power Distribution CERTIFICATE OF COMPLIANCE NRCC-ELC-01-E (Page 5 of 6)

C. Voltage Drop
Check all boxes below if the electrical power distribution system is in compliance with Section 130.5(c).
[X] The electrical power distribution system meets the voltage drop requirement of Section 130.5(c).
[ ] Voltage drop calculation documents showing compliance to Section 130.5(c) are submitted as part of the compliance document submittal.

D. Circuit Controls for 120-Volt Receptacles and Controlled Receptacles
Check one or more boxes below for applicable requirements of Section 130.5(d) for the electrical power distribution system.
[ ] The control is capable of automatically shutting OFF the controlled receptacles when the space is typically unoccupied...
[ ] There is at least one controlled receptacle within 6 ft from each uncontrolled receptacle...
[ ] There are installed split wired receptacles with at least one controlled and one uncontrolled receptacle...
[ ] Permanent and durable marking for controlled receptacles or circuits to differentiate them from uncontrolled receptacles or circuits is provided...
[ ] For hotel and motel guest rooms, there are controlled receptacles for at least one-half of the 120-volt receptacles in each guest room...
[ ] Receptacles that are only for the following purposes are exempted from Section 130.5(d):
-Receptacles specifically for refrigerators and water dispensers in kitchen areas.
-Receptacles located a minimum of six ft above the floor that are specifically for clocks.
-Receptacles for network copiers, fax machines, A/V and data equipment other than personal computers in copy rooms.
-Receptacles on circuits rated more than 20 amperes.
-Receptacles connected to an uninterruptible power supply (UPS) that are intended to be in continuous use, 24 hours per day/365 days per year, and are marked to differentiate them from other uncontrolled receptacles or circuits.

STATE OF CALIFORNIA Electrical Power Distribution CERTIFICATE OF COMPLIANCE NRCC-ELC-01-E (Page 4 of 6)

B. Separation of Electrical Circuits for Electrical Energy Monitoring
Check all boxes below if the electrical power distribution system is in compliance with Section 130.5(b).
[X] The electrical power distribution system meets the separation of electrical circuits for electrical energy monitoring requirement of Section 130.5(b).
[X] Describe the electrical power distribution system installed and the compliance method chosen in meeting the requirement of Section 130.5(b). Use the space below to include the information. Examples of compliance methods are detailed in Nonresidential Compliance Manual Chapter 8.
Fill out Column 1 thru 3 with the compliance information.

Table with columns: General Information, Electrical Power Distribution System Information and Method of compliance, Electrical Service Rating, Enforcement Agency. Row 1: PNL MAIN, PROPOSED DESIGN MEETS THE SEPARATION OF ELECTRICAL CIRCUIT REQUIREMENT OF SECTION 130.5(b). FOR SERVICES RATED 50 KVA OR LESS NO SEPARATION OF THE ELECTRICAL LOAD IS REQUIRED, 12.1 kVA, [ ]

PROJECT/CLIENT NAME

## Dunphy Park Improvement Project

200 Napa Street  
Sausalito, CA 94965

Owner:  
City of Sausalito  
420 Litho St.  
Sausalito, CA 94965

RHAA PROJECT NUMBER

16042A

CONSULTANT



engineering 350 llc  
256 moulton street  
san francisco, ca 94123  
T:415-328-1450  
www.engineering350.com

SUBMITTAL

## Permit Submittal

DATE


21 August 2017

REVISIONS


No. Date Description

1 9-18-2017 Permit Plan Check Response

REGISTRATION AND SIGNATURE

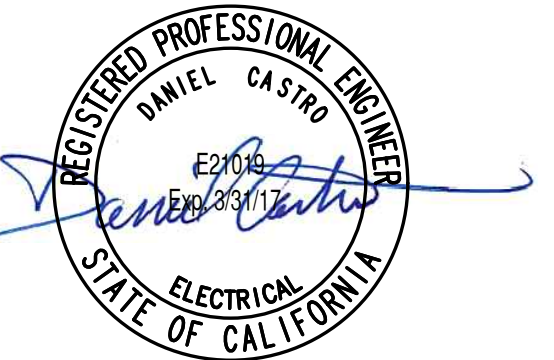

SCALE NONE

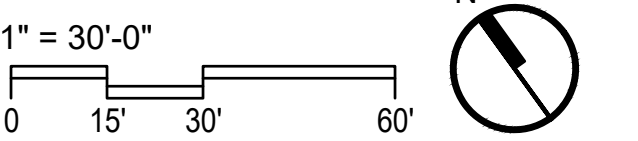

SHEET TITLE

## TITLE 24 COMPLIANCE

DRAWN BY: KZ CHECKED BY:

# E0.4

STATE OF CALIFORNIA  
**OUTDOOR LIGHTING**  
CEC-NRCC-LTO-01-E (Revised 04/16)  
CALIFORNIA ENERGY COMMISSION

CERTIFICATE OF COMPLIANCE  
Outdoor Lighting  
Project Name: DUNPHY PARK IMPROVEMENTS Date Prepared: 8/15/2017

NRCC-LTO-01-E (Page 1 of 4)

**A. General Information**

Project Address: 200 NAPA STREET, SAUSALITO, CA 94965 Total Illuminated Hardscape Area: 61,522.5 sq. ft.

Phase of Construction:  New Construction  Addition  Alteration

Outdoor Lighting Zone (LZ):  LZ-1  LZ-2  LZ-3  LZ-4

I have confirmed with the AHJ which LZ applies to this site. For default lighting zone designations, see Title 24 Part 6, §10-114.

**B. Lighting Compliance Documents** (check box for each document included)

For detailed instructions on the use of this and all Energy Efficiency Standards compliance documents, refer to the Nonresidential Manual published by the California Energy Commission.

NRCC-LTO-01-E Certificate of Compliance  
 NRCC-LTO-02-E Outdoor Lighting Controls Certificate of Compliance  
 NRCC-LTO-03-E Outdoor Lighting Power Allowance Certificate of Compliance  
 NRCC-LTO-04-E Outdoor Lighting Existing Conditions Certificate of Compliance

**C. Summary of Allowed Outdoor Lighting Power**

Item	Watts
01 Sum Total ALLOWED Outdoor Lighting Wattage from NRCC-LTO-03-E, page 1	5530.05
Alterations with NO increase of connected lighting load may instead use the allowed wattage from NRCC-LTO-04, page 2.	
Complies ONLY if Installed (Box 02) ≤ Allowed (Box 01)	
02 Sum Total INSTALLED Outdoor Lighting Wattage from NRCC-LTO-01-E, page 3	1170

**D. Declaration of Required Installation Certificates**

Declare by checking all Installation Certificates that will be submitted. (Retain copies and verify compliance documents are completed and signed.)

NRCC-LTO-01-E - Must be submitted for all buildings.  Field Inspector  
 NRCC-LTO-03-E - Must be submitted for a lighting control system, or for an Energy Management Control System (EMCS), to be recognized for compliance.  Field Inspector

**E. Declaration of Required Certificates of Acceptance**

Declare by checking all of the Certificates of Acceptance that will be submitted. (Retain copies and verify compliance documents are completed and signed.)

NRCA-LTO-02-A - Must be submitted for outdoor lighting controls.  Field Inspector

**F. Schedule of Luminaires Exempt from the Outdoor Lighting Power Requirements in §140.7**

01	02
Name or Symbol	Description of exempt luminaire in accordance with the exemptions

CA Building Energy Efficiency Standards - 2016 Nonresidential Compliance April 2016

STATE OF CALIFORNIA  
**OUTDOOR LIGHTING**  
CEC-NRCC-LTO-01-E (Revised 04/16)  
CALIFORNIA ENERGY COMMISSION

CERTIFICATE OF COMPLIANCE  
Outdoor Lighting  
Project Name: DUNPHY PARK IMPROVEMENTS Date Prepared: 8/15/2017

NRCC-LTO-01-E (Page 2 of 4)

**G. Schedule of Luminaires Exempt from the Cutoff Requirements in §130.2(b)**

01	02
Name or Symbol	Description of exempt luminaire in accordance with the exemptions
F1	OUTDOOR LUMINAIRE RATED FOR USE WITH LAMPS LESS THAN 150 W.
F2	OUTDOOR LUMINAIRE RATED FOR USE WITH LAMPS LESS THAN 150 W.

**H. Schedule of Luminaires Exempt from the Outdoor Lighting Control Requirements in §130.2(c)**

01	02
Name or Symbol	Description of exempt luminaire in accordance with the exemptions

CA Building Energy Efficiency Standards - 2016 Nonresidential Compliance April 2016

STATE OF CALIFORNIA  
**OUTDOOR LIGHTING**  
CEC-NRCC-LTO-01-E (Revised 04/16)  
CALIFORNIA ENERGY COMMISSION

CERTIFICATE OF COMPLIANCE  
Outdoor Lighting  
Project Name: DUNPHY PARK IMPROVEMENTS Date Prepared: 8/15/2017

NRCC-LTO-01-E (Page 3 of 4)

**I. Outdoor Lighting Schedule and Field Inspection Energy Checklist**

01	02	03 Installed Watts				04	05	06	07	08	09				
		Watts per Luminaire	CCC Default From MAB	Accounting to §130.2(b)	Number of Luminaires										
Name or Item Tag	Complete Luminaire Description	How wattage was determined		Total Installed Watts in this area (03 x 05)	Primary Function area in which these luminaires are installed (Outdoor Lighting Zone)	BUG Rating	Pass	Fail	UH:	UL:	FVH:	BVH:	FVH:	FH:	BH:
F1	POLE LIGHTING, FLARED EDGE, BASE FIXTURE, FLAT GLASS LENS, 4500K, 6665 LUMENS, SINGLE ARM MOUNTING CONFIGURATION.	65	<input checked="" type="checkbox"/>	<input checked="" type="checkbox"/>	6	390	SITE LIGHTING								
F2	POLE LIGHTING, FLARED EDGE, BASE FIXTURE, FLAT GLASS LENS, 4500K, 6665 LUMENS, DOUBLE ARM MOUNTING CONFIGURATION.	130	<input checked="" type="checkbox"/>	<input checked="" type="checkbox"/>	6	780	SITE LIGHTING								
INSTALLED WATTS PAGE TOTAL:											1170	Enter sum total of all pages (Sum Total INSTALLED Outdoor lighting wattage) into NRCC-LTO-01-E, Page 1.			1170

CA Building Energy Efficiency Standards - 2016 Nonresidential Compliance April 2016

STATE OF CALIFORNIA  
**OUTDOOR LIGHTING**  
CEC-NRCC-LTO-01-E (Revised 04/16)  
CALIFORNIA ENERGY COMMISSION

CERTIFICATE OF COMPLIANCE  
Outdoor Lighting  
Project Name: DUNPHY PARK IMPROVEMENTS Date Prepared: 8/15/2017

NRCC-LTO-01-E (Page 4 of 4)

**DOCUMENTATION AUTHOR'S DECLARATION STATEMENT**

I certify that this Certificate of Compliance documentation is accurate and complete.

Documentation Author Name: MARIJA NAZAR NAIM Signature Date: 8/15/2017

Company: ENGINEERING 350 LLC Address: 256 MOULTON ST SAN FRANCISCO, CA 94123 Phone: 415-354-0006

**RESPONSIBLE PERSON'S DECLARATION STATEMENT**

I certify the following under penalty of perjury, under the laws of the State of California:

- The information provided on this Certificate of Compliance is true and correct.
- I am eligible under Division 3 of the Business and Professions Code to accept responsibility for the building design or system design identified on this Certificate of Compliance (responsible designer).
- The energy features and performance specifications, materials, components, and manufactured devices for the building design or system design identified on this Certificate of Compliance conform to the requirements of Title 24, Part 1 and Part 6 of the California Code of Regulations.
- The building design features or system design features identified on this Certificate of Compliance are consistent with the information provided on other applicable compliance documents, worksheets, calculations, plans and specifications submitted to the enforcement agency for approval with this building permit application.
- I will ensure that a completed signed copy of this Certificate of Compliance shall be made available with the building permit(s) issued for the building, and made available to the enforcement agency for all applicable inspections. I understand that a completed signed copy of this Certificate of Compliance is required to be included with the documentation the builder provides to the building owner at occupancy.

Responsible Designer Name: DANIEL CASTRO Responsible Designer Signature: Daniel Castro Date Signed: 8/15/2017 License: E21019 Phone: 415-354-0006

CA Building Energy Efficiency Standards - 2016 Nonresidential Compliance April 2016

STATE OF CALIFORNIA  
**OUTDOOR LIGHTING CONTROLS**  
CEC-NRCC-LTO-02-E (Revised 08/16)  
CALIFORNIA ENERGY COMMISSION

CERTIFICATE OF COMPLIANCE  
Outdoor Lighting Controls  
Project Name: DUNPHY PARK IMPROVEMENTS Date Prepared: 8/15/2017

NRCC-LTO-02-E (Page 1 of 3)

**A. Mandatory Outdoor Lighting Control Declaration Statements**

Check all that apply:

- Lighting shall be controlled by self-contained lighting control devices which are certified to the Energy Commission according to the Title 20 Appliance Efficiency Regulations in accordance with §110.9(a).
- Lighting shall be controlled by a lighting control system or energy management control system in accordance with §110.9. An Installation Certificate shall be submitted in accordance with §130.4(b).
- All lighting controls and equipment shall comply with the applicable requirements in §110.9 and shall be installed in accordance with the manufacturer's instructions in accordance with §130.4(d).
- Part-Night Outdoor Lighting Controls, as defined in Section 100.11(b), shall meet the requirements in Section 110.9(b).
- All outdoor incandescent luminaires rated over 100 watts, determined in accordance with Section 130.0(c), shall be controlled by a motion sensor.
- All outdoor luminaires rated for use with lamps greater than 150 lamp watts, determined in accordance with Section 130.0(c), shall comply with Uplight and Glare requirements in accordance with Section 130.2(b).
- All installed outdoor lighting shall be controlled by a photocontrol or outdoor astronomical time-switch control, or other control capable of automatically switching OFF in accordance with Section 130.2(c).
- All installed outdoor lighting shall be circuited and independently controlled from other electrical loads by an automatic scheduling control in accordance with Section 130.2(c).
- All installed outdoor lighting, where the bottom of the luminaire is mounted 24 feet or less above the ground, shall be controlled with automatic lighting controls in accordance with Section 130.2(c).
- For Outdoor Sales Frontage, an automatic lighting control shall be installed in accordance with Section 130.2(c).
- For Building Facade, Ornamental Hardscape and Outdoor Dining lighting, an automatic lighting control shall be installed in accordance with Section 130.2(c).
- Before an occupancy permit is granted for the newly constructed building or for the addition, or for any altered outdoor lighting controls, shall be certified as meeting the Acceptance Requirements for Code Compliance in accordance with §130.4(a). Outdoor lighting controls shall comply with the applicable requirements of Section 130.2(c) and Reference Nonresidential Appendix NA7.8.

CA Building Energy Efficiency Standards - 2016 Nonresidential Compliance August 2016

STATE OF CALIFORNIA  
**OUTDOOR LIGHTING CONTROLS**  
CEC-NRCC-LTO-02-E (Revised 08/16)  
CALIFORNIA ENERGY COMMISSION

CERTIFICATE OF COMPLIANCE  
Outdoor Lighting Controls  
Project Name: DUNPHY PARK IMPROVEMENTS Date Prepared: 8/15/2017

NRCC-LTO-02-E (Page 2 of 3)

**B. Mandatory Outdoor Lighting Control Schedule and Field Inspection Checklist**

01	02	Standards Complying With (✓ all that apply, or leave empty if Exempted)										10	11
		03	04	05	06	07	08	09	10	11			
Location and Application of Luminaires Being Controlled	Type/Description of Lighting Control (i.e. outdoor motion sensor, outdoor photocontrol, outdoor astronomical time-switch control, automatic scheduling control, part-night outdoor lighting control)	# of Units	10/2/0E15	2/2/0E15	3/2/0E15	4/2/0E15	5/2/0E15	6/2/0E15	7/2/0E15	8/2/0E15	9/2/0E15	Pass	Fail
SITE LIGHTING	OUTDOOR PHOTOCONTROL, TIME CONTROL	1										<input checked="" type="checkbox"/>	<input type="checkbox"/>

CA Building Energy Efficiency Standards - 2016 Nonresidential Compliance August 2016





PROJECT/CLIENT NAME

## Dunphy Park Improvement Project

200 Napa Street  
Sausalito, CA 94965

Owner:  
City of Sausalito  
420 Litho St.  
Sausalito, CA 94965

RHAA PROJECT NUMBER

16042A

CONSULTANT



engineering 350 lic  
256 moulton street  
san francisco, ca 94123  
T:415-328-1450  
www.engineering350.com

SUBMITTAL

### Permit Submittal


DATE

21 August 2017


REVISIONS

No.	Date	Description
1	9-18-2017	Permit Plan Check Response

REGISTRATION AND SIGNATURE

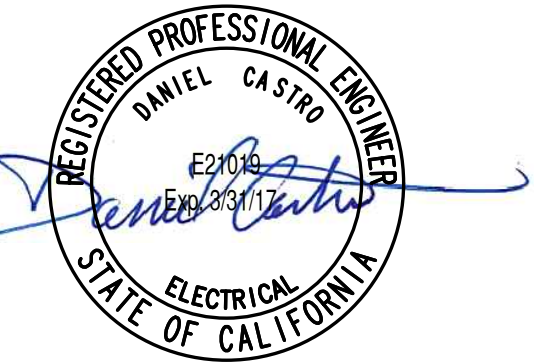

SCALE 1" = 30'-0"

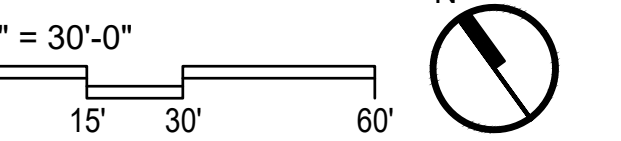

SHEET TITLE

### ELECTRICAL SITE PLAN

DRAWN BY: KZ CHECKED BY:


E2.0

### KEY NOTES:

1. DEDICATED 120V, 20A GFCI RECEPTACLE IN GAZEBO SHALL BE TYPE NEMA 4X WEATHER-PROOF AND PAD-LOCKABLE.
2. TWIST LOCK 120/240V, 50A GFCI RECEPTACLE FOR OWNER'S SPIDER BOX FOR PUBLIC EVENTS. RECEPTACLE SHALL BE TYPE NEMA 4X WEATHER-PROOF AND PAD-LOCKABLE.
3. 120V, 20A GFCI RECEPTACLE SHALL BE TYPE NEMA 4X WEATHER-PROOF AND PAD-LOCKABLE IN PEDESTAL.
4. CONDUIT SHALL BE BURIED MINIMUM OF 18".
5. PROVIDE TRENCH FOR (N) UTILITIES. MAINTAIN MINIMUM 24" SEPARATION BETWEEN ELECTRICAL AND OTHERS.
6. 120/240V, 1PH, 3W MAIN PNL. PAD MOUNTED NEMA 3R ENCLOSURE.
7. PULLBOX FOR FUTURE PATH LIGHTING. PROVIDE 1" PVC CONDUIT WITH PULL ROPE BETWEEN PULLBOXES AND MAIN PNL.
8. LIGHTING TIMER CONTROL SHALL BE TYPE NEMA 4X AND PAD-LOCKABLE IN PEDESTAL.
9. KEY LOCK POWER SWITCH SHALL BE PROVIDED WITH NEMA 4X ENCLOSURE. SEE DETAIL 4/E6.1.

### SHEET NOTES:

1. REFER TO ARCHITECTURAL DRAWINGS FOR EXACT LOCATION AND MOUNTING HEIGHT OF ALL DEVICES SHOWN.
2. PARKING LOT LIGHTING FIXTURES ARE CONTROLLED VIA INTEGRATED PHOTOSENSOR. BOCCO COURT LIGHTING FIXTURES ARE CONTROLLED VIA INTEGRATED PHOTOSENSOR AND TIMER CONTROL. SEE DETAIL 1/E6.1.
3. ELECTRICAL DEVICES SHOWN ON THIS DRAWING ARE FED FROM PNL. MAIN.
4. REFER TO LIGHTING AND PNL. SCHEDULES ON E0.2
5. CONDUIT ROUTING IS DIAGRAMMATIC AND SHALL BE FIELD COORDINATED AND ADJUSTED TO SUIT ACTUAL CONDITIONS. PROVIDE PULL BOXES IN ORDER TO MEET CODE.
6. PROVIDE MIN. #12 AWG WIRING TO DEVICES, ADJUST AS REQUIRED TO MEET VOLTAGE DROP AND DERATING FACTORS.

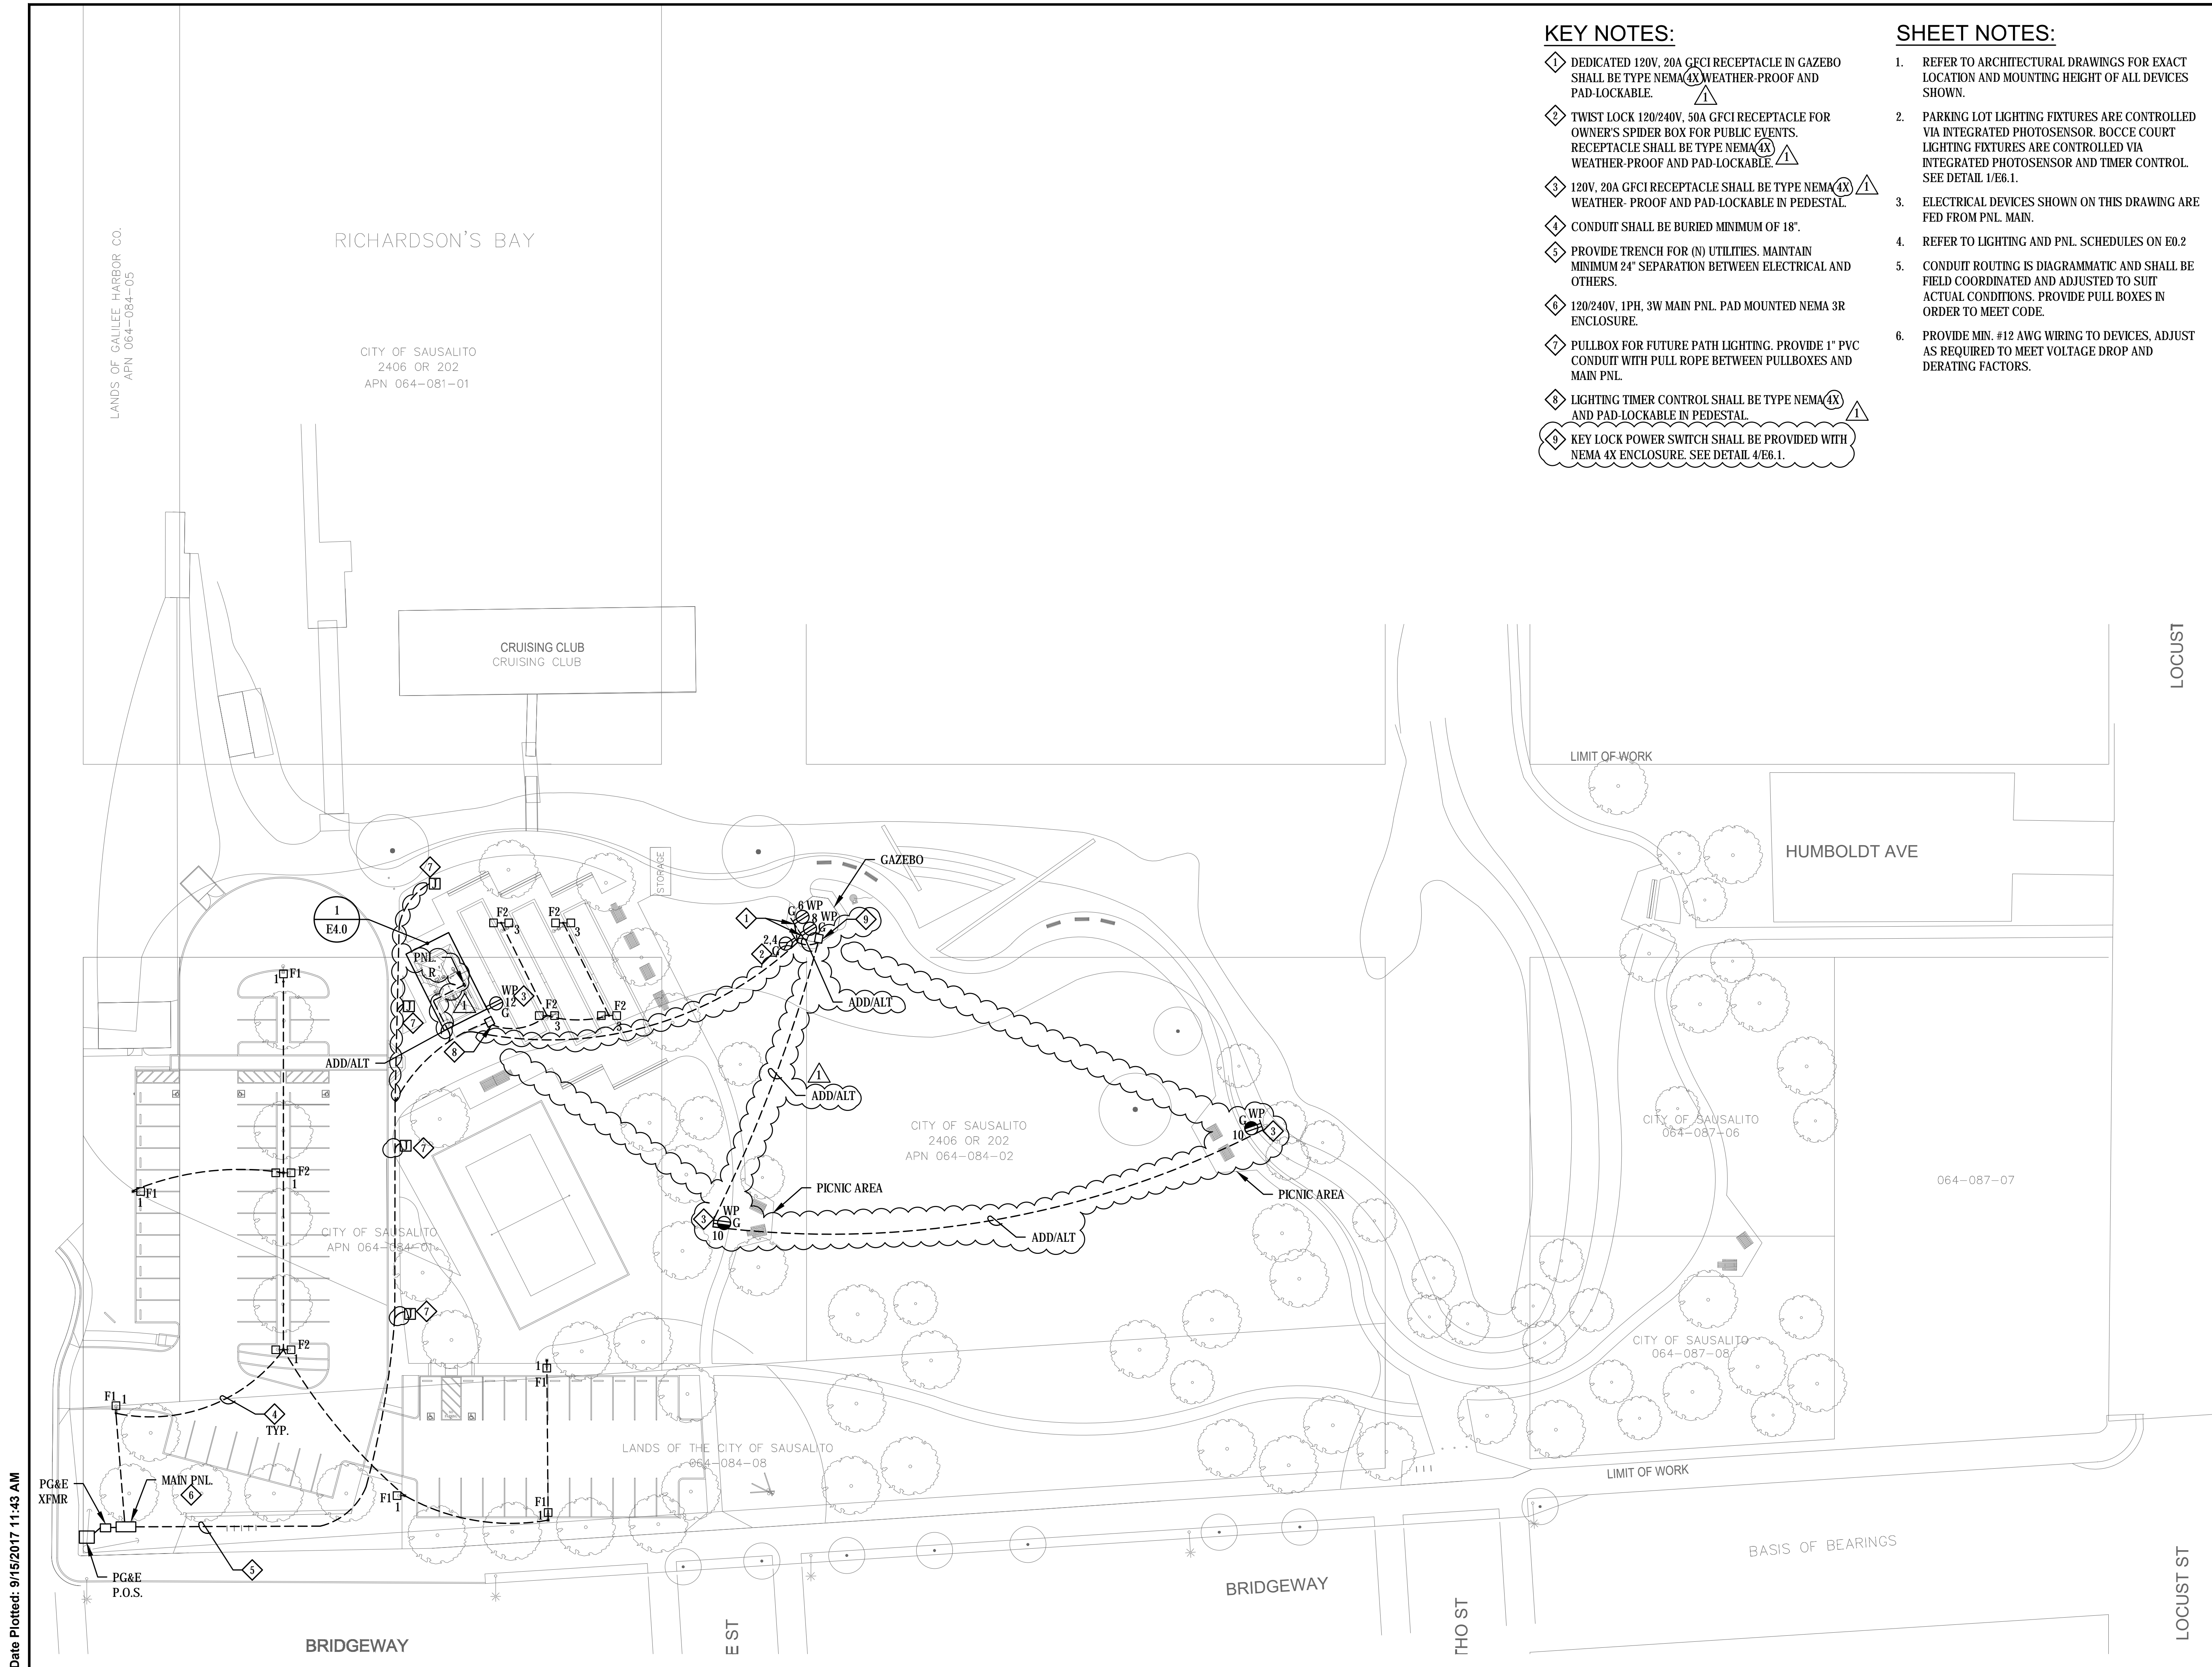

PROJECT/CLIENT NAME

## Dunphy Park Improvement Project

200 Napa Street  
Sausalito, CA 94965

Owner:  
City of Sausalito  
420 Litho St.  
Sausalito, CA 94965

RHAA PROJECT NUMBER

16042A

CONSULTANT



engineering 350 llc  
256 moulton street  
san francisco, ca 94123  
T:415-328-1450  
www.engineering350.com

SUBMITTAL

### Permit Submittal


DATE

21 August 2017


REVISIONS

No.	Date	Description
△	9-18-2017	Permit Plan Check Response

REGISTRATION AND SIGNATURE

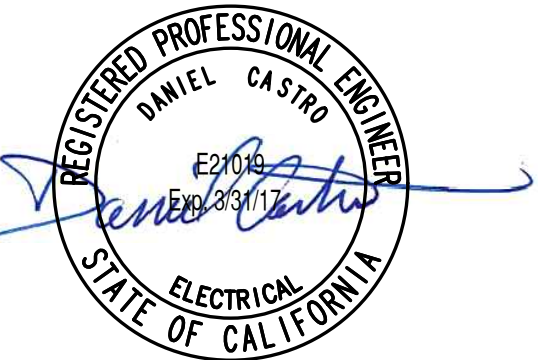

SCALE 1/4" = 1'-0"

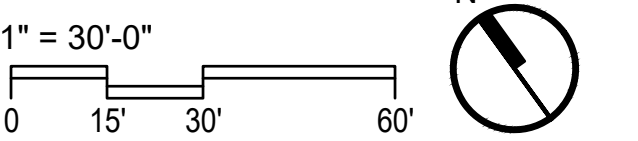


SHEET TITLE

### ELECTRICAL RESTROOM PLAN (ADD/ALT)

DRAWN BY: KZ CHECKED BY:

### SHEET NOTES:

1. REFER TO RESTROOM MANUFACTURER DRAWINGS FOR TYPE, EXACT LOCATION AND MOUNTING HEIGHT OF DEVICES SHOWN.
2. LIGHTING FIXTURES AND RECEPTACLES ARE PROVIDED BY RESTROOM MANUFACTURER. CONTRACTOR SHALL PROVIDE WIRING AND CONDUIT FROM PNL TO DEVICES.
3. ELECTRICAL DEVICES SHOWN ON THIS DRAWING ARE FED FROM PNL R LOCATED IN RESTROOM UTILITY ROOM.
4. REFER TO E0.2 FOR PNL SCHEDULE.
5. EXTENSION OF CIRCUIT FROM PNL MAIN TO PNL R FOR RESTROOM BUILDING SHALL BE PROVIDED BY CONTRACTOR. COORDINATE LOCATION OF LOADS WITH RESTROOM MANUFACTURER.

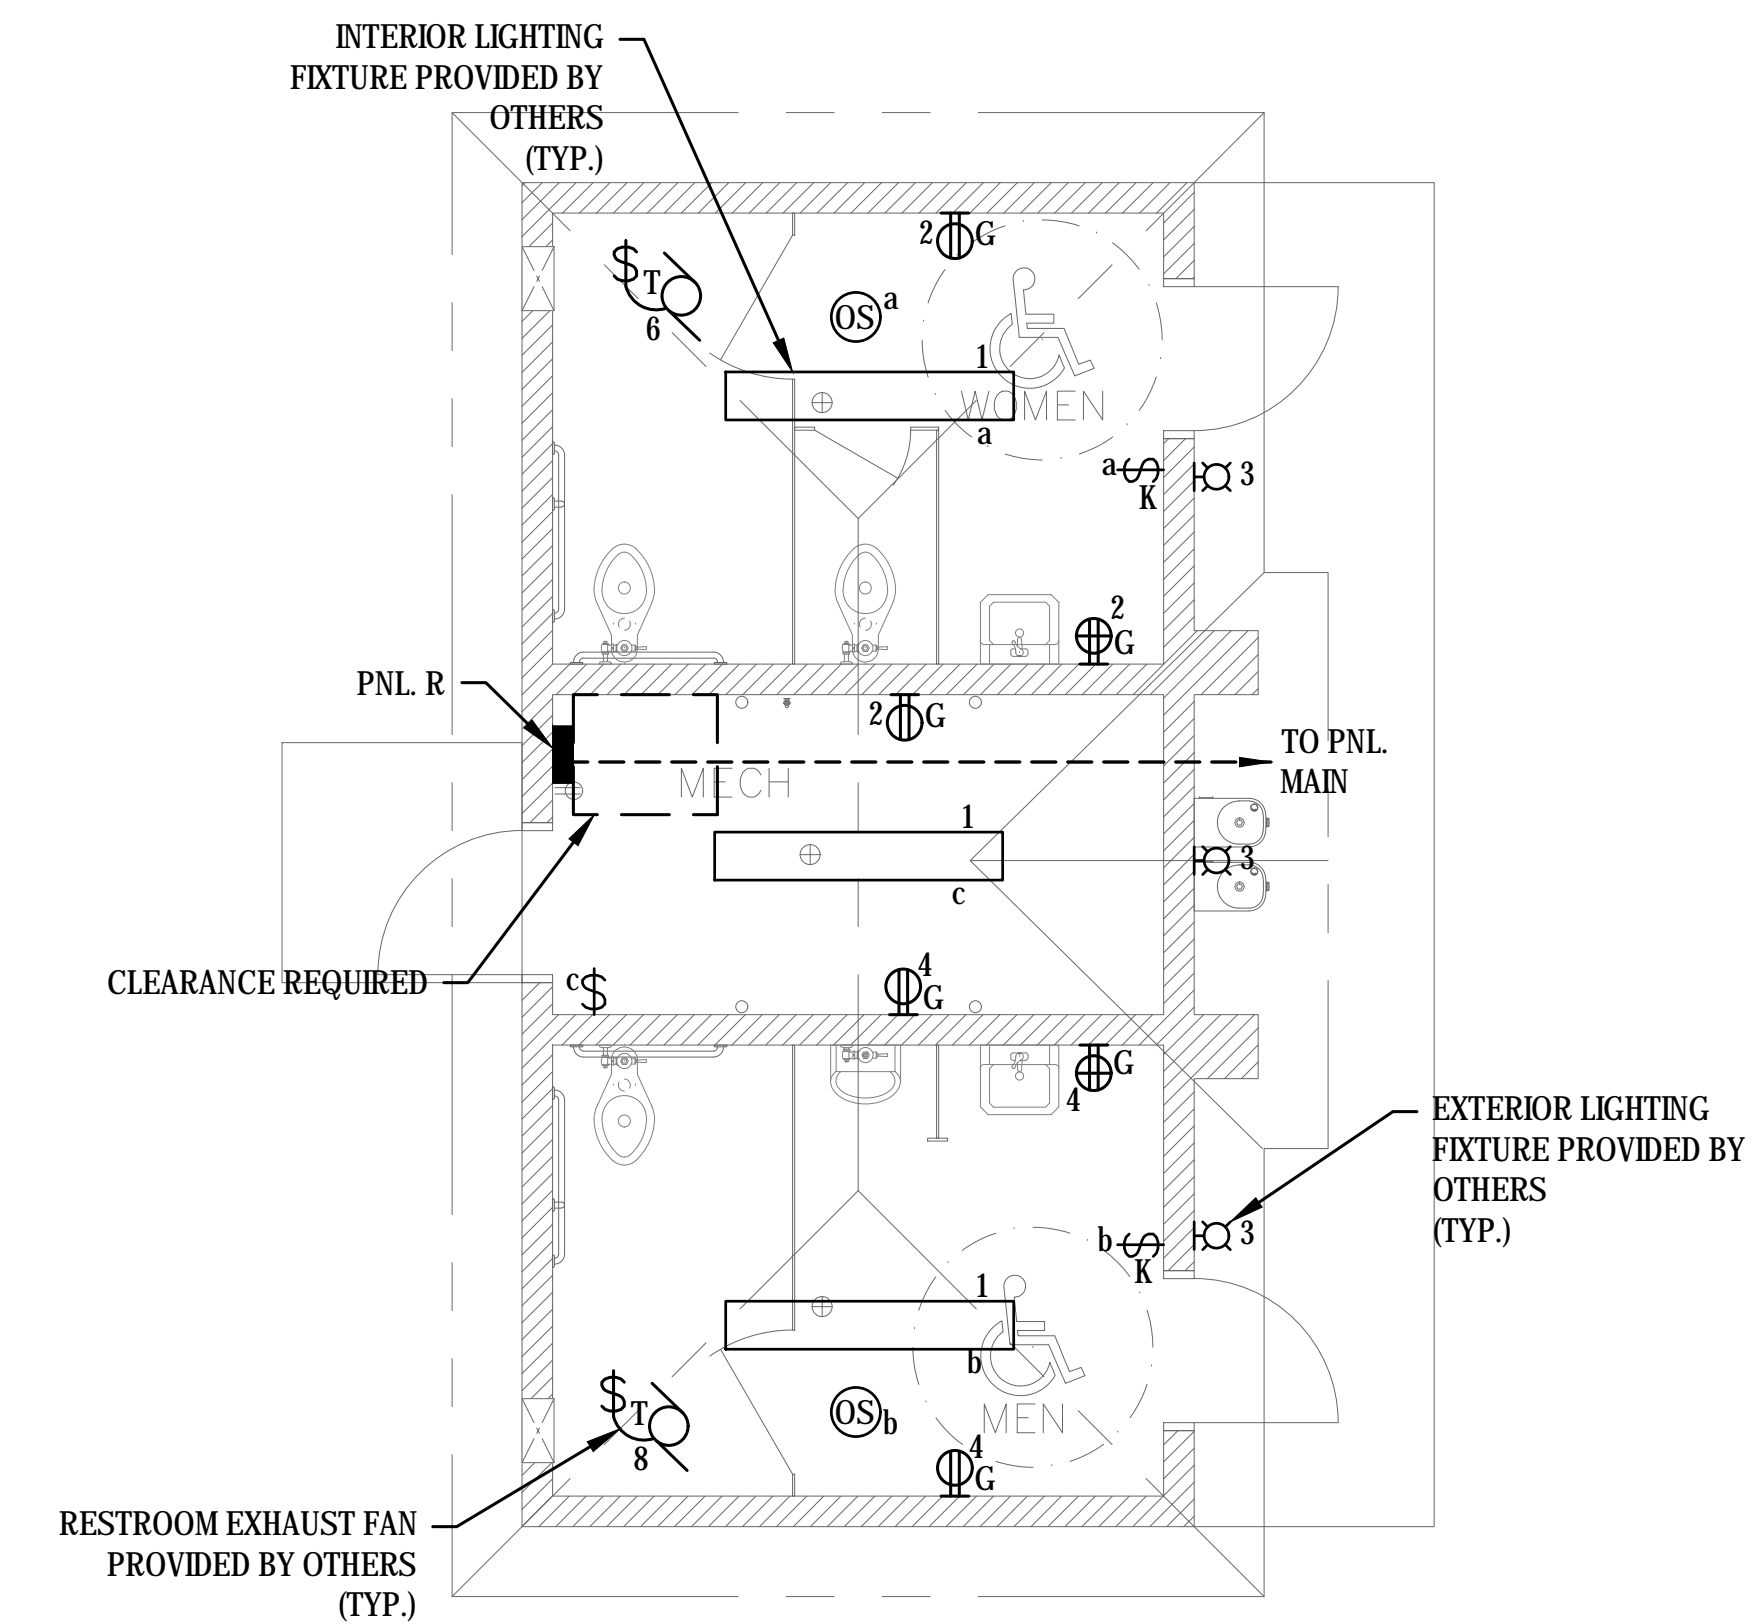

**SHEET NOTES:**

1. REFER TO SHEET E0.2 EQUIPMENT CONNECTION SCHEDULE FOR WIRING SCHEDULE.
2. PROVIDE CONCRETE ENCASED GROUNDING ELECTRODE CONDUCTOR IN ACCORDANCE WITH CEC TABLE 250.66. PROVIDE 1/0 KCML COPPER ELECTRODE CONDUCTOR. PROVIDE A SEPARATELY DERIVED BONDING JUMPER FROM BUILDING STEEL AND UNDERGROUND WATER PIPES.

**rhaa**

LANDSCAPE ARCHITECTURE + PLANNING  
225 Miller Avenue, Mill Valley, CA 94941  
T 415 383 7900 F 415 383 1433 www.rhaa.com

PROJECT/CLIENT NAME

**Dunphy Park Improvement Project**

200 Napa Street  
Sausalito, CA 94965

Owner:  
City of Sausalito  
420 Litho St.  
Sausalito, CA 94965

RHAA PROJECT NUMBER

16042A

CONSULTANT

**engineering 350**

engineering 350 llc  
256 moulton street  
san francisco, ca 94123  
T:415-328-1450  
www.engineering350.com

SUBMITTAL

Permit Submittal


DATE

21 August 2017


REVISIONS

No.	Date	Description
1	9-18-2017	Permit Plan Check Response

REGISTRATION AND SIGNATURE

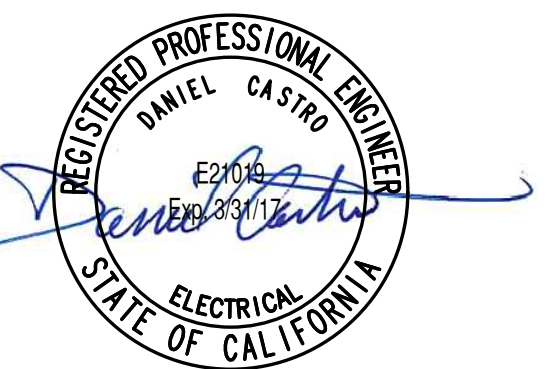


SCALE NONE

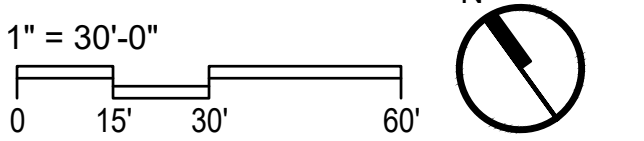

SHEET TITLE

**ELECTRICAL DIAGRAMS**

DRAWN BY: KZ CHECKED BY:

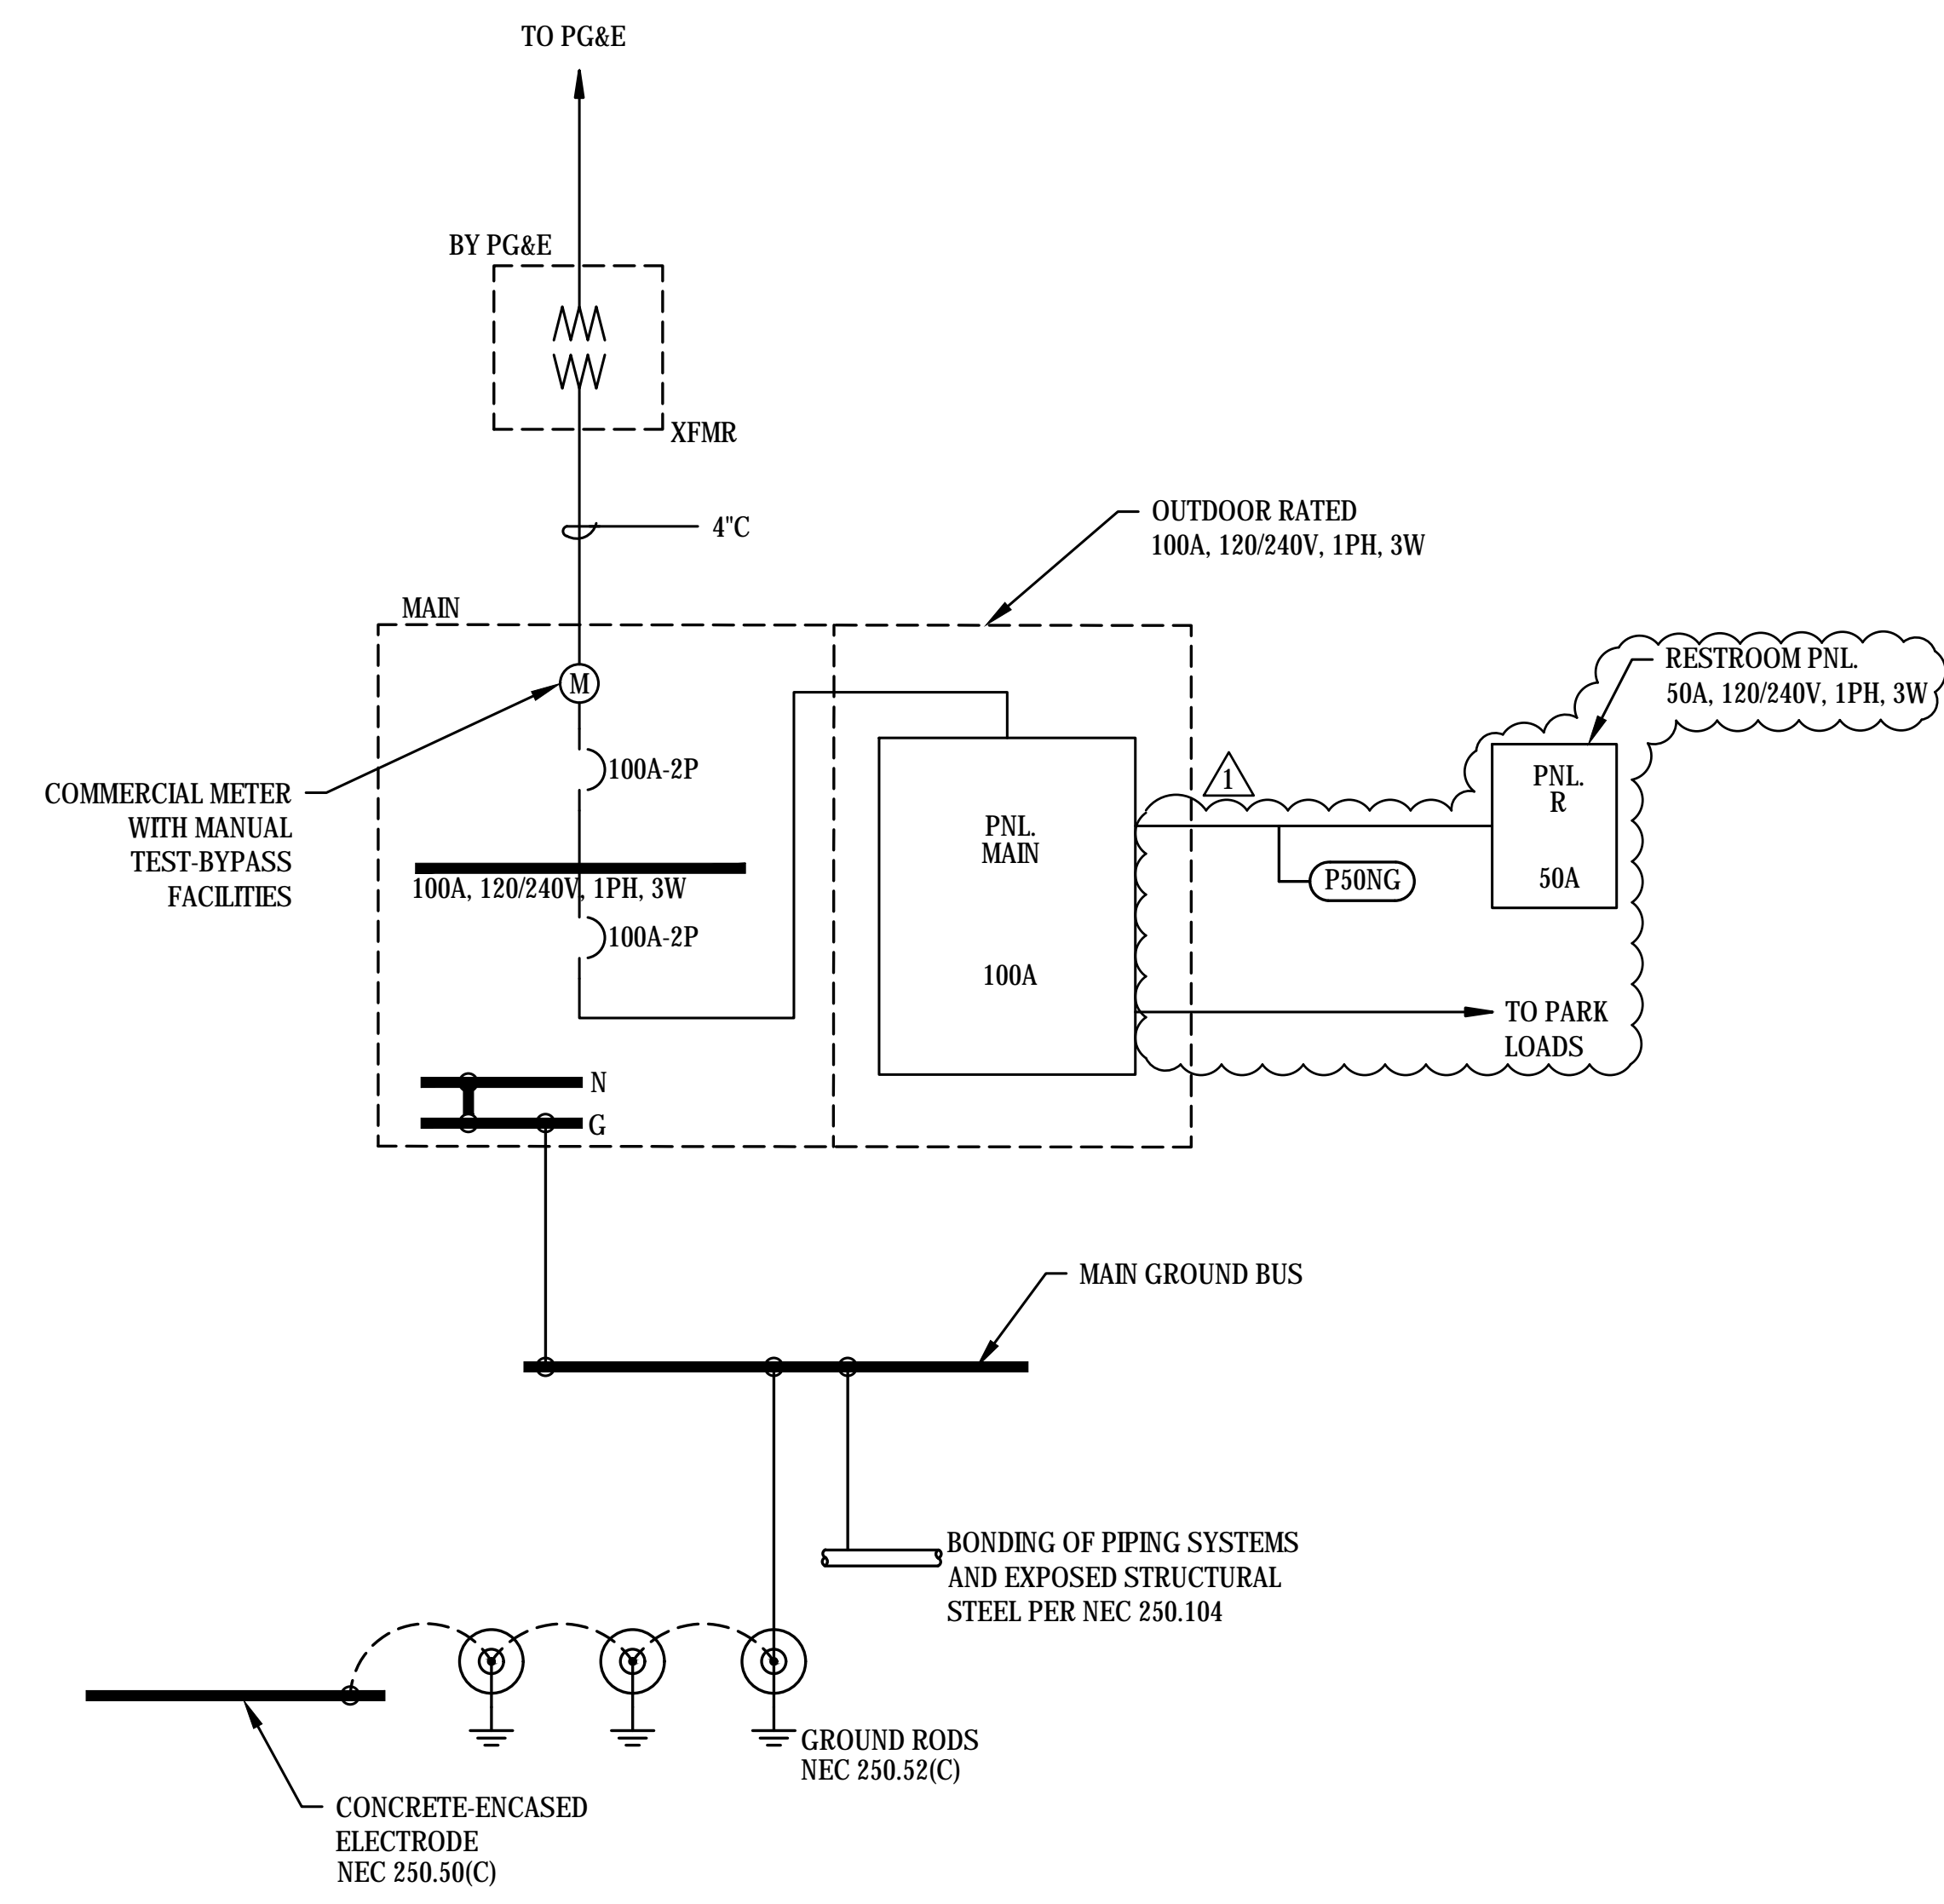

Date Plotted: 9/15/2017 11:43 AM

PROJECT/CLIENT NAME

## Dunphy Park Improvement Project

200 Napa Street  
Sausalito, CA 94965

Owner:  
City of Sausalito  
420 Litho St.  
Sausalito, CA 94965

RHAA PROJECT NUMBER

16042A

CONSULTANT



engineering 350 llc  
256 moulton street  
san francisco, ca 94123  
T:415-328-1450  
www.engineering350.com

SUBMITTAL

### Permit Submittal


DATE

21 August 2017


REVISIONS

No.	Date	Description
1	9-18-2017	Permit Plan Check Response

REGISTRATION AND SIGNATURE

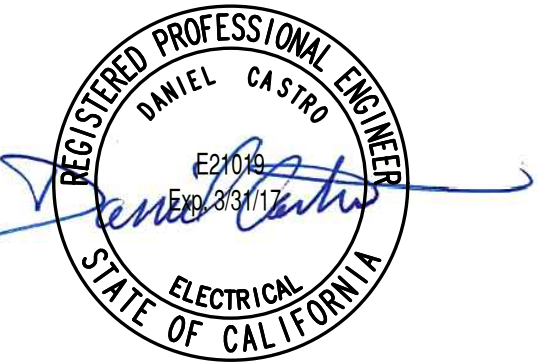


SCALE NONE

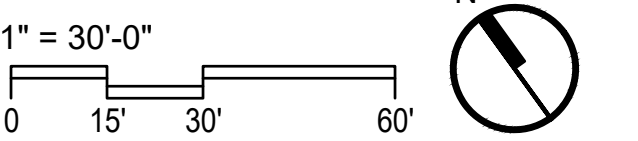

SHEET TITLE

### ELECTRICAL DETAILS


DRAWN BY: KZ CHECKED BY:

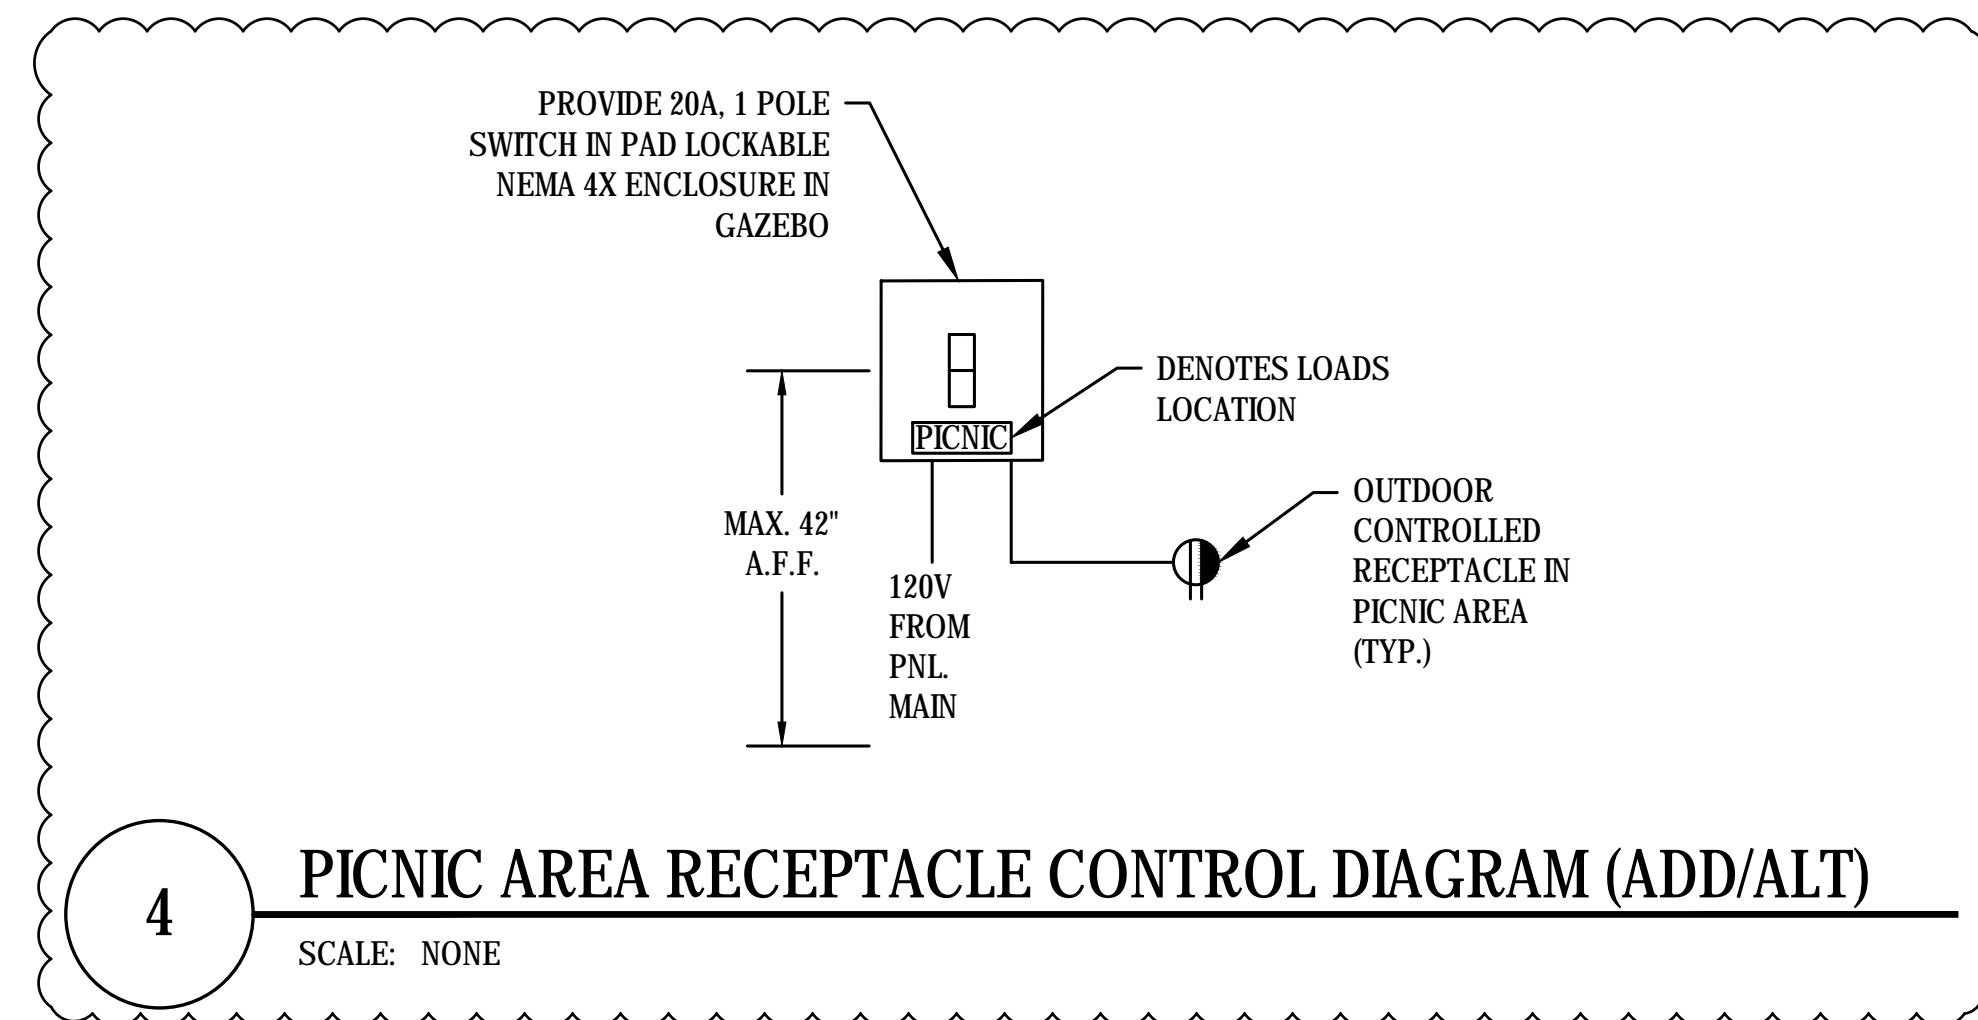

4

### PICNIC AREA RECEPTACLE CONTROL DIAGRAM (ADD/ALT)


SCALE: NONE

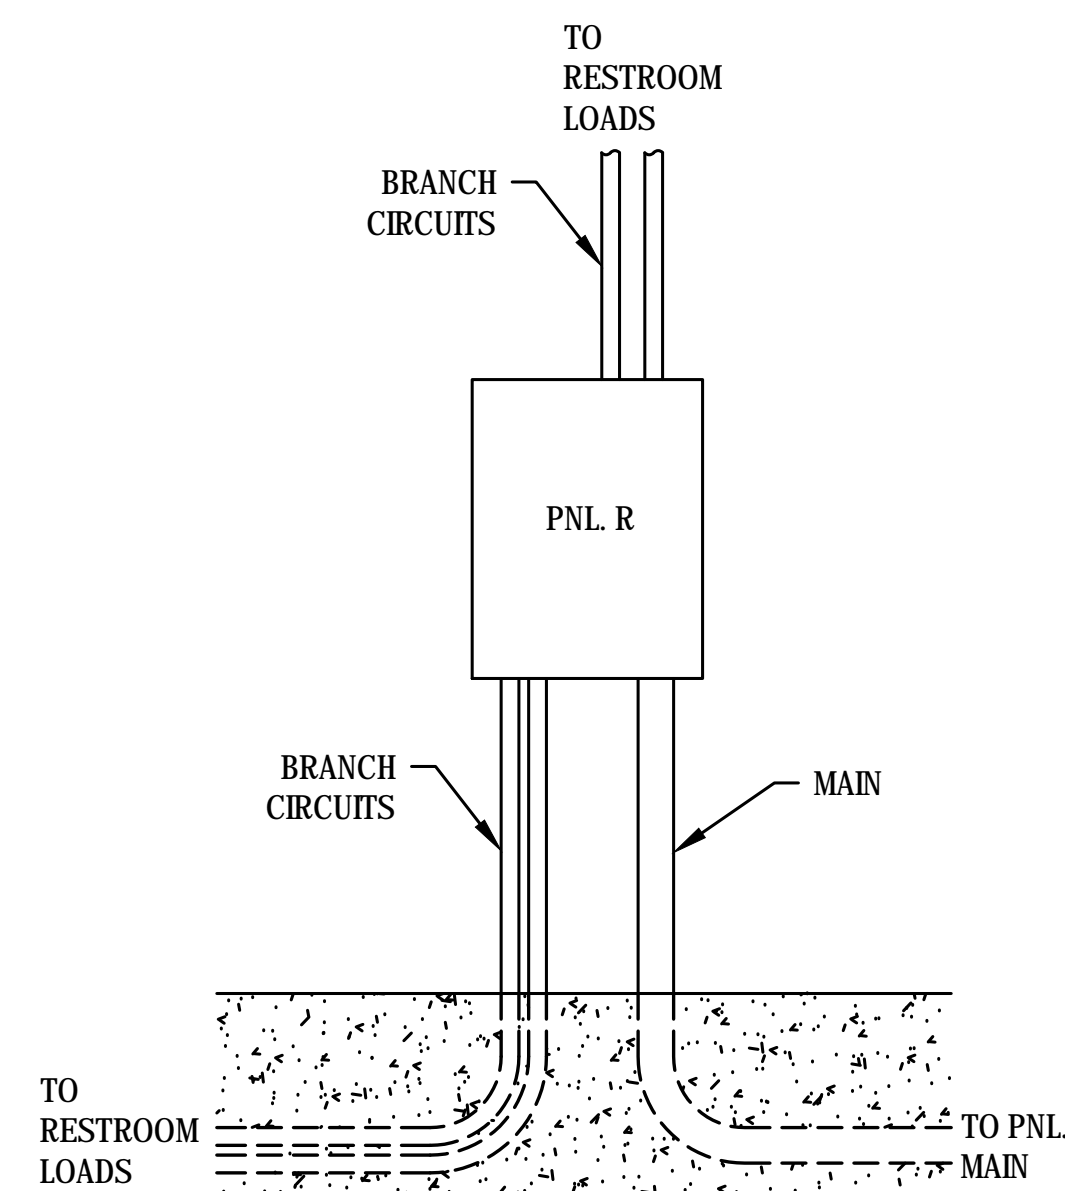

3

### RESTROOM PANELBOARD DETAIL (ADD/ALT)

SCALE: NONE

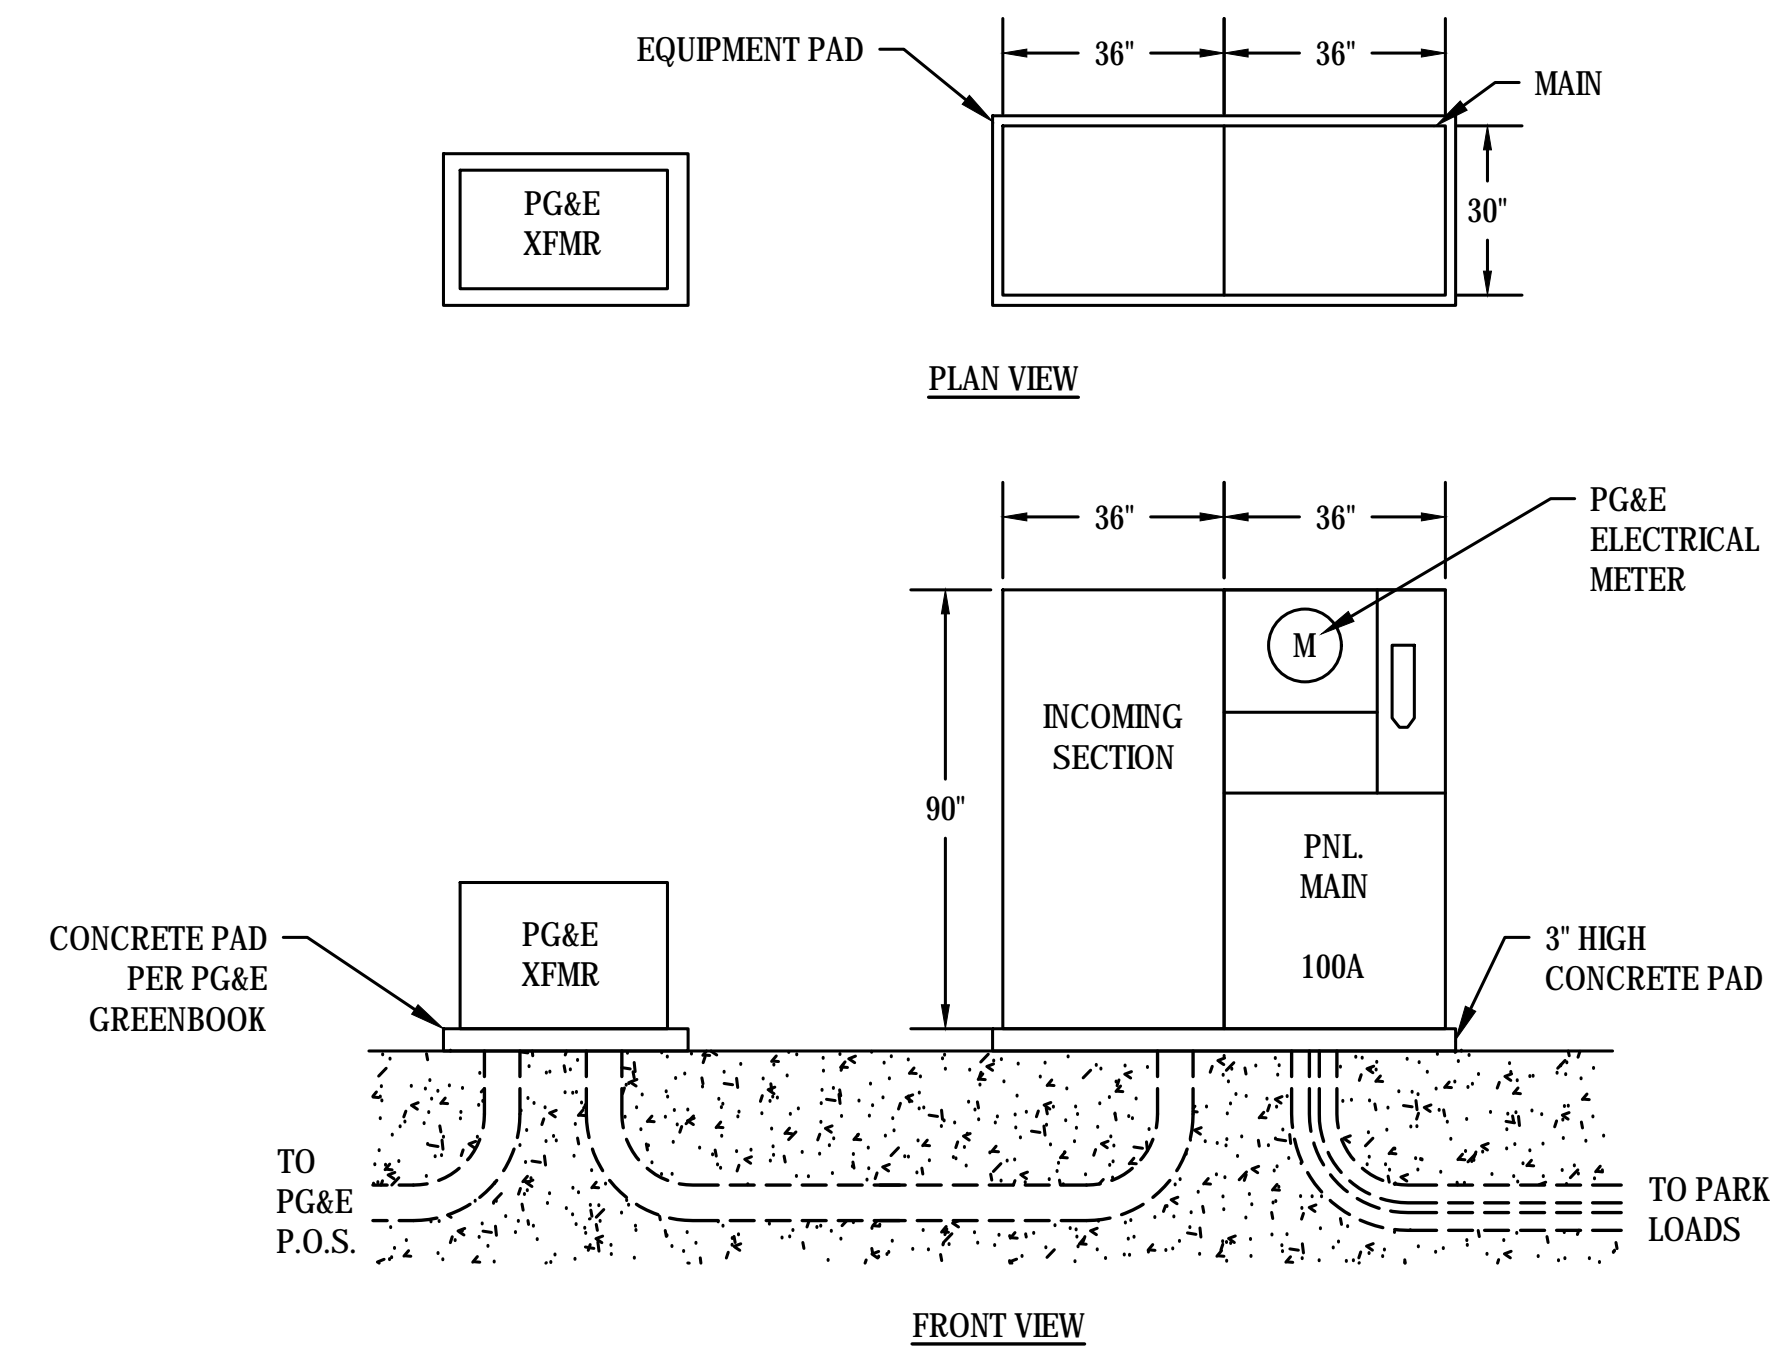


2

### ELECTRICAL SERVICE EQUIPMENT DETAIL

SCALE: NONE

- NOTES:
- EQUIPMENT ENCLOSURE SHALL BE PAD LOCKABLE.
  - COORDINATE XFMR DIMENSIONS WITH PG&E.
  - EQUIPMENT PAD SHALL BE COORDINATED WITH EQUIPMENT MANUFACTURER. RETAIN STRUCTURAL FOR APPROVAL.


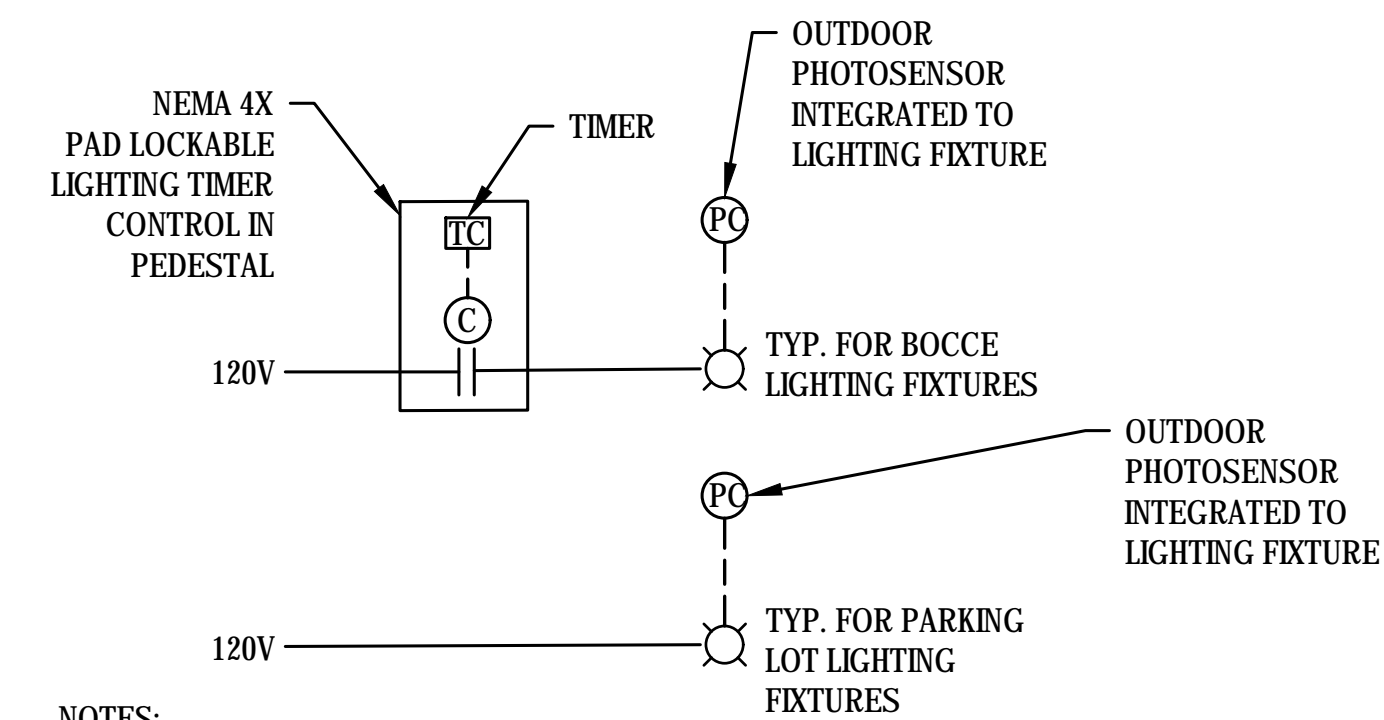


1

### EXTERIOR LIGHTING CONTROL DIAGRAM


SCALE: NONE

- NOTES:
- PARKING LOT LIGHTING FIXTURES: LIGHTS SHALL TURN ON AT DUSK AND TURN OFF WHEN DAYLIGHT IS AVAILABLE.
  - BOCCO COURT LIGHTING FIXTURES: LIGHTS SHALL TURN ON AT DUSK AND TURN OFF AT A PRE-PROGRAMMED TIME. COORDINATE WITH OWNER FOR TIME SCHEDULING.

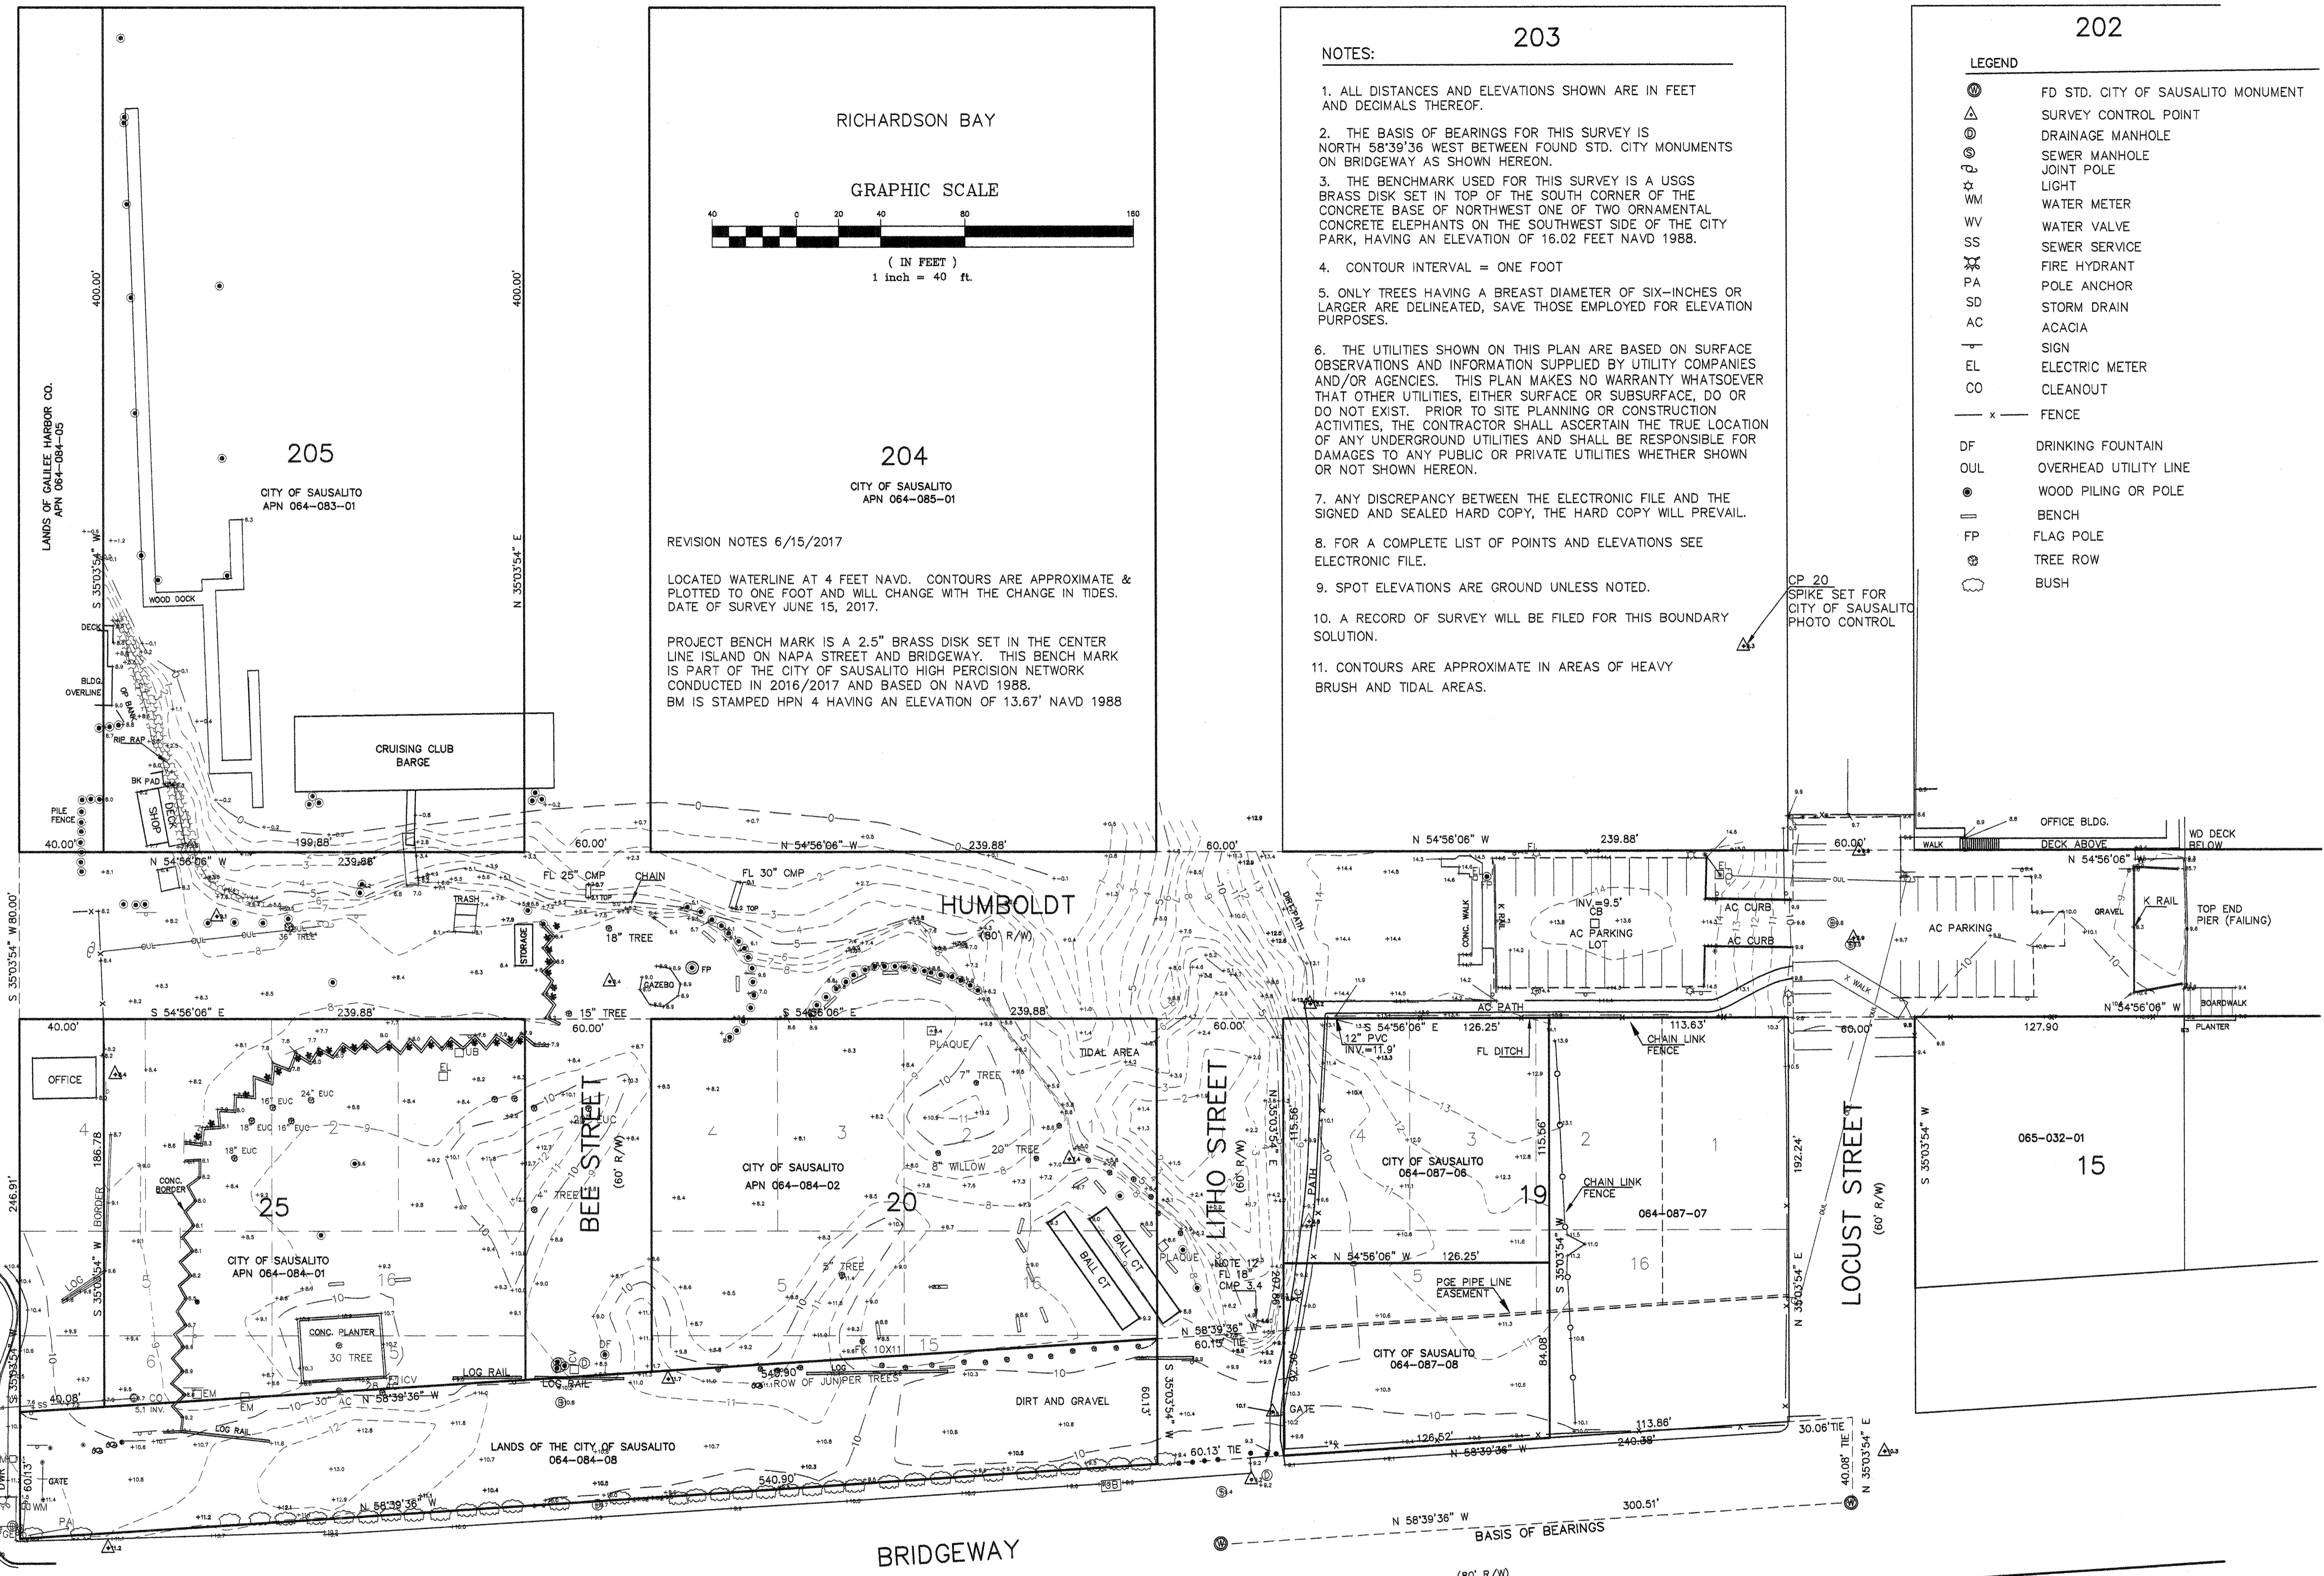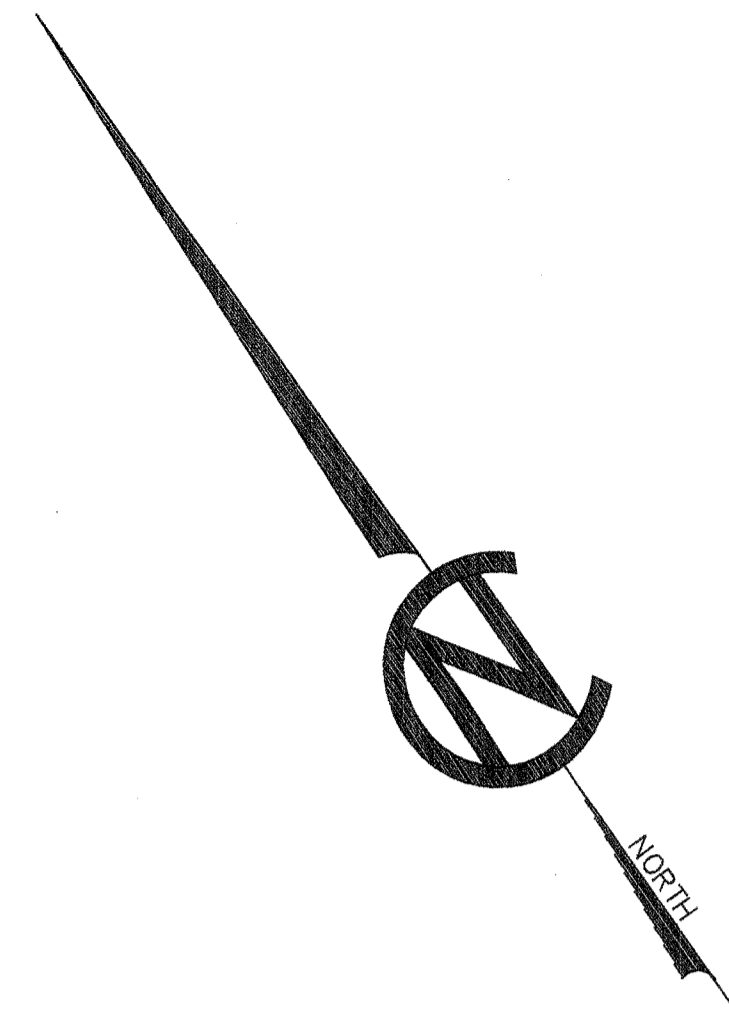

- NOTES:**
1. ALL DISTANCES AND ELEVATIONS SHOWN ARE IN FEET AND DECIMALS THEREOF.
  2. THE BASIS OF BEARINGS FOR THIS SURVEY IS NORTH 58°39'36" WEST BETWEEN FOUND STD. CITY MONUMENTS ON BRIDGEWAY AS SHOWN HEREON.
  3. THE BENCHMARK USED FOR THIS SURVEY IS A USGS BRASS DISK SET IN TOP OF THE SOUTH CORNER OF THE CONCRETE BASE OF NORTHWEST ONE OF TWO ORNAMENTAL CONCRETE ELEPHANTS ON THE SOUTHWEST SIDE OF THE CITY PARK, HAVING AN ELEVATION OF 16.02 FEET NAVD 1988.
  4. CONTOUR INTERVAL = ONE FOOT
  5. ONLY TREES HAVING A BREAST DIAMETER OF SIX-INCHES OR LARGER ARE DELINEATED, SAVE THOSE EMPLOYED FOR ELEVATION PURPOSES.
  6. THE UTILITIES SHOWN ON THIS PLAN ARE BASED ON SURFACE OBSERVATIONS AND INFORMATION SUPPLIED BY UTILITY COMPANIES AND/OR AGENCIES. THIS PLAN MAKES NO WARRANTY WHATSOEVER THAT OTHER UTILITIES, EITHER SURFACE OR SUBSURFACE, DO OR DO NOT EXIST. PRIOR TO SITE PLANNING OR CONSTRUCTION ACTIVITIES, THE CONTRACTOR SHALL ASCERTAIN THE TRUE LOCATION OF ANY UNDERGROUND UTILITIES AND SHALL BE RESPONSIBLE FOR DAMAGES TO ANY PUBLIC OR PRIVATE UTILITIES WHETHER SHOWN OR NOT SHOWN HEREON.
  7. ANY DISCREPANCY BETWEEN THE ELECTRONIC FILE AND THE SIGNED AND SEALED HARD COPY, THE HARD COPY WILL PREVAIL.
  8. FOR A COMPLETE LIST OF POINTS AND ELEVATIONS SEE ELECTRONIC FILE.
  9. SPOT ELEVATIONS ARE GROUND UNLESS NOTED.
  10. A RECORD OF SURVEY WILL BE FILED FOR THIS BOUNDARY SOLUTION.
  11. CONTOURS ARE APPROXIMATE IN AREAS OF HEAVY BRUSH AND TIDAL AREAS.

- LEGEND**
- ⊙ FD STD. CITY OF SAUSALITO MONUMENT
  - ⊙ SURVEY CONTROL POINT
  - ⊙ DRAINAGE MANHOLE
  - ⊙ SEWER MANHOLE
  - ⊙ JOINT POLE
  - ⊙ LIGHT
  - ⊙ WM WATER METER
  - ⊙ WV WATER VALVE
  - ⊙ SS SEWER SERVICE
  - ⊙ FHY FIRE HYDRANT
  - ⊙ PA POLE ANCHOR
  - ⊙ SD STORM DRAIN
  - ⊙ AC ACACIA
  - ⊙ SIGN
  - ⊙ EL ELECTRIC METER
  - ⊙ CO CLEANOUT
  - x — FENCE
  - ⊙ DF DRINKING FOUNTAIN
  - ⊙ OUL OVERHEAD UTILITY LINE
  - ⊙ WOOD PILING OR POLE
  - ⊙ BENCH
  - ⊙ FP FLAG POLE
  - ⊙ TREE ROW
  - ⊙ BUSH

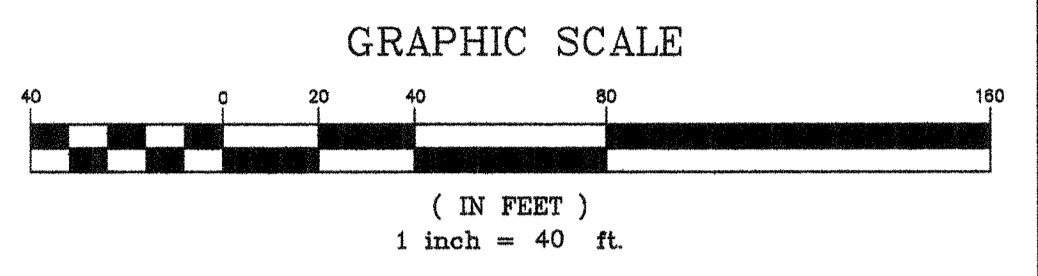

**204**  
CITY OF SAUSALITO  
APN 064-085-01

REVISION NOTES 6/15/2017

LOCATED WATERLINE AT 4 FEET NAVD. CONTOURS ARE APPROXIMATE & PLOTTED TO ONE FOOT AND WILL CHANGE WITH THE CHANGE IN TIDES. DATE OF SURVEY JUNE 15, 2017.

PROJECT BENCH MARK IS A 2.5" BRASS DISK SET IN THE CENTER LINE ISLAND ON NAPA STREET AND BRIDGEWAY. THIS BENCH MARK IS PART OF THE CITY OF SAUSALITO HIGH PRECISION NETWORK CONDUCTED IN 2016/2017 AND BASED ON NAVD 1988. BM IS STAMPED HPN 4 HAVING AN ELEVATION OF 13.67' NAVD 1988

**205**  
CITY OF SAUSALITO  
APN 064-083-01

LANDS OF GALLEY HARBOR CO.  
APN 064-084-05

WOOD DOCK

CRUISING CLUB BARGE

NAPA STREET

BEE STREET

LITHO STREET

LOCUST STREET

BRIDGEWAY



PREPARED BY:  
*Linda A. Carruthers*  
LINDA A. CARRUTHERS  
PLS 7053

6-17-17

PROJECT BM HPN 4  
ELEV. = 13.67 NAVD 1988

NO.	DATE	DESCRIPTION
7		
6		
5		
4		
3	6/15/17	LOCATE WATERLINE AT 4 FEET - SEE NOTE
2	12/09/13	ADD SEWER LOCATED BY CITY CREW
1	12/05/12	ADD CMP AT BEACH

LINDA A. CARRUTHERS & ASSOCIATES  
PROFESSIONAL LAND SURVEYORS  
3030 BRIDGEWAY, STE. 132, SAUSALITO, CA 94965  
(415) 332-3912  
www.lindacarruthers.com

**BOUNDARY AND TOPOGRAPHIC SURVEY**

**DUNPHY PARK AND VICINITY**

**CITY OF SAUSALITO**

ASSESSORS PARCEL NUMBERS  
064-084-01 & 02 & 08  
064-087-06 & 08  
064-083-01